
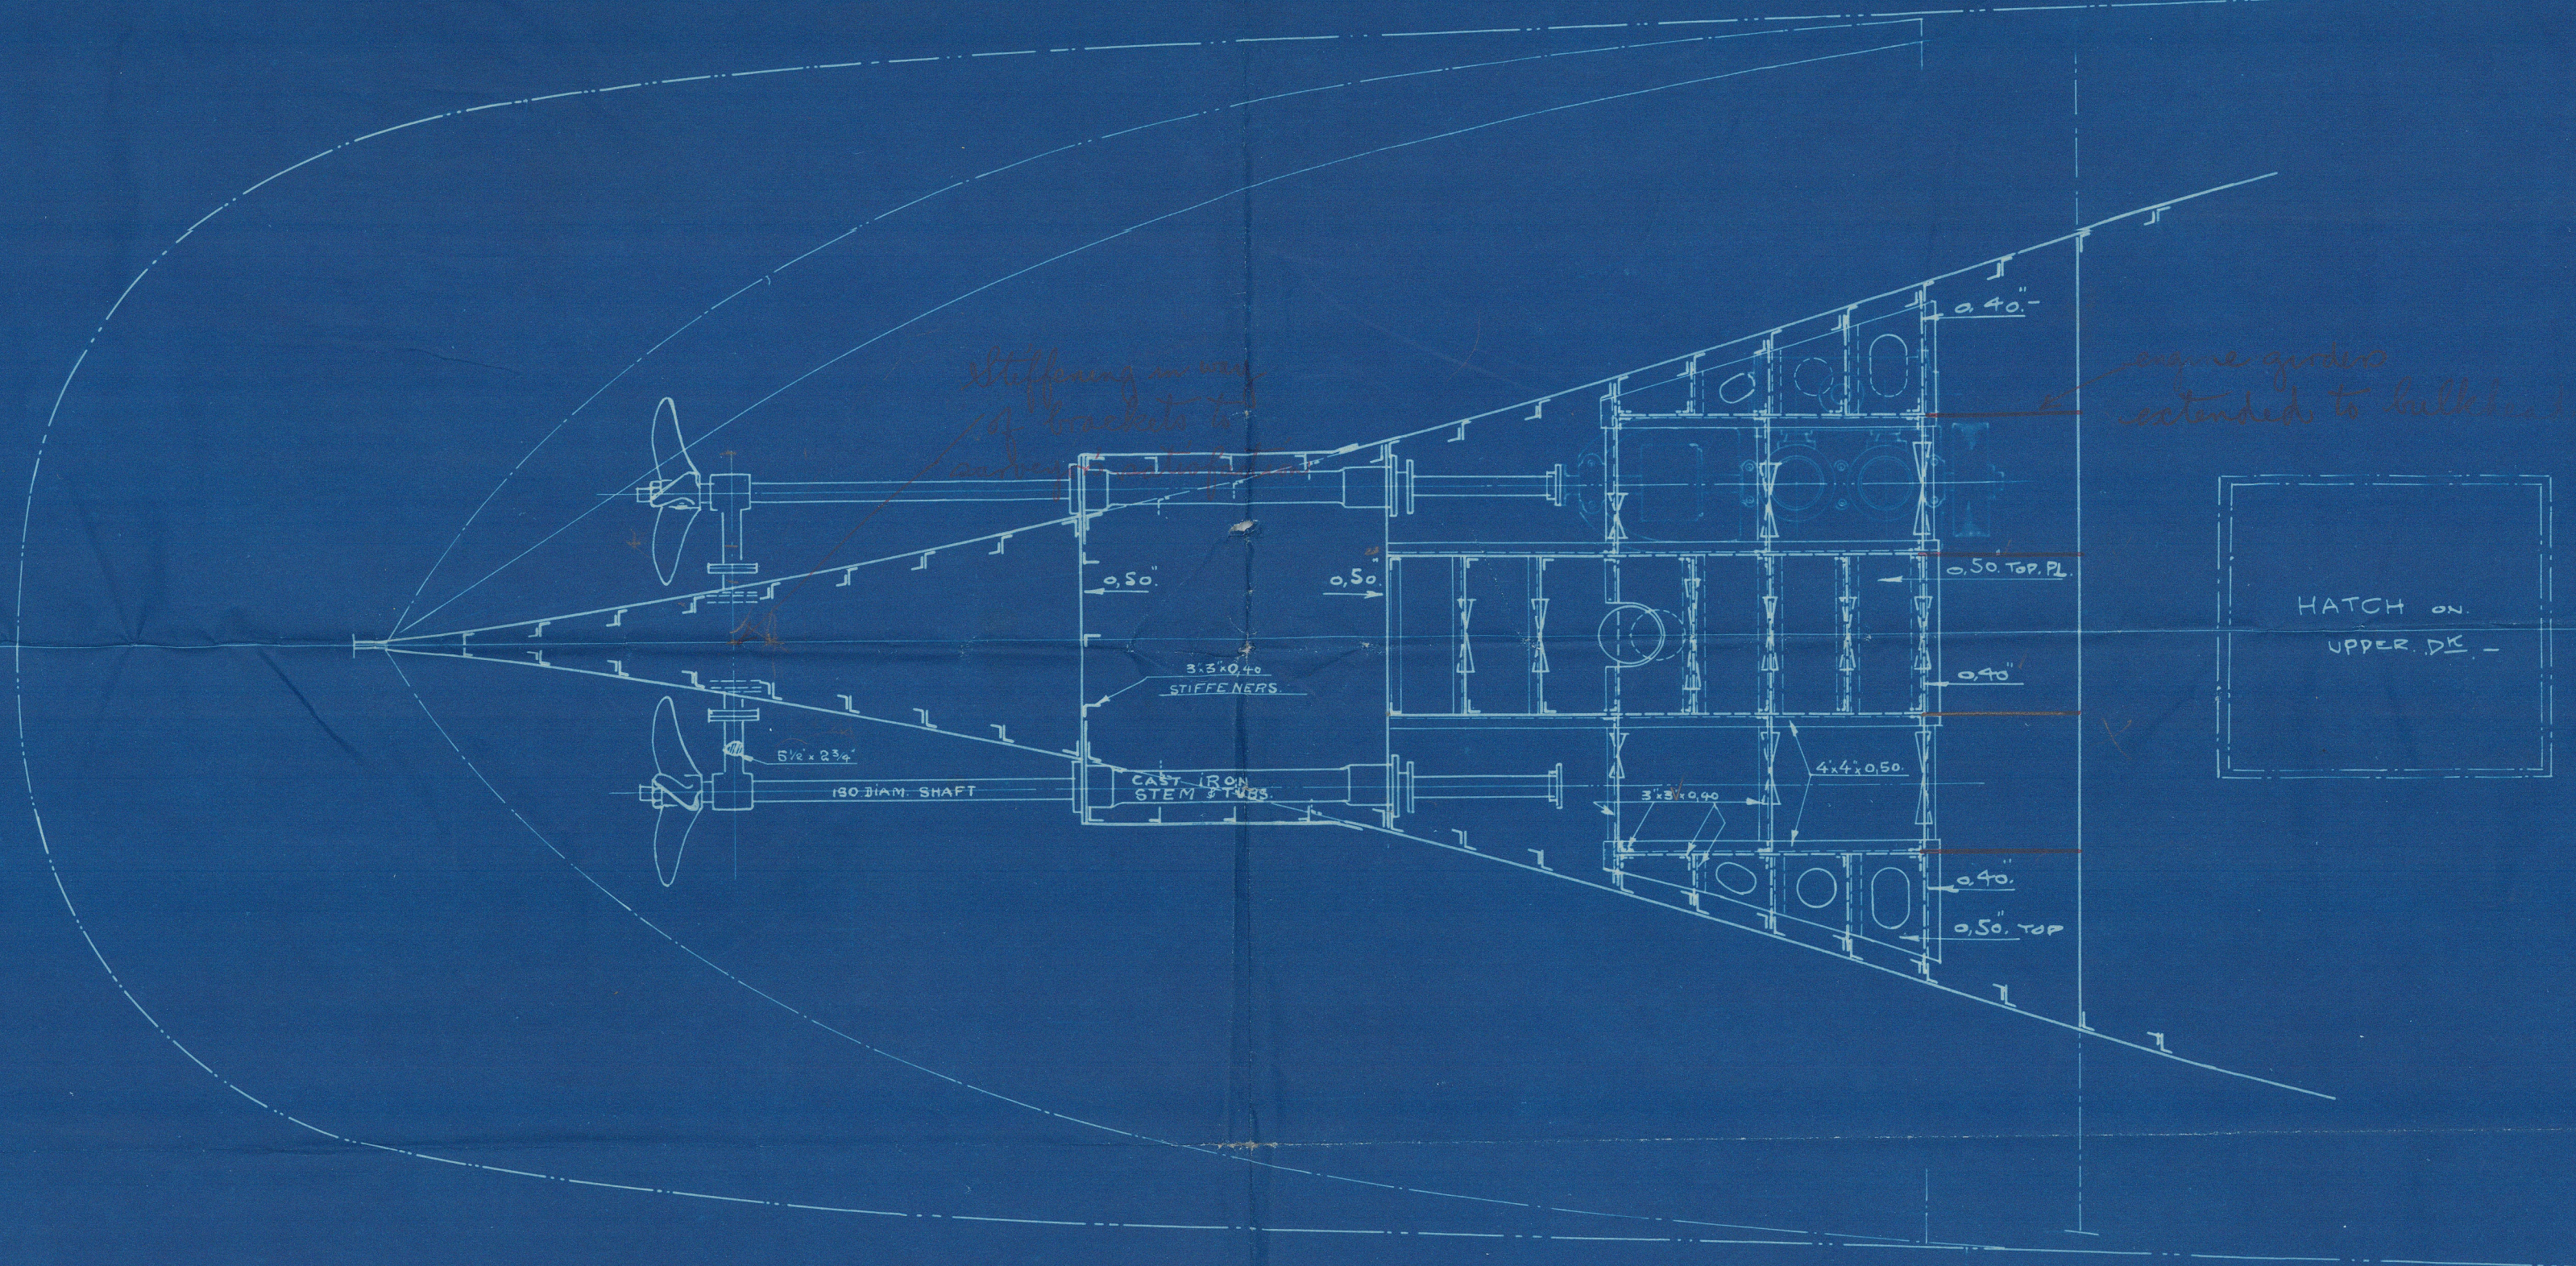
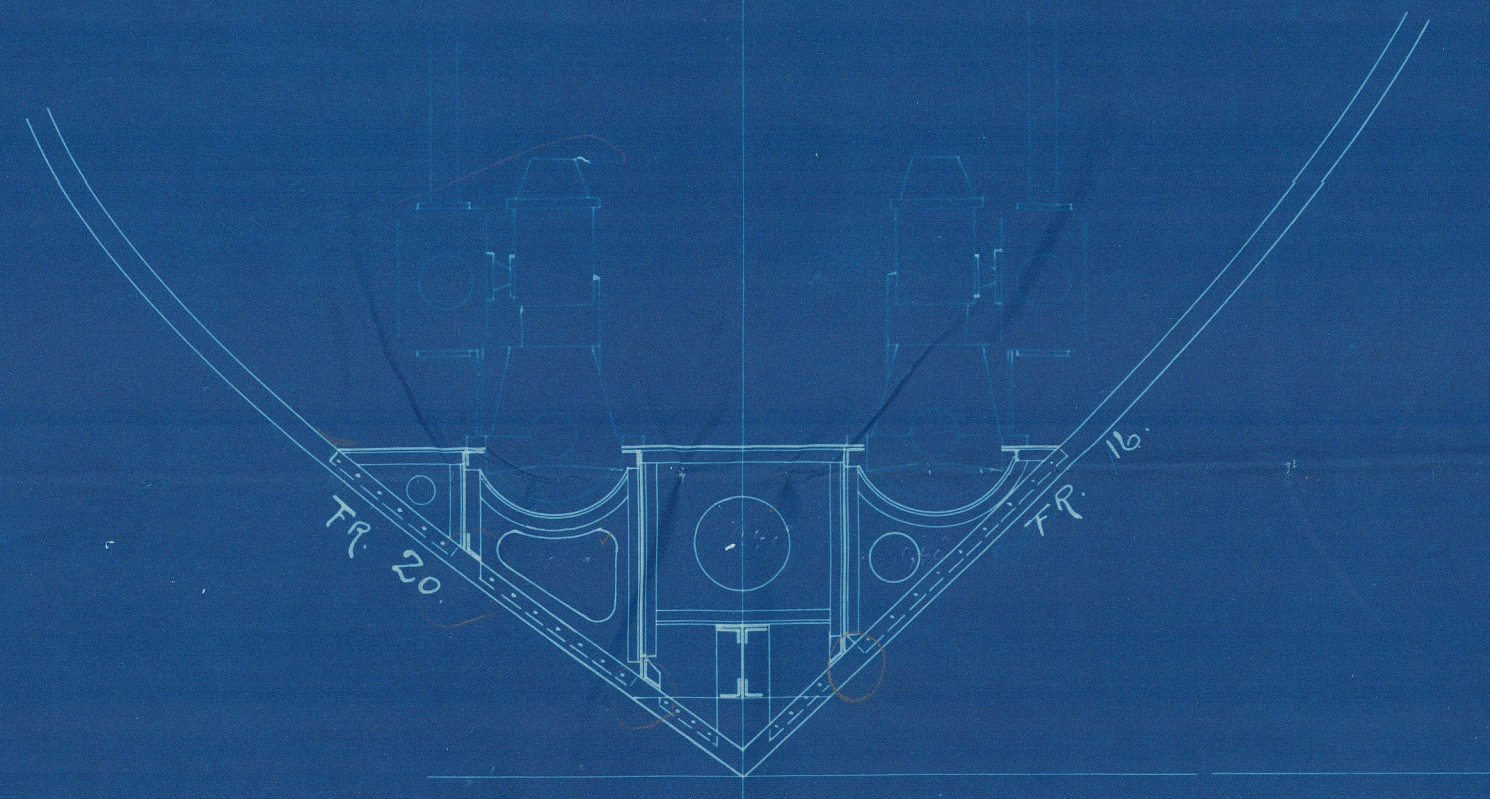


20.1.14

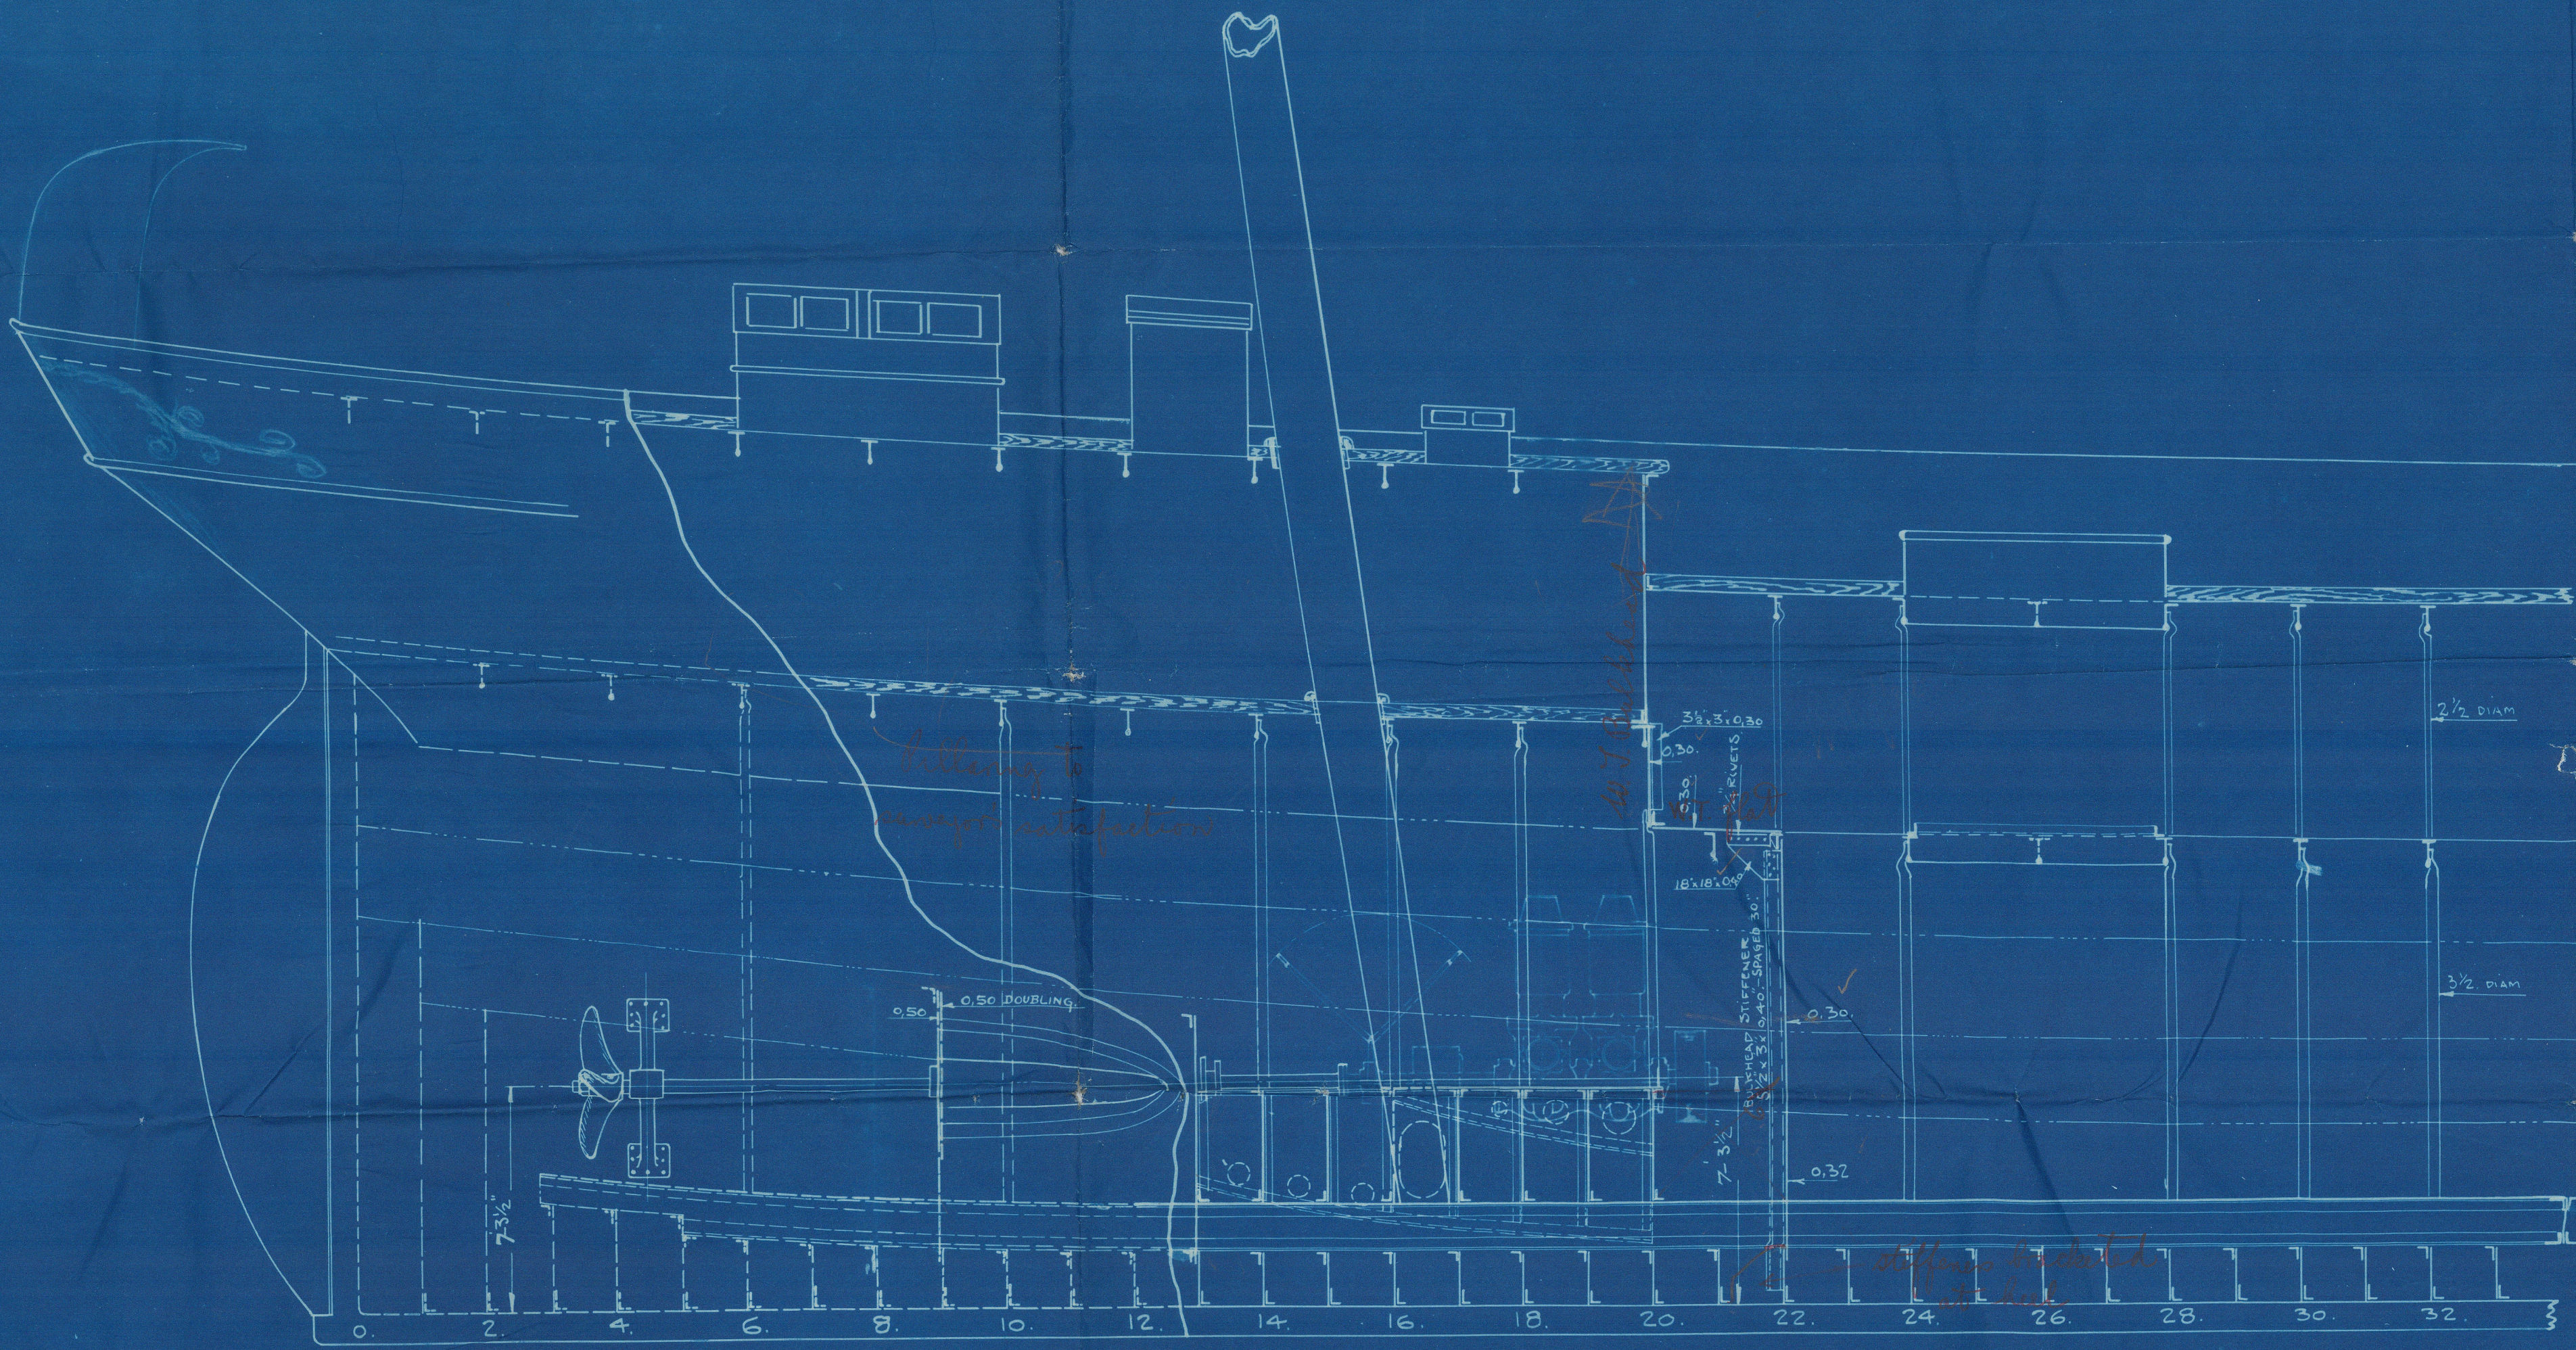

Skaalbark "Elflida"
Fundamentet for Maskiner.
Skala: 1/4" = 1 fod

Cf.
 19.1.15

Frømanden msk. Værktøjs
 Den 22-14
 Opt. Nr. 2212
 P. Sandberg

LR

W35884-0003

ELFLÉDA

20141477

Guard Brook Bot 5

W358B9 - 0008



8000

8000

King's

Handwritten signature



© 2021

Lloyd's Register
Foundation