
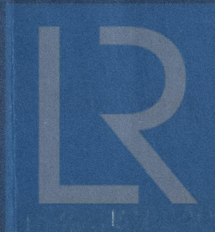


dimension 25"

9 i Brass

9/15

AXES FOR THE

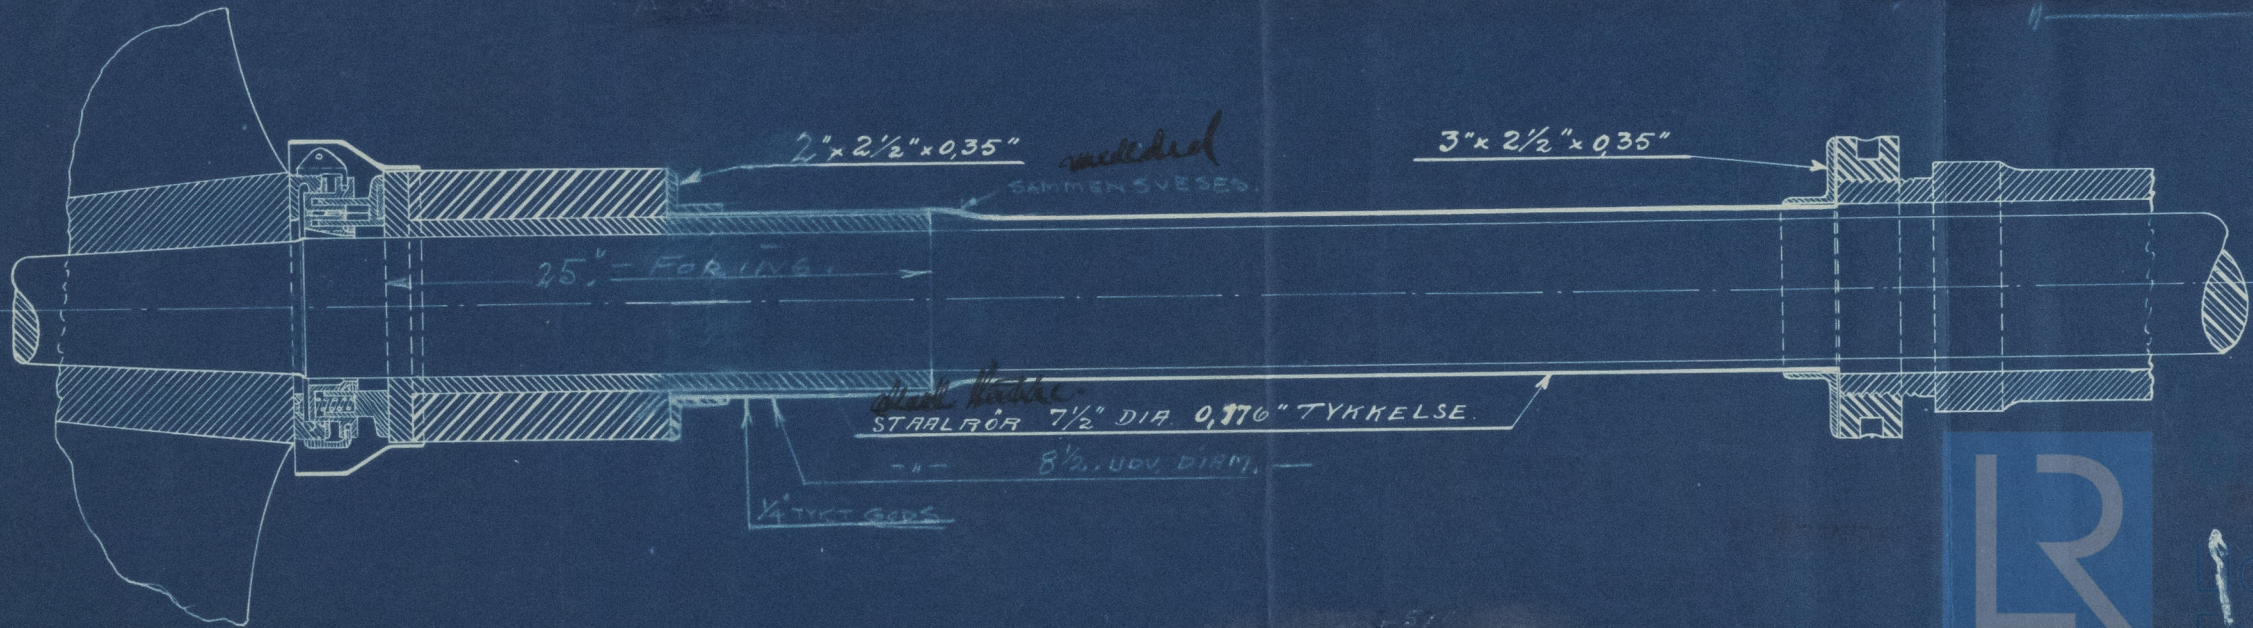

Lloyd's Register Foundation

W35889-0014

ELFLEDA.

Kia 1477

Guana Book Box 5



© 2021

Lloyd's Register  
Foundation