


Arrangement

25" foring i bunt.

Fingal
FB
S. FINGAL

ARRANGEMENT OF AXEL

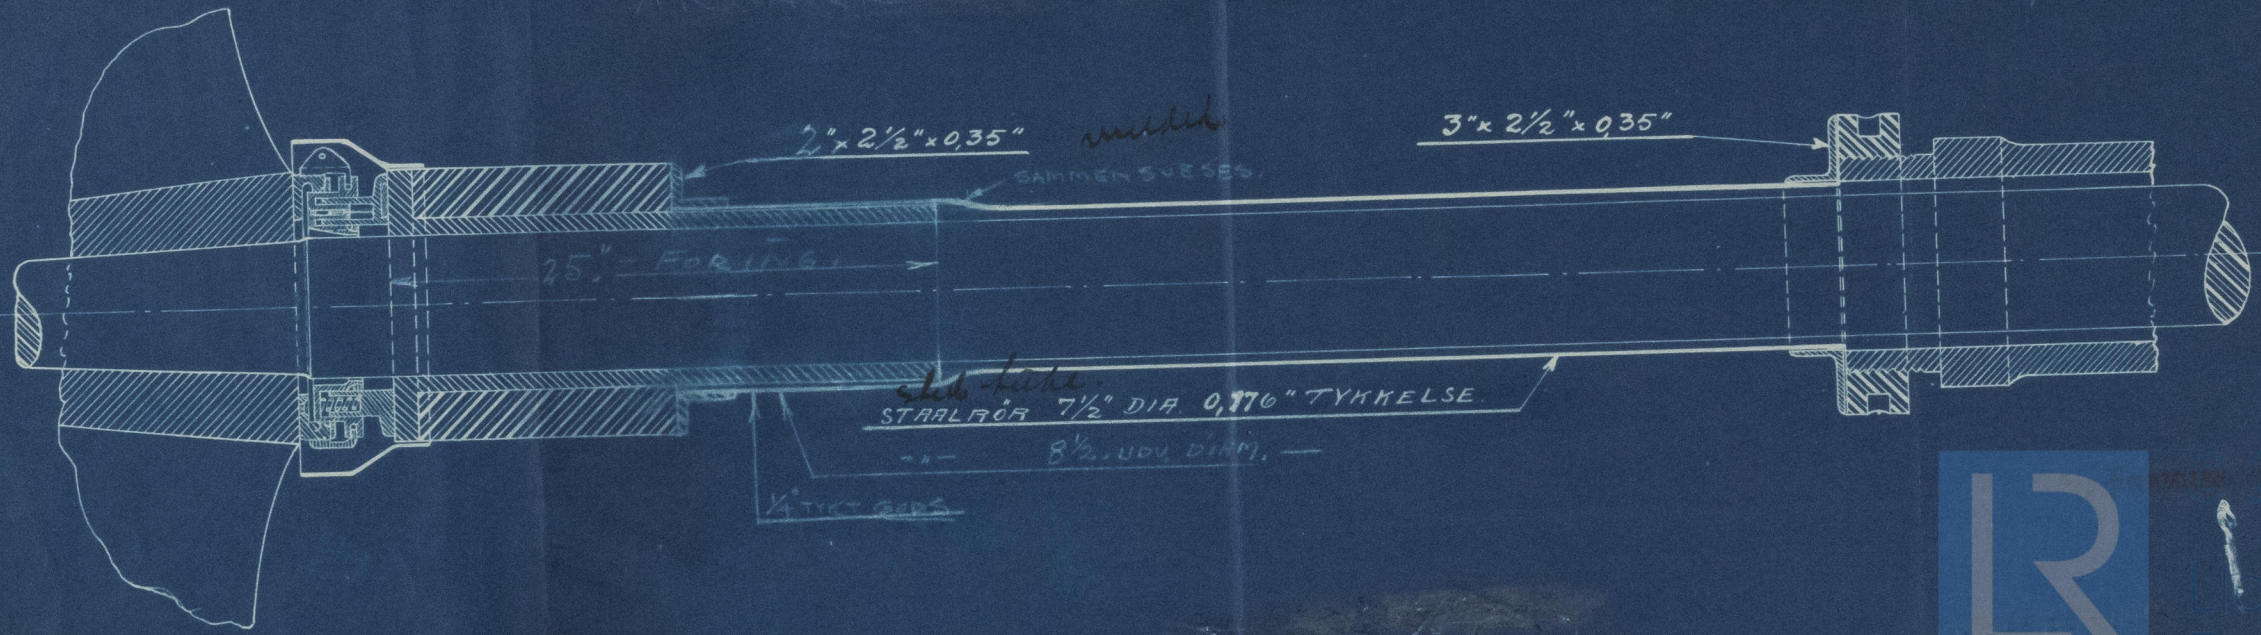

Lloyd's Register
Foundation

W358B9-0015

ELFLEDA

Xia 1477

Guard Book Box 5



© 2021

Lloyd's Register
Foundation