

Fig. 245
27.11.36


FIAT. STABILIMENTO GRANDI MOTORI.

MOTORE DL 646- M/N. TIPO "FELLA". (COSTRUZ. N. 2541- 2544)

COMPLESSIVO LINEA D'ASSI. scala 1:50

TAV. 4201

DIS. 96674

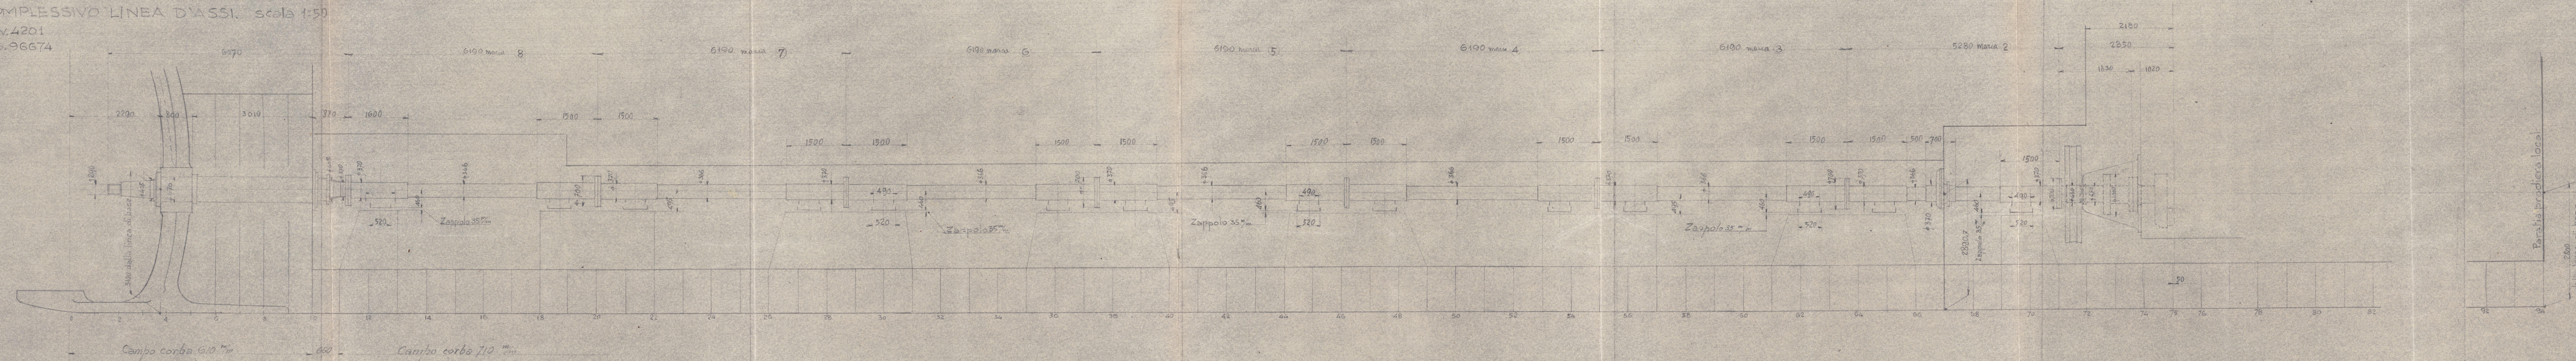

MP
21-1-36

MV. Zella Tri Rept.

No 11818-

also for.


MV. bellina

" Zeltre

" Rialto

X36-0126

93-1-18
JW

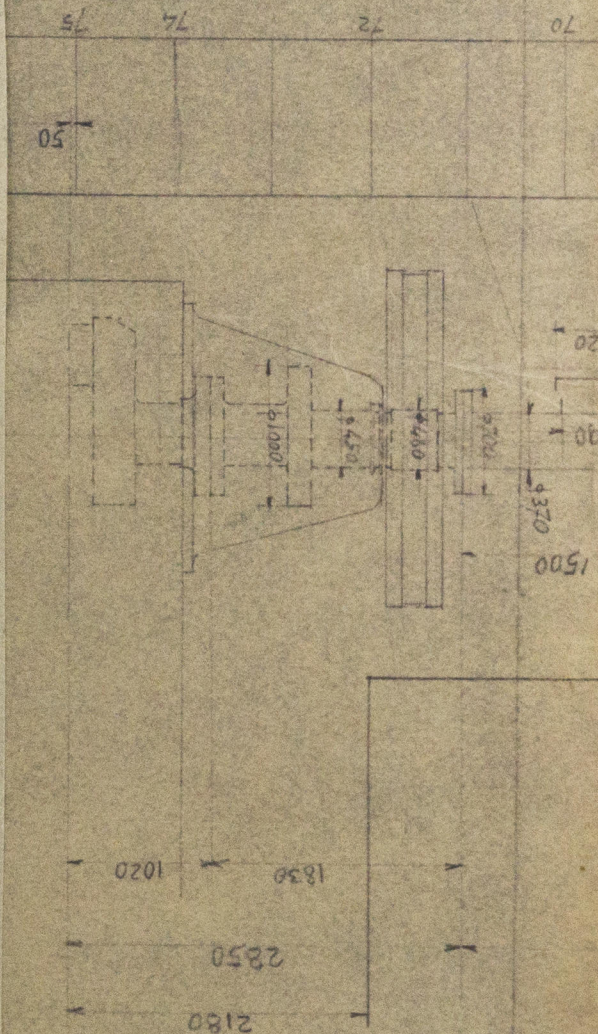

© 2020

Lloyd's Register
Foundation