


of 4" & 6" can be pumped up
 the total cross section of
 the air pipe to be not less
 than that of the respective filling pipes.
 Size of air pipe as per Rule
 as per Rule

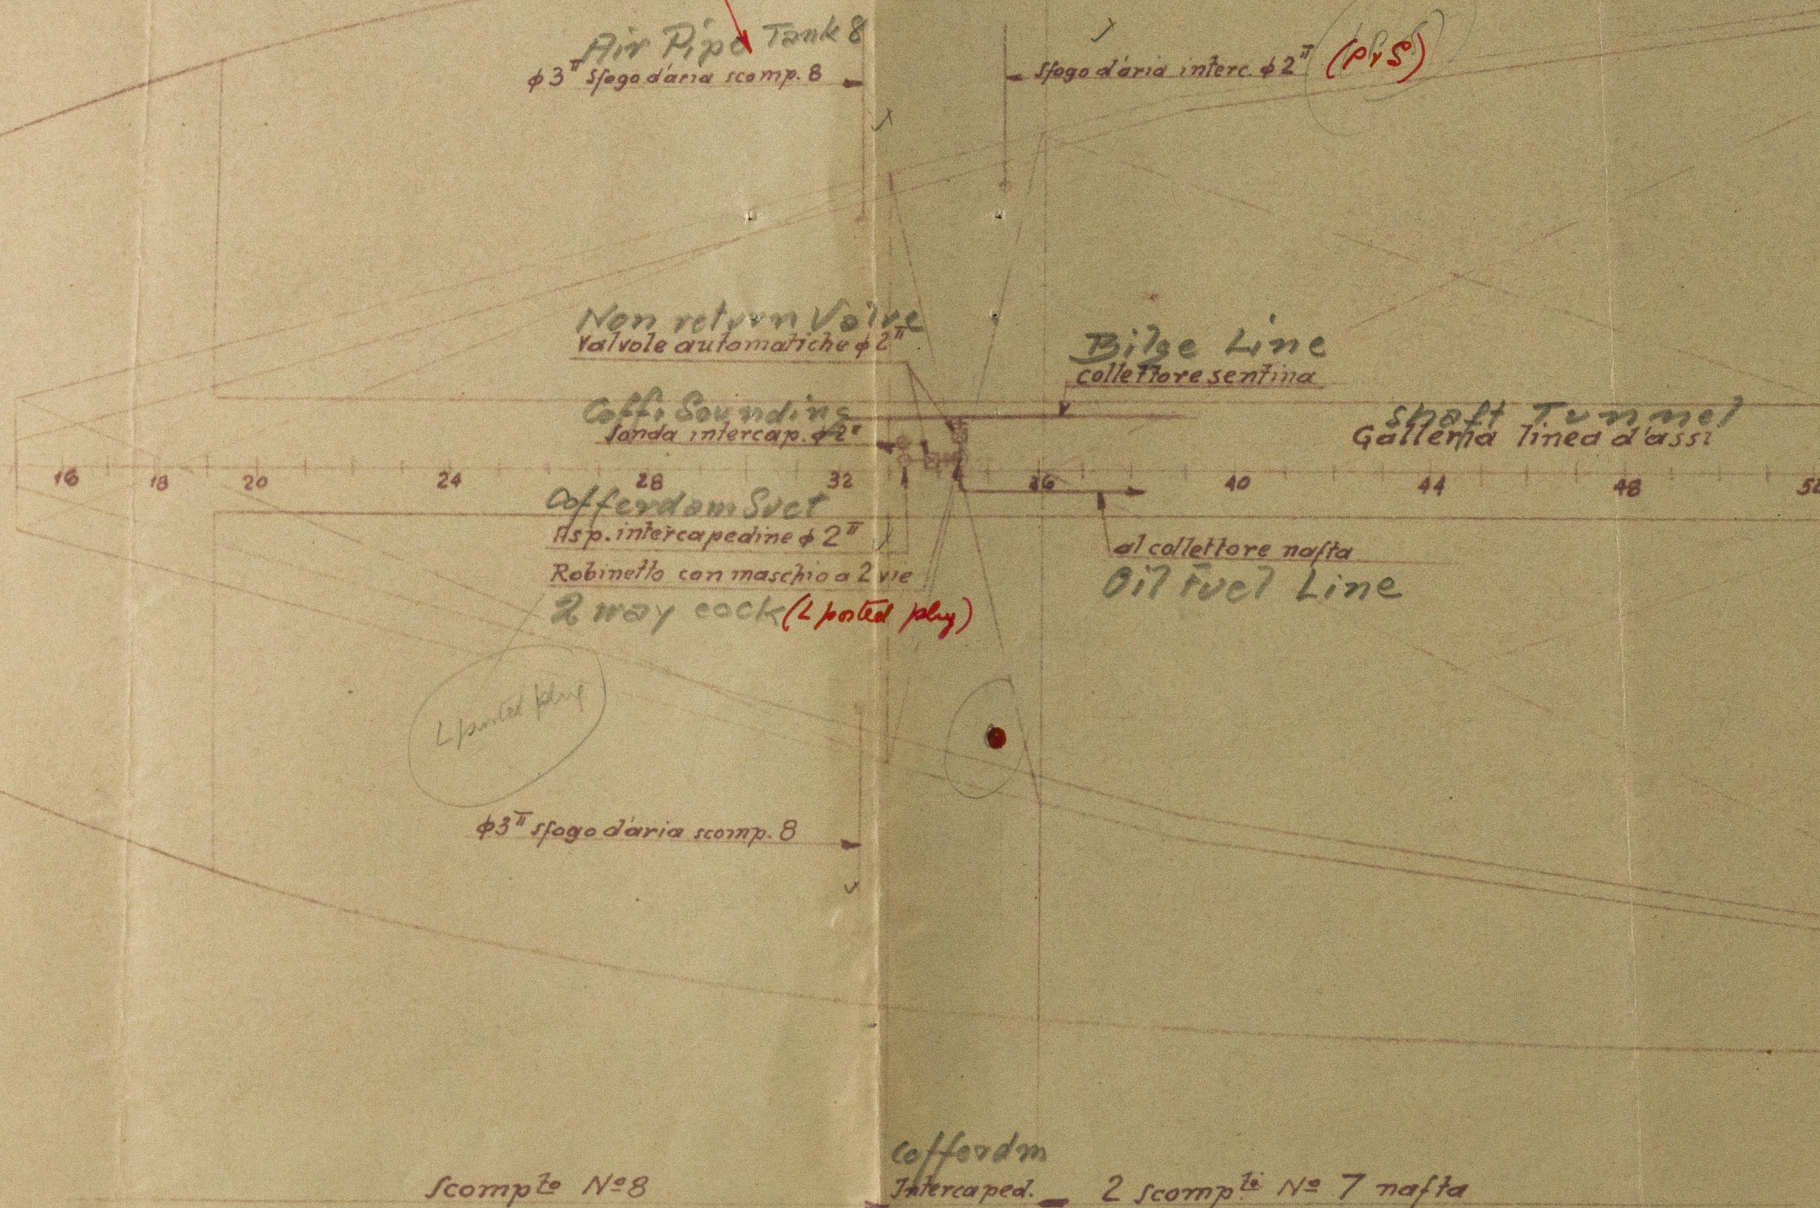

MV. Fella Tri Rept No 11818

LONDON COPY.

also for
 MV. Cellina
 Feltre
 Rialto

The flash point of the oil fuel to be above 150°F. and
 the remaining requirements of Section 20 of the Rules
 1936-6 to be complied with so far as they are applicable.

The remaining requirements of section 34
 of the rules 1936-6 to be complied with so
 far as they are applicable.

Copy for London Office
 29/2/36.

1936	Data	Nome	CANTIERE MONFALCONE SEZIONE MARINA MERCANTILE UFFICIO TECNICO - GRUPPO MECCANICO Il Direttore Tecnico:	
Disegnato	14-VII-			
Controlato				
Costo. somm.				
Approvato				
Scala:	Gruppo:	Repertorio:	Costr:	
1:100				
	Motonavi "Fella" - "Cellina"			NLT 86
	Schema aspiraz. nuova intercapedine ord. 33-36			
No. Aut. 11818	Sostituito da: Sostituito da:			

© 2020
 Lloyd's Register
 Foundation
 W 36-0132