


# FIRT - STABILIMENTO GRANDI MOTORI

TAV. N. 4209 DIS. N. 95774 Scala 1/10-1/2 Mater. ACC Mod. N.

LINEA D'ASSI - TRONCHI INTERMEDII

MARCHE --- (3) - (4) - (5) - (6) - (7) - (8)

MOTORE TIPO	Quantità
DL 646	
M.V. TIPO FELLA 6	

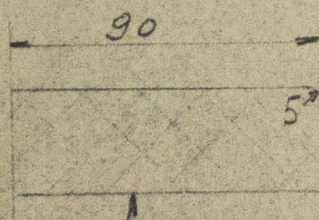

M.V. Fella Tri rept No 11818.

also for

M.V. bellina

" Feltre


" Rialto

W36-0142

2110-95X

N

0/500

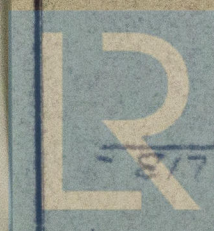

© 2020

876

Lloyd's Register  
Foundation



DATA 77-70-793

7500

14

00400

46

90

0. 34. 0

99E.6

6366

6130

- COLLAUDO R. I. - E. L. R.

NR  
21-1-36

$$R = 44 \div 50 \text{ Kg } \frac{\text{m}}{\text{m}^2}$$

$A = 29 \div 25\%$  SUBARRETE  $L = 42 - P - U R 1$    2020

$A = 29 \div 25\% = 116$  NORMALI DEL

L.R. 2020  
 L.R. Lloyd's Register  
 Foundation  
 W56-0142