


PONTE CORRIDOIO.

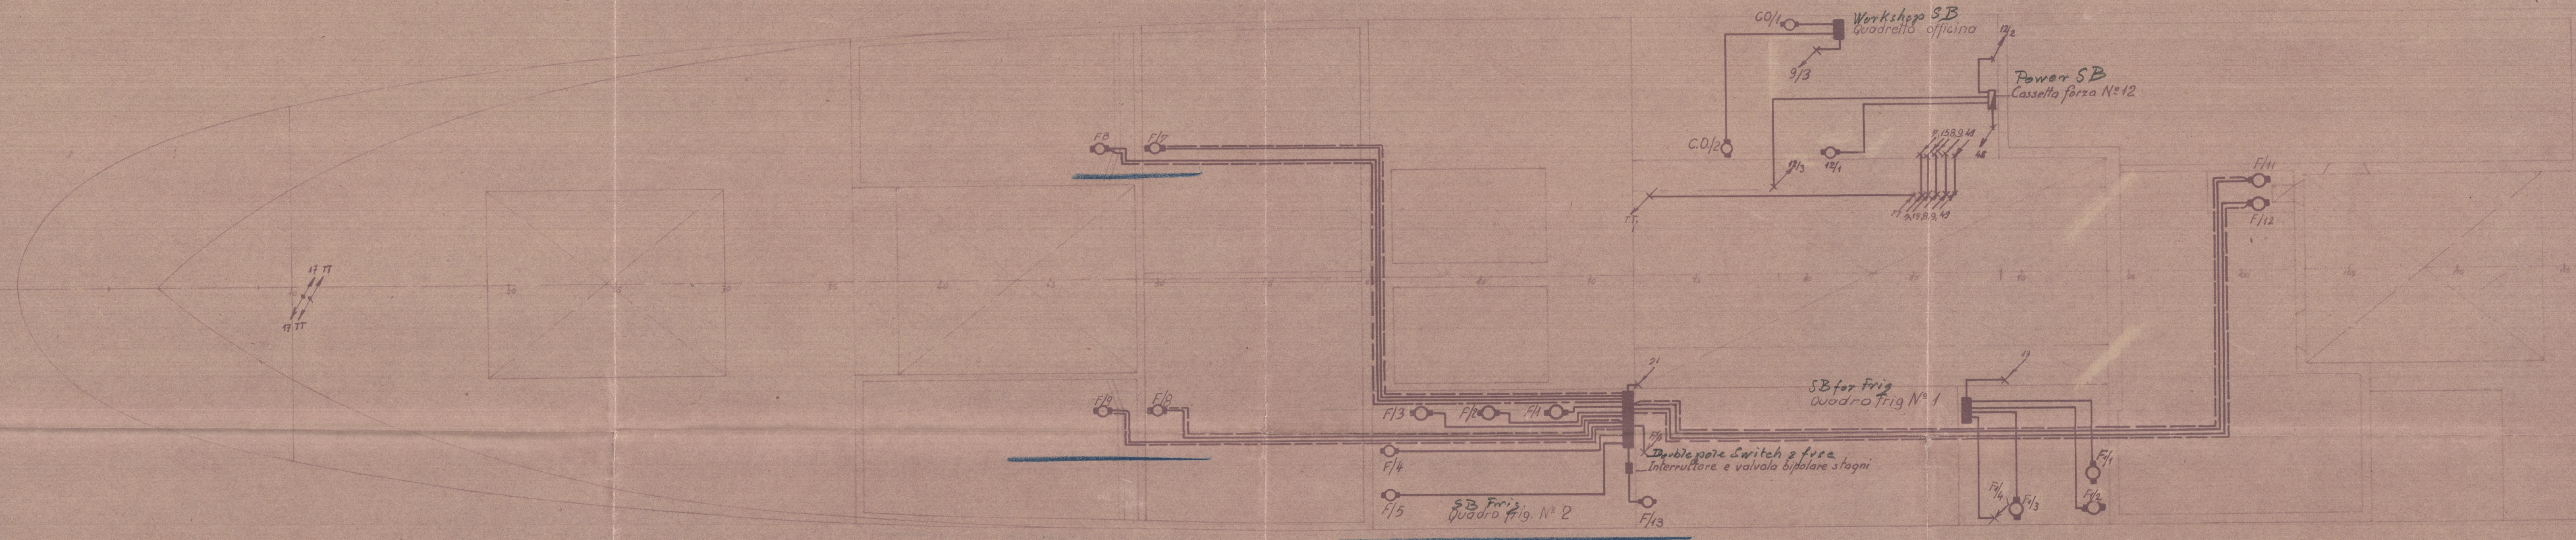

Subdivision of Circuits
to be in accordance with
Section 7 Clause 1.

Control of Circuits
to be in accordance with
Section 7 Clause 2 (a).

Sectional Areas of Cables
to be in accordance with
Section 4 and Tables 1 & 3.

MV. Zella Tri. Rept. N°1818
also for
MV. Cellina
" Zella
" Scallo

Servizi aggiunti
New Circuits

gag
5.10.37

Copy for London Office

10-9 D. Sargo
Lisini
Ing. Schiavi

1:100 SCHEMA IMPIANTO
FORZA COPERTA



M/N CELLINA
NLT/17
Foundation
1236-0146

STIVA.

