


Cassella luce N°2A-110V Cir. 32/5

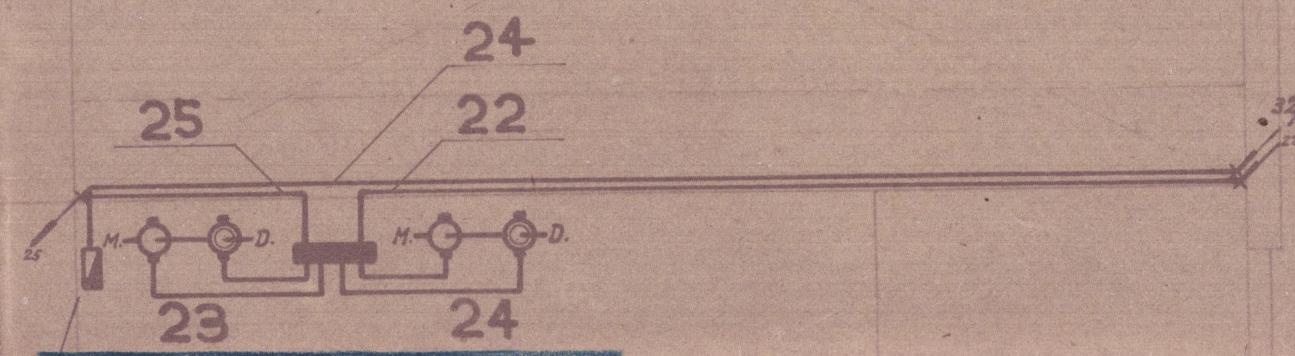

Light Aux. S.B.  
Quadrette luce N°2-220V

Light Aux. S.B.  
Quadrette luce N°2-110V

STIVA

Pannello luce 110V.  
Light Panel

Main S.B.  
Quadra principale  
Circuit breaker and double pole fuse  
Interruttore a valvola bipolare  
Cir. N° 50

Servizi aggiunti

M.V. Tella Tri Regt No 11818

also for  
M.V. Tellina  
Tella  
Mello

Control of Circuits  
to be in accordance with  
Section 7 Clause 2 (a).

Sectional Areas of Cables  
to be in accordance with  
Section 4 and Tables 1 & 2.

Subdivision of Circuits  
to be in accordance with  
Section 7 Clause 1.

8-8  
5-10-37

Copy for London Office

1937-XV  
9-9 G. Sarg  
Lisini  
ing. Schiavi

1:100 ALIMENTI LUCE-TELEFON

INCELLINA  
L.N.L.T. Register  
Foundation.

1236-0147