

London

M.V. Zella Zni Rept No 11818.

Also for

M.V. bellina

" Zella

" Rialto

W36-0149




© 2020

Lloyd's Register
Foundation

m/n Feltre, Rialto,Fella, Cellina.Telaio di poppa e timoneScala 1:25Dati

Lunghezza	131,06 m.
Larghezza	16,84 "
Immersione	7,62 m
Velocità	13,5 nodi
Area timone	19,2 m ²
Max. angolo	30°

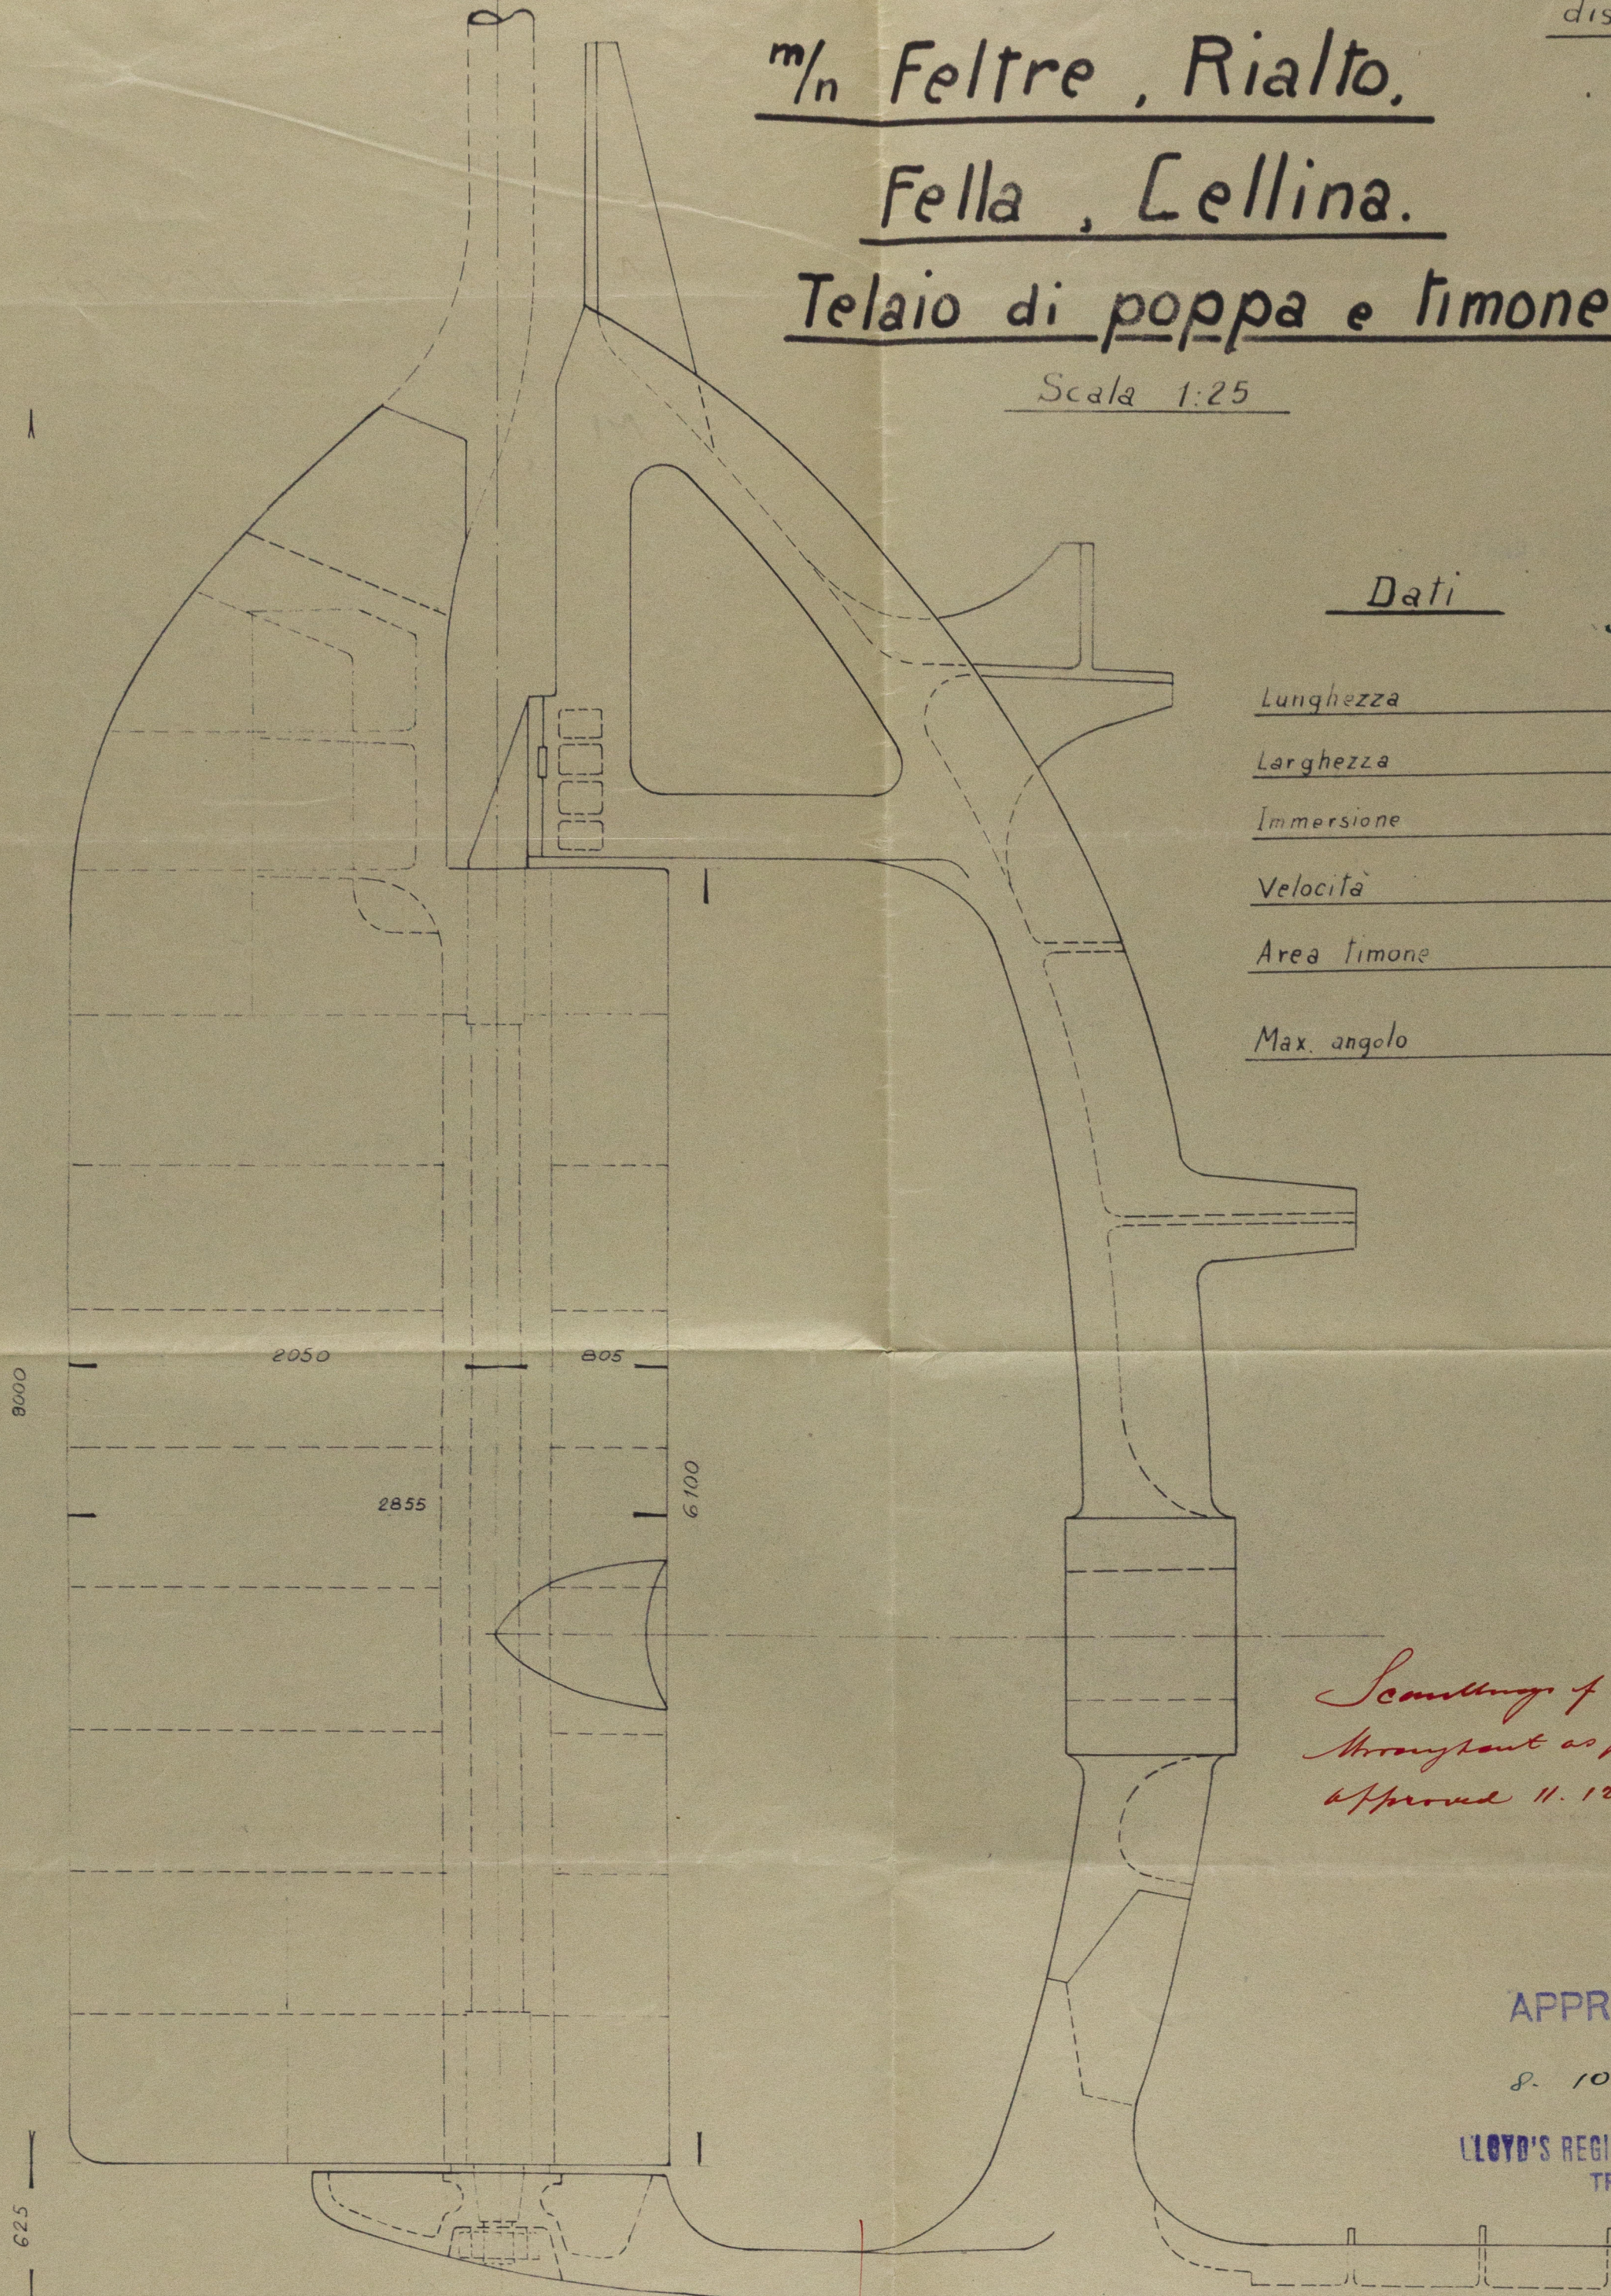

*Scantlings of stern frame
throughout as per plan
approved 11. 12. 35*

APPROVATO

8. 10. 1936

LLOYD'S REGISTER OF SHIPPING
TRIESTE

Side piece at this point may be 400 in wide.

C.R.D.A. - Cantiere di Monfalcone

6/10/36/

XIVa

© 2020

Lloyd's Register
Foundation

W 36 - 0149