

Mr  
27.11.99

Bygning No 210

$\frac{3}{4}$ " double plate

Scale 1" = 1 Foot - Engl. Measure.

224-11-1877

$\frac{3}{4}$ " plate

$\frac{13}{16}$ " plate



25/11/99

F. Kuch

Actieselskabet  
Burmeister & Wains Maskin- og Skibsbyggeri,  
Kjøbenhavn.

25-11-99

Reinh.

Mr  
27.11.99



W360B2-0001

© 2021  
Lloyd's Register  
Foundation




22-11-40



*to London*

*Compensation plates, and  
Back End of Boilers.  
Burmester & Wain's  
S/S Yard No 210.*

W360B2-0001

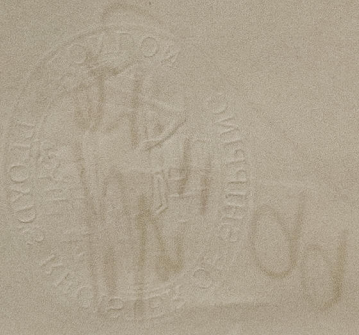

© 2021  
Lloyd's Register  
Foundation