


© 2021 Lloyd's Register Foundation

Burnmeister Waie

$\frac{8}{8}$ N^o 210.

Approved $\frac{13 \times 26}{10} = 98$



profile plan.

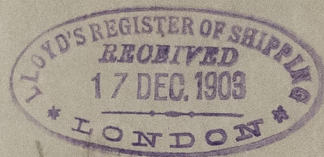



Approved Profile plan

Burns S^o N^o 210

W360B2 - 0004

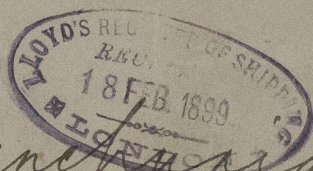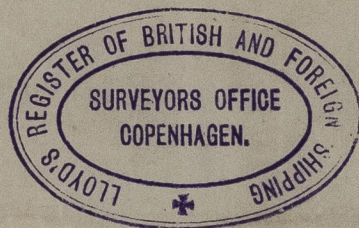

H. Brantner
Chw 1324.

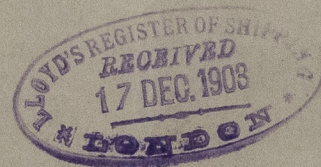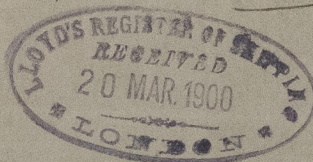

13 x 26 / 10 = 98



© 2021

Lloyd's Register
Foundation