


ACTIESELSKABET
BURMEISTER & WAIN
MASKIN- & SKIBSBYGGERI
KJØBENHAVN.

LITR. S No. 1517.

19. 11. 98.
22. 7. 99

S. S. N^o 210

PLAN OF POOPDECK.
 $\frac{1}{8}'' = 1'$

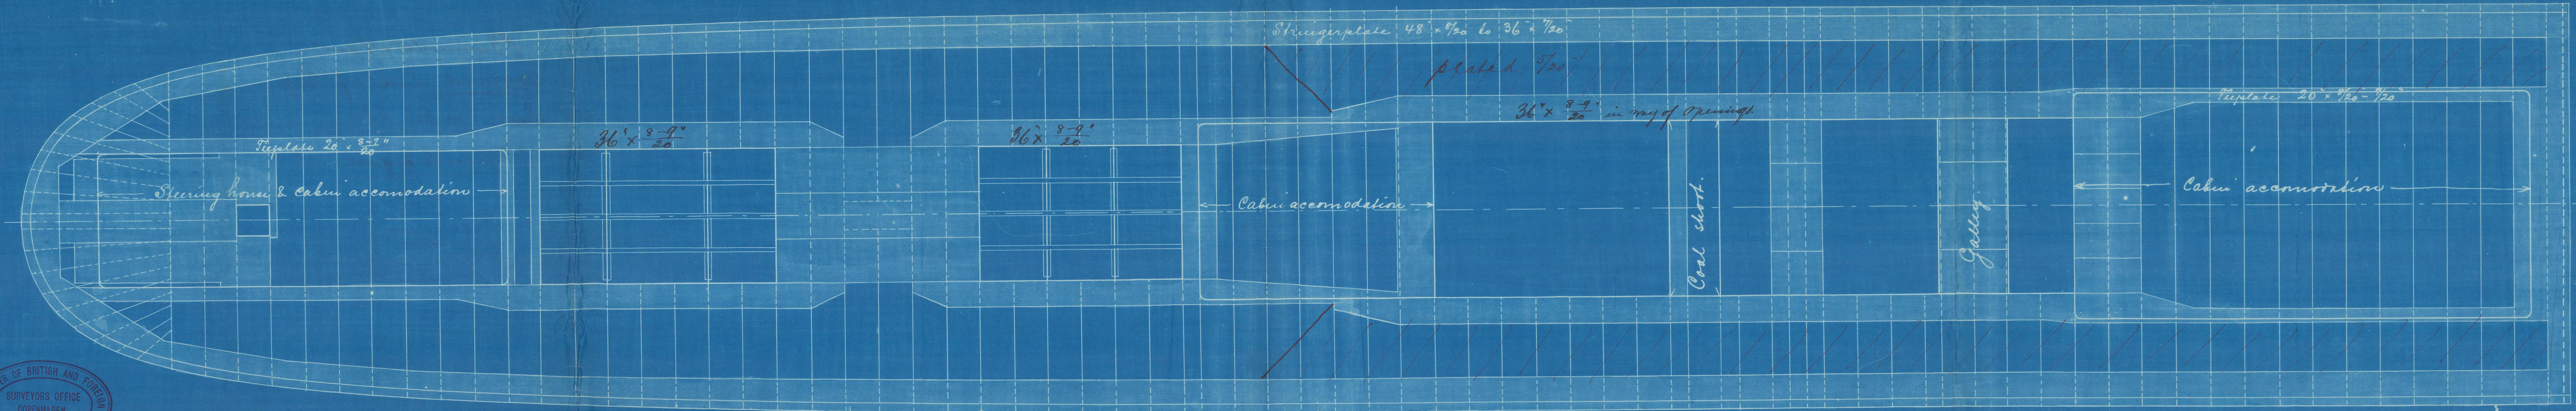

REGISTER OF BRITISH AND FOREIGN
SURVEYORS OFFICE
COPENHAGEN.
LLOYD'S
14th 98.


ACTIESELSKABET
BURMEISTER & WAIN MASKIN- OG SKIBSBYGGERI.
11/12-98 Patent.
W36692



© 2021
Lloyd's Register
Foundation


Plan of Poop deck
B. W. S. 1/5 No 210

18/11. 98

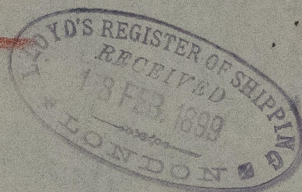


W360B2 - 0006

Burmeister & Wain
Approved plan of Poop
Deck 8/5 No 210
Copenhagen

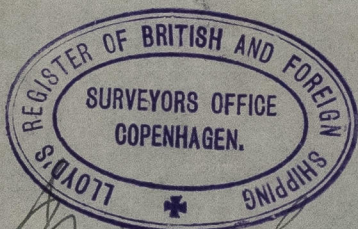

A. Manchuria
Cpn 1394

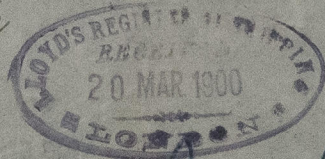

Guard Book
Bot



© 2021

Lloyd's Register
Foundation