
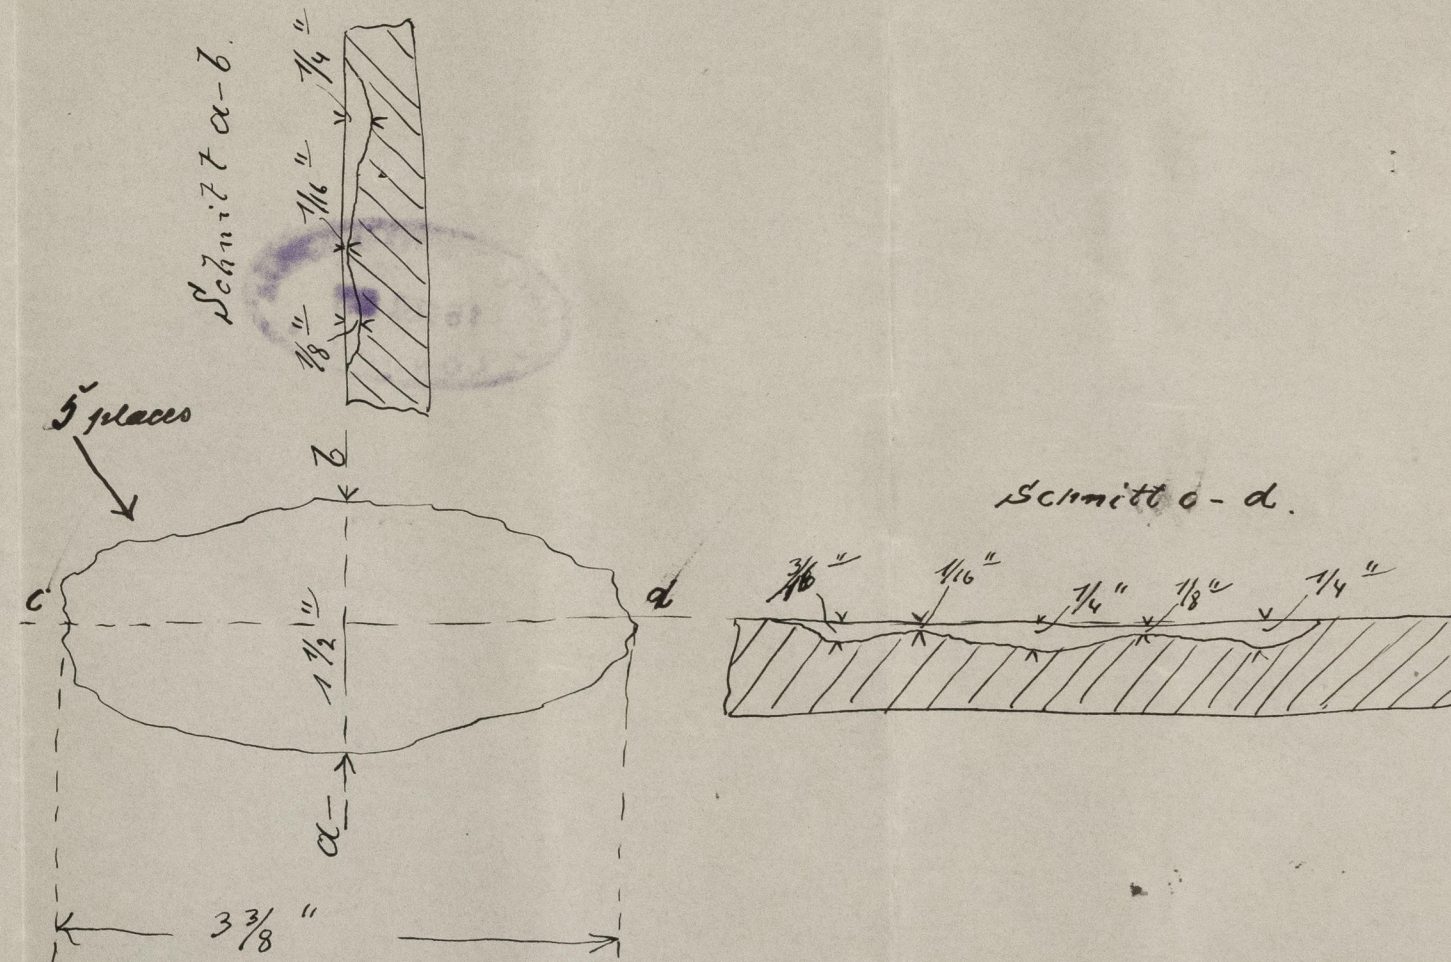
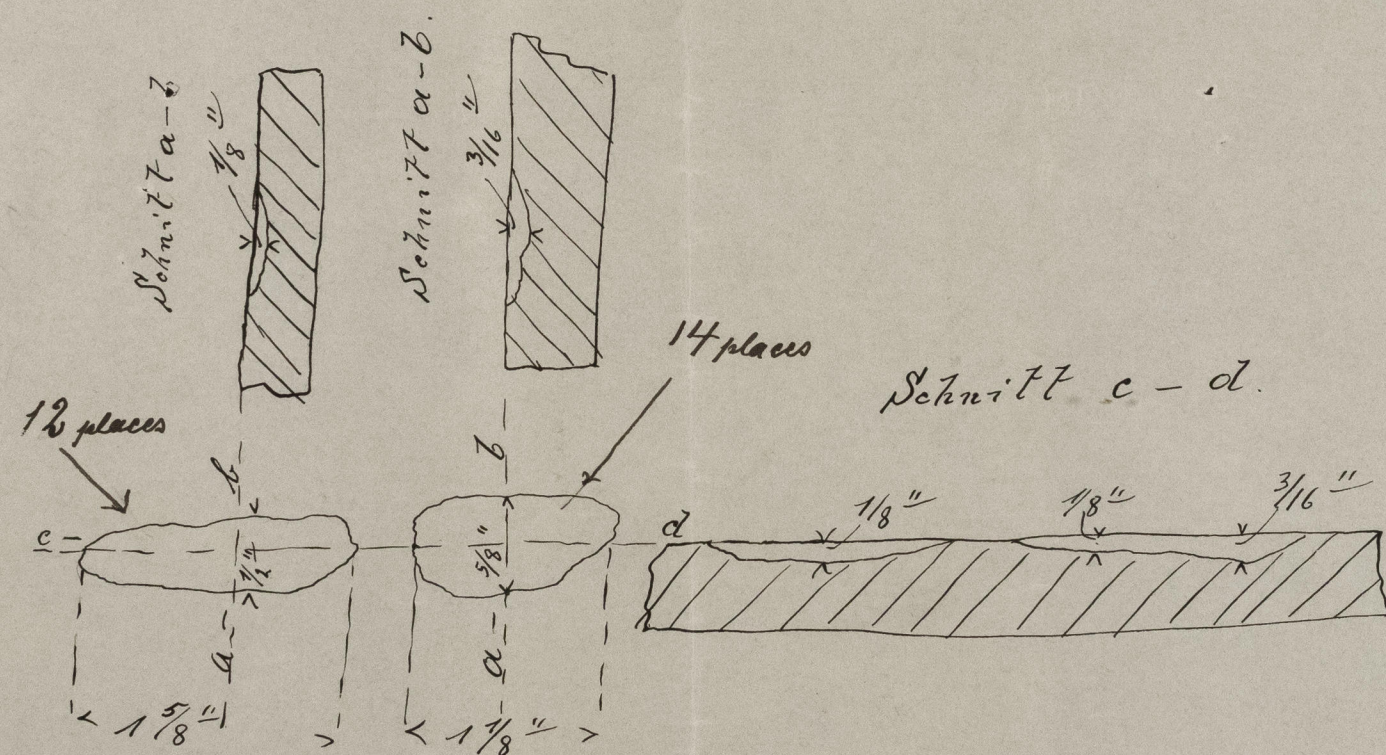



S.I. Kometa: ^{Corrosion on the inner surface of the outside plating}
Anfressungen an der inneren Fläche der Außenhautbeplattung.

1:1.

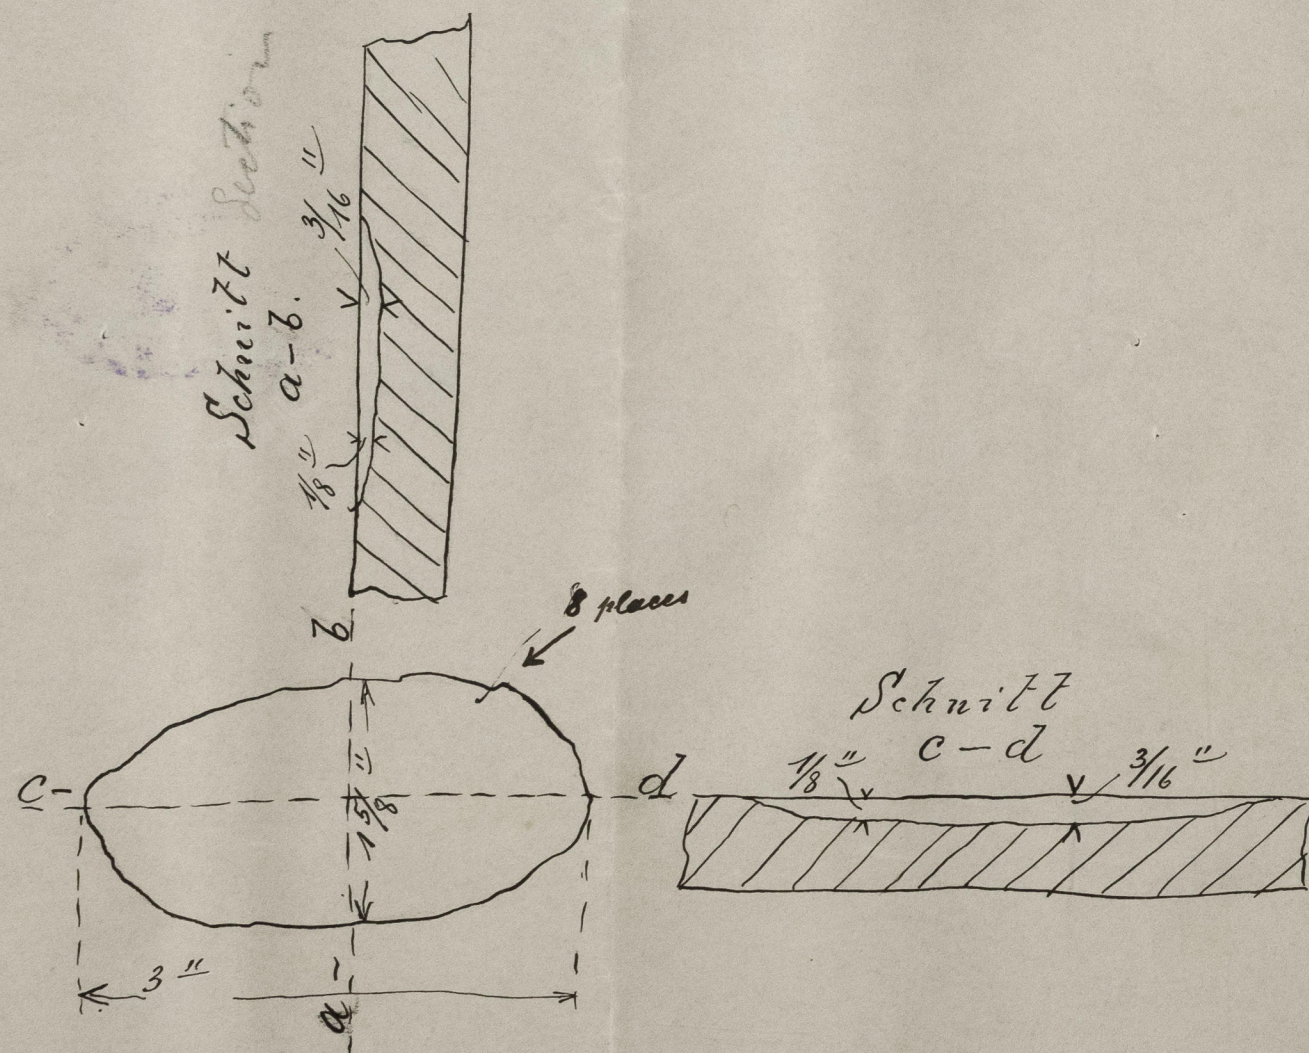

KOMETA Comorian
Dmy 287 Plans
Guard Book Bot 8

W362B15-0014

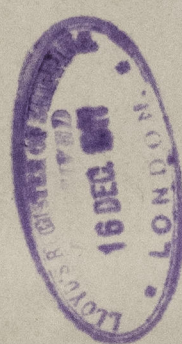

W362B15-0014



© 2021

Lloyd's Register
Foundation