


Bk "Galathée"

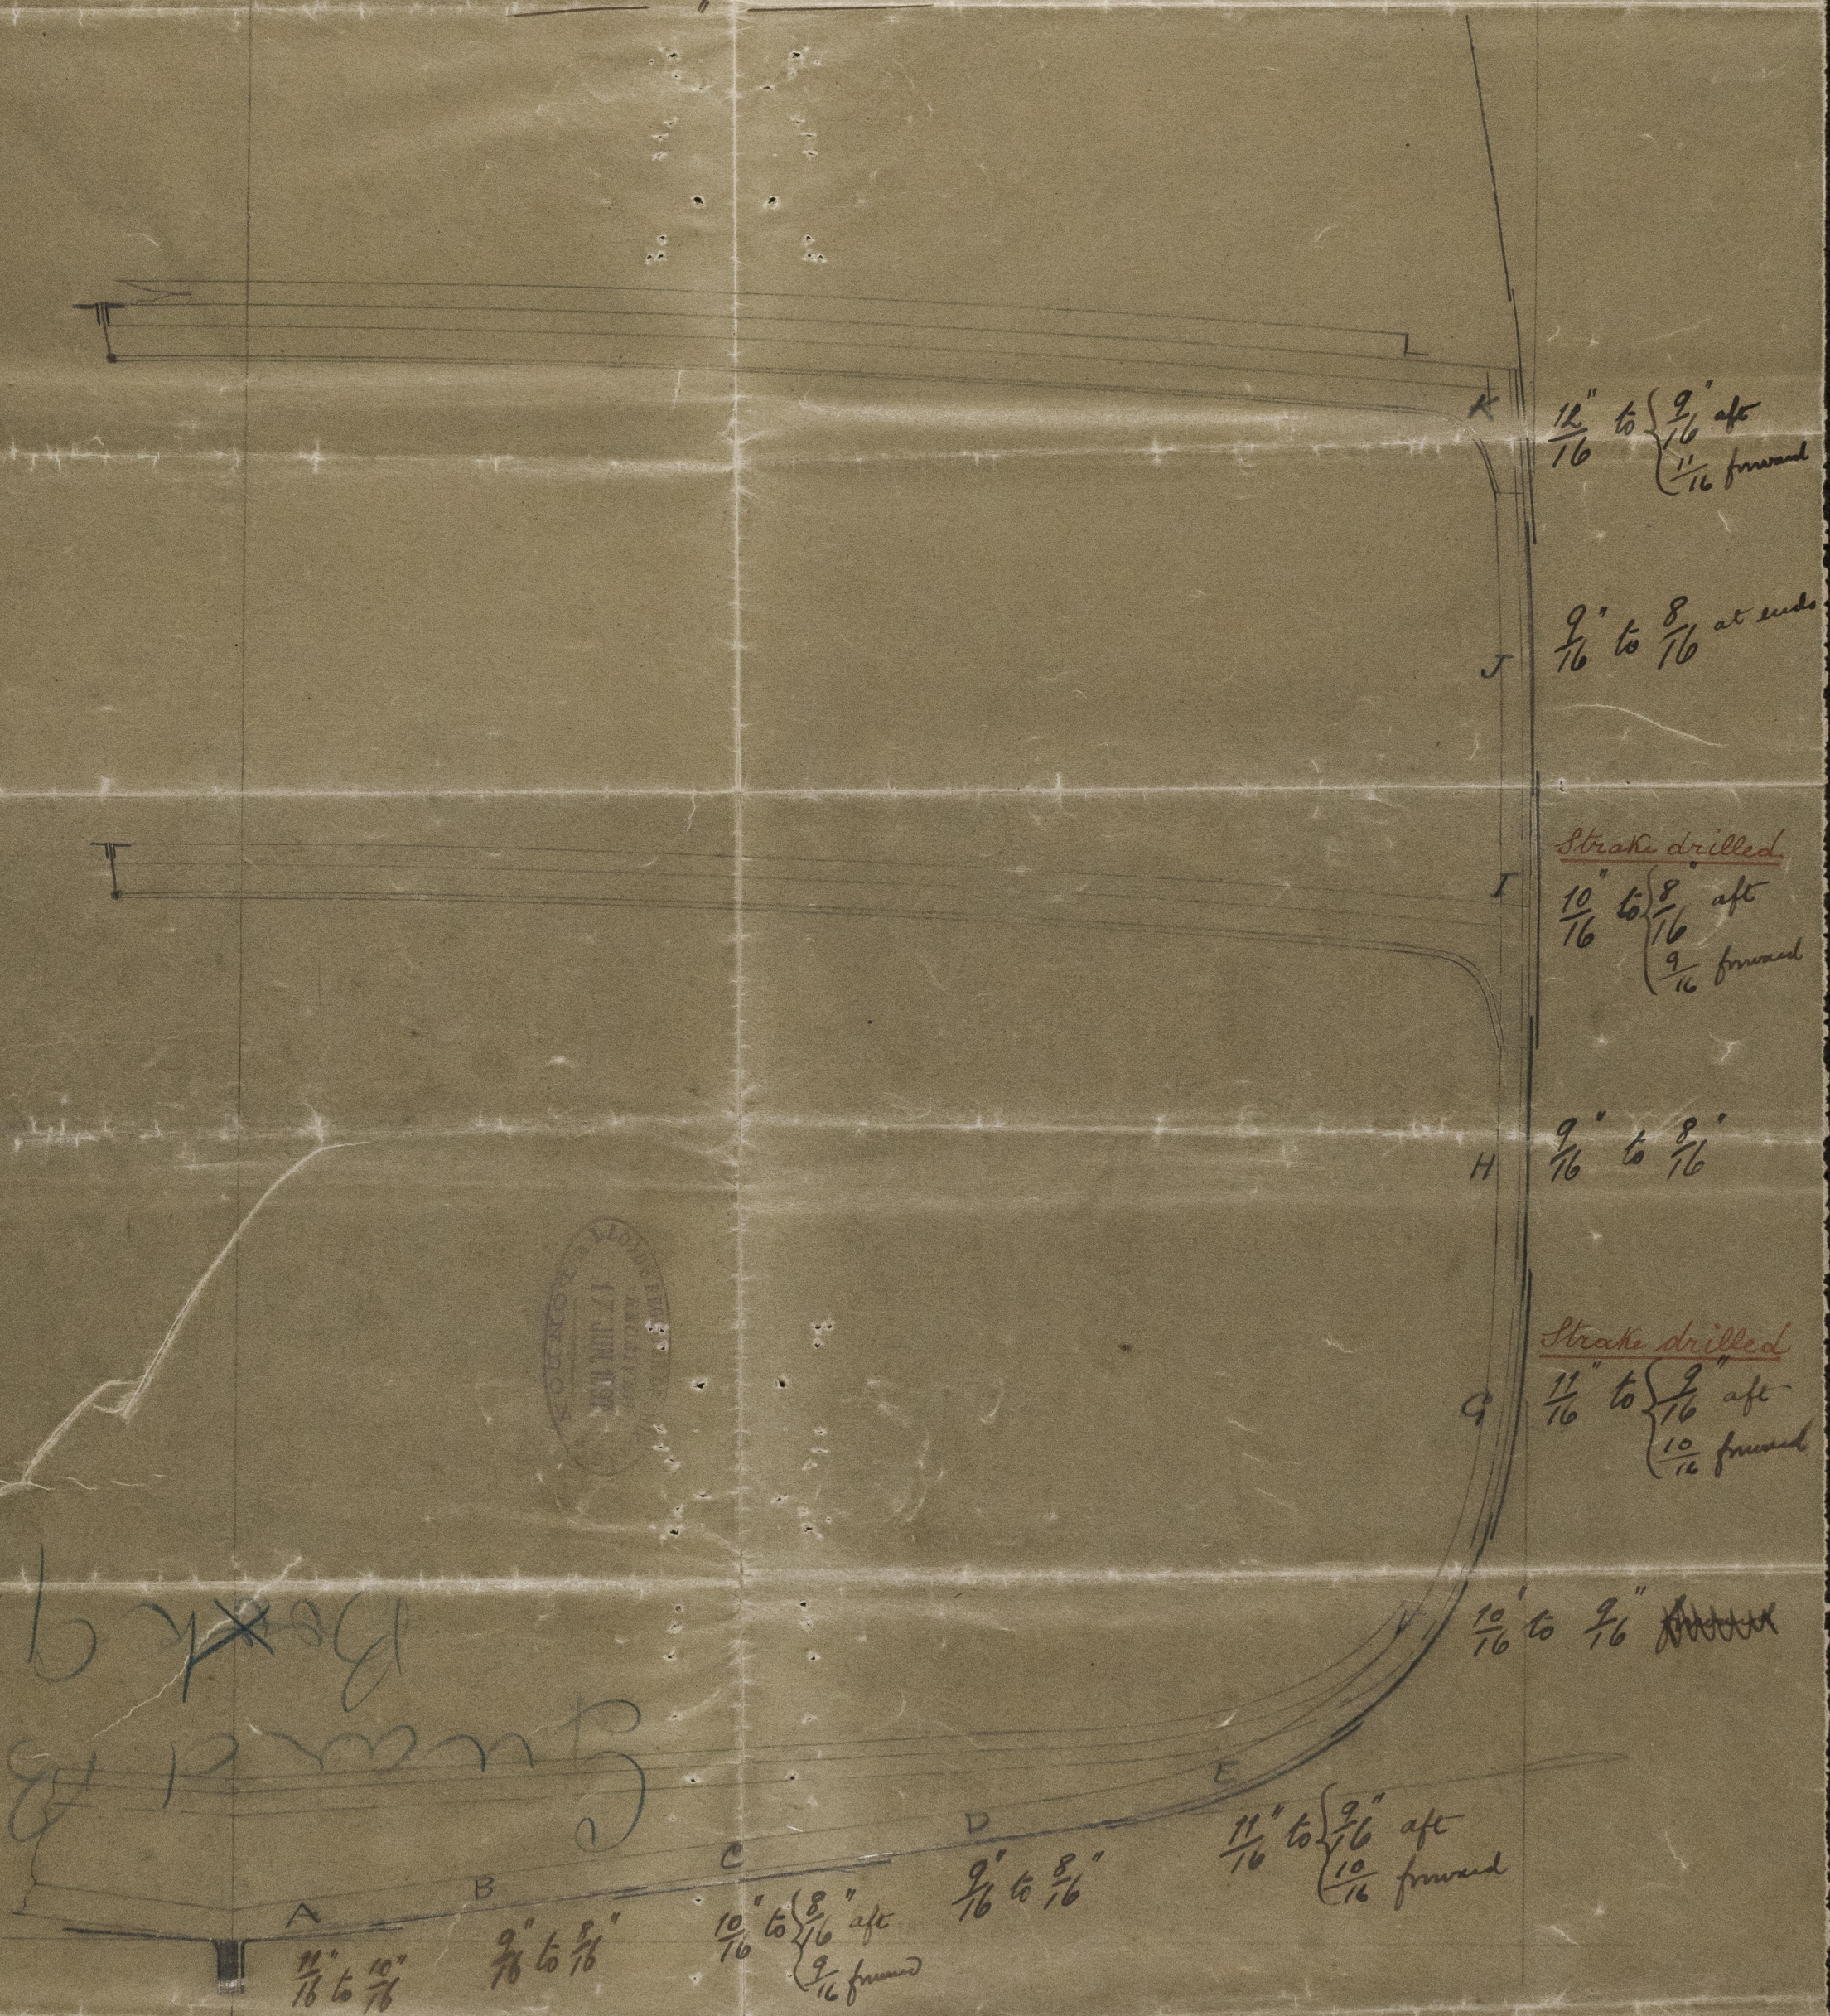

Guard 1300
Box 9

GALATHÉE
Dk 520



© 2021
Lloyd's Register
Foundation