
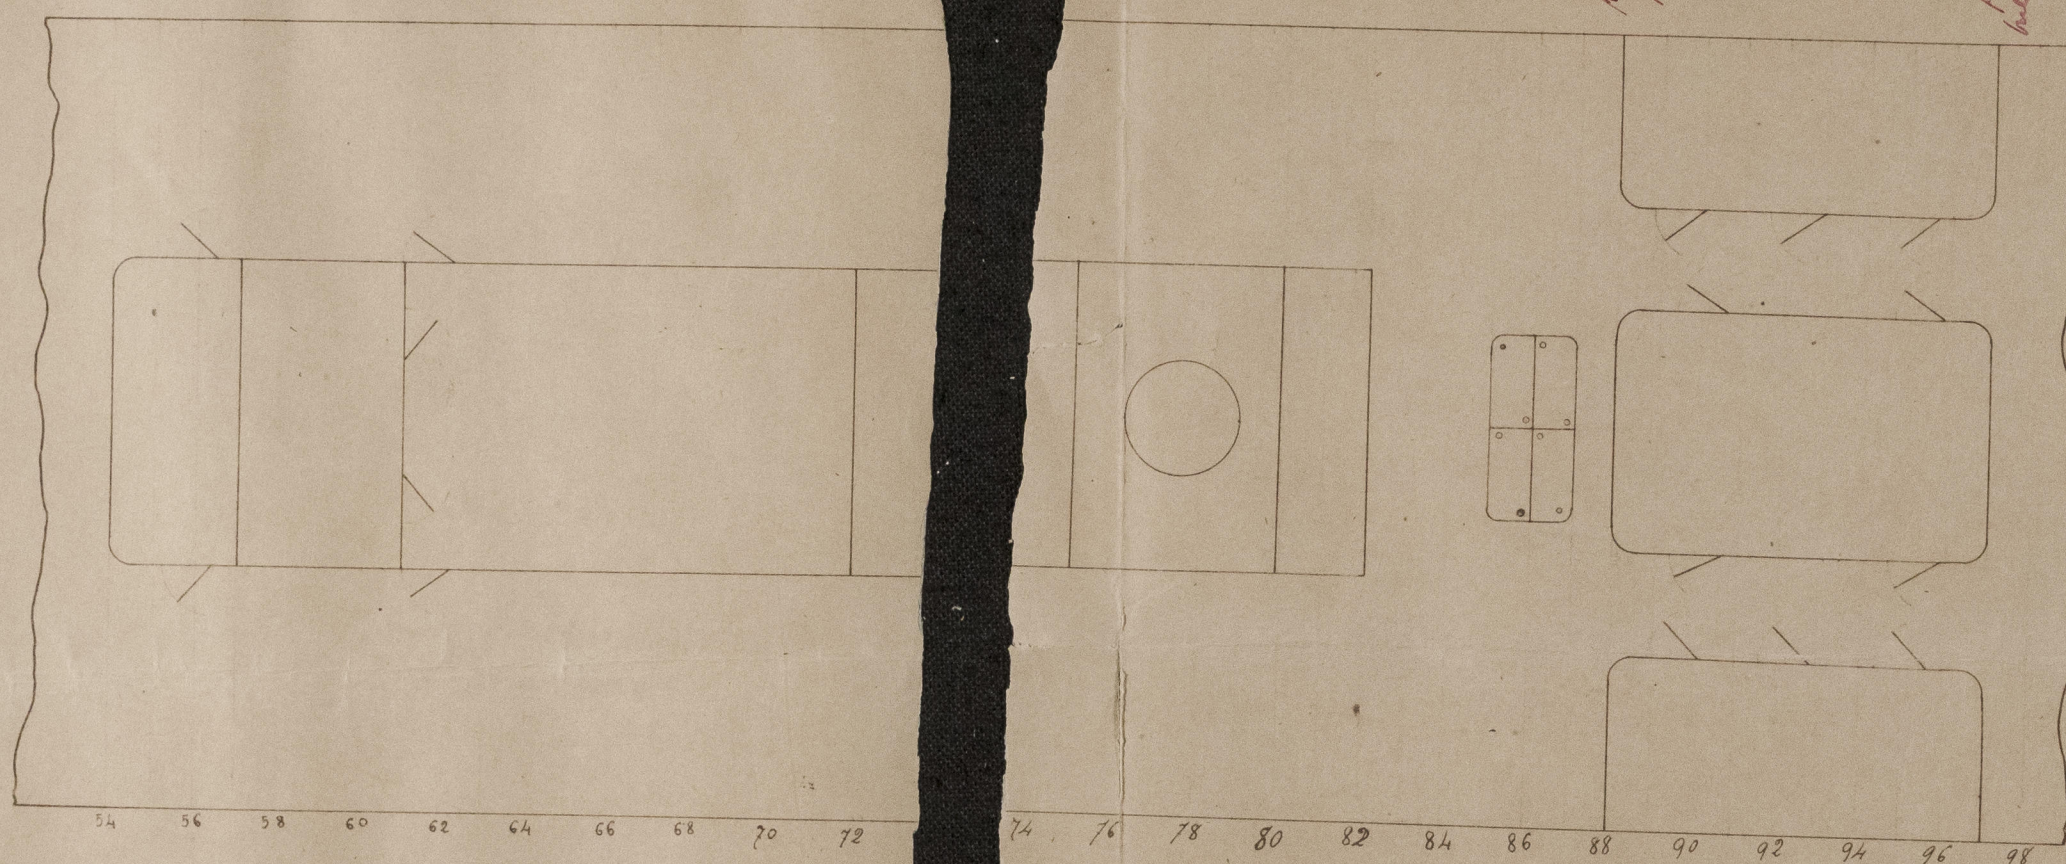



P 17
193

10.8.99

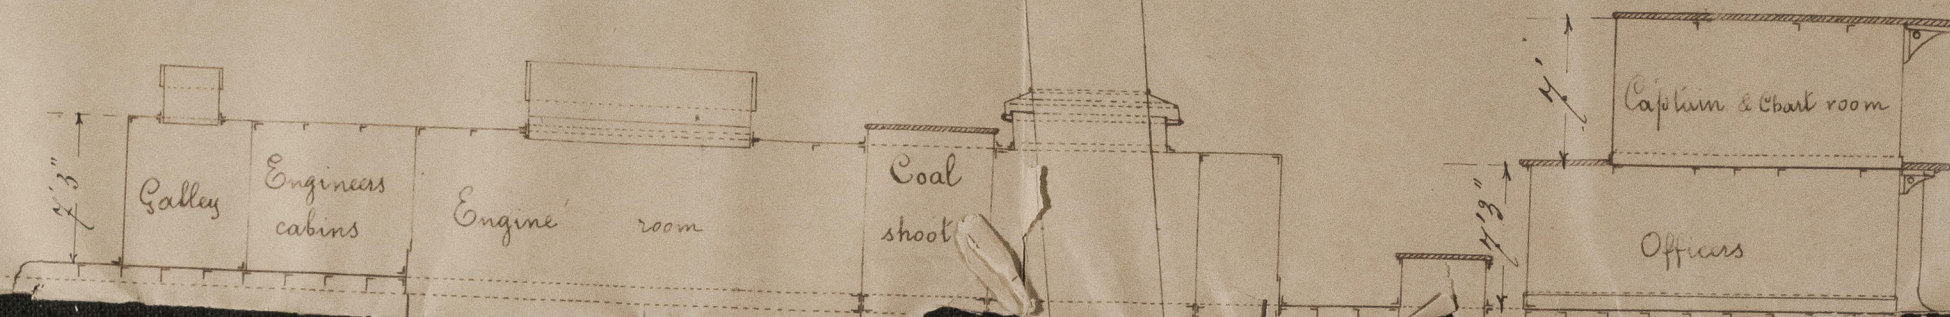

CARGO-BOAT N° 187

Scala 1:100

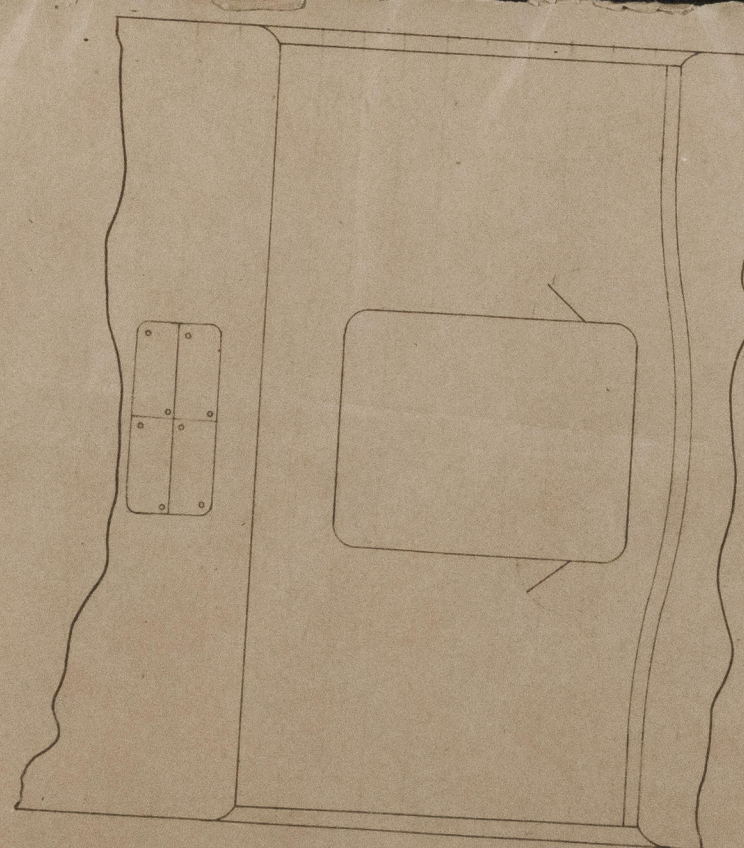

J.H.
9/8/99




© 2021

Lloyd's Register
Foundation

W36SB4-0003

MANIN Gen Log
Guard Book Box
10

66/8/01/20
10/9/20

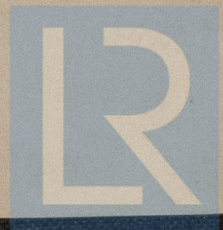

© 2021

Lloyd's Register
Foundation