



SIZES MARKED THUS ARE DRAWING SIZES.
ACTUAL SIZES MEASURED FROM SHIP & STERN
TUBE MACHINED ACCORDINGLY STERN POST TO
BE BORED OUT TO DIRECTION OF ENGINEERS.

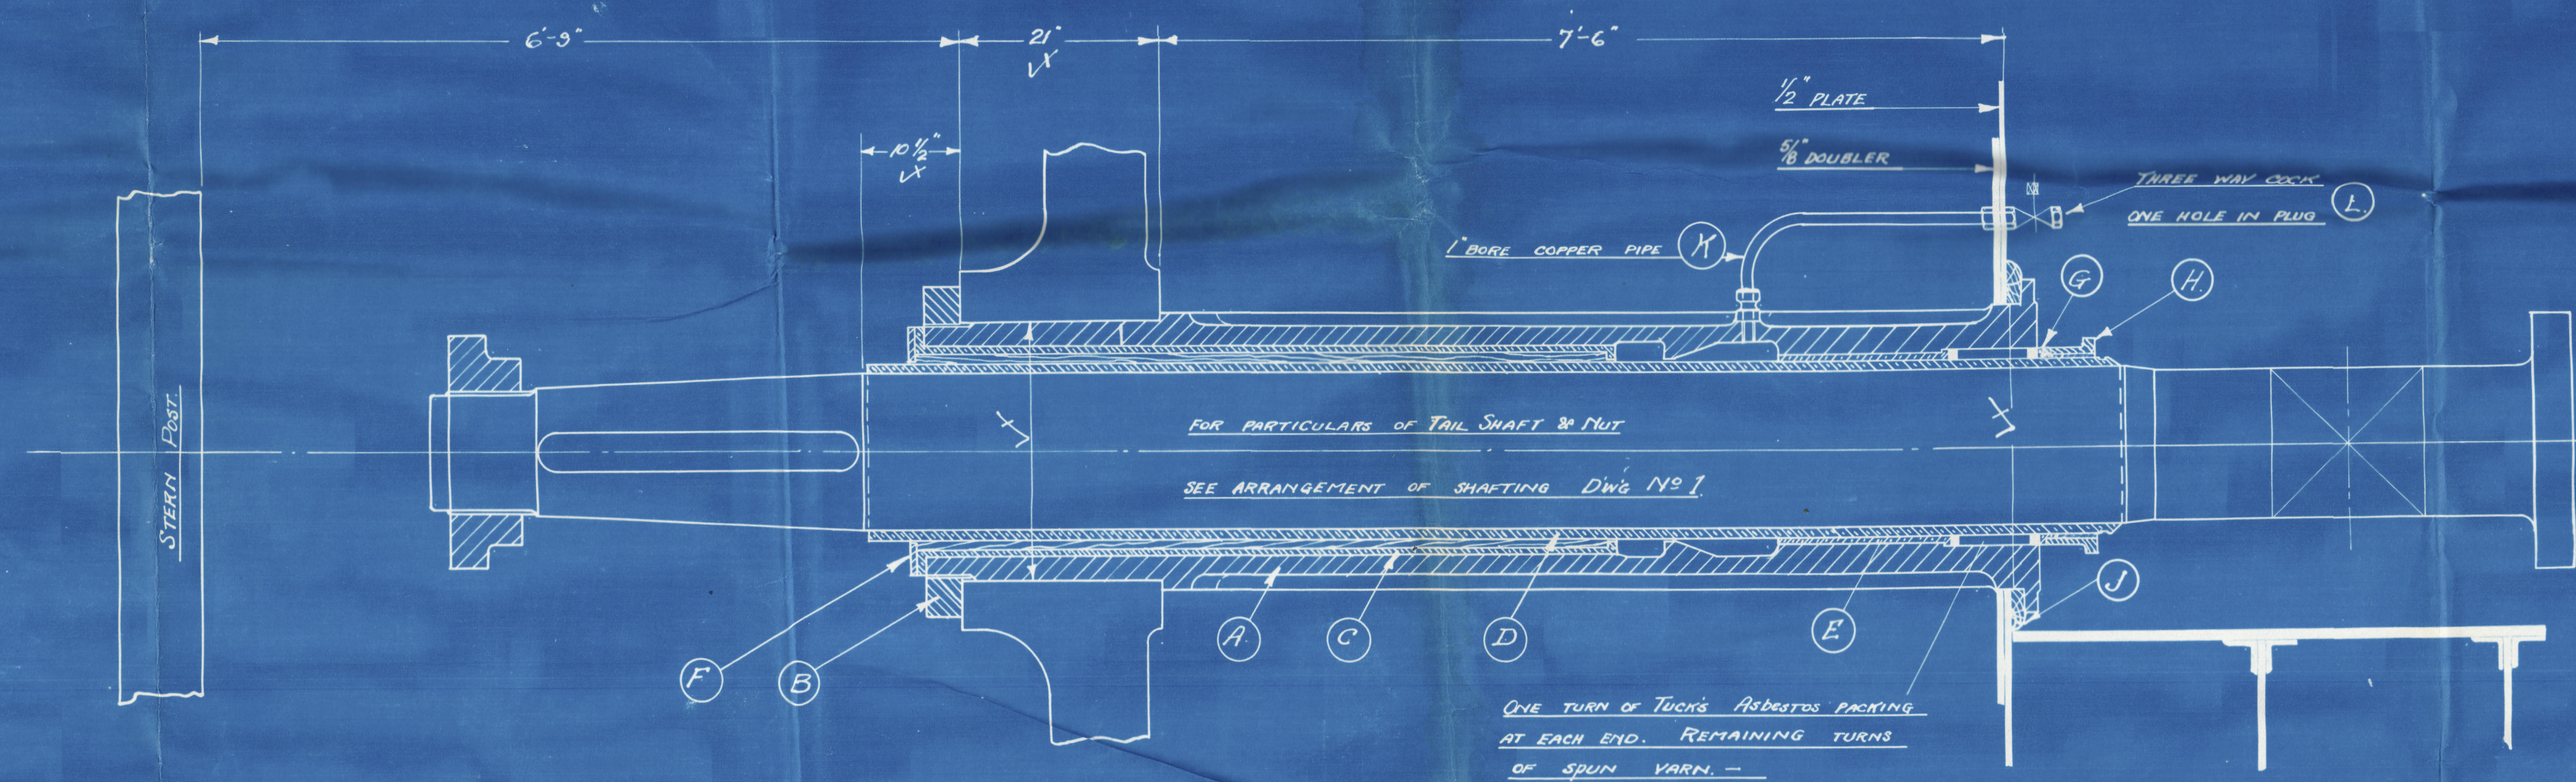

ARRANGEMENT OF STERN TUBE
SCALE 1" = 1'-0"

| MARK | NO OF | MATERIAL | DESCRIPTION | PART NO | REMARKS |
|------|-------|------------|---------------------------|---------|---------|
| A | 1 | CAST IRON | STERN TUBE | | |
| B | 1 | MILD STEEL | " " " " " " | | |
| C | 1 | GUN METAL | BEARING STERN TUBE LINER | | |
| D | 1 | " | TAIL SHAFT LINER | | |
| E | 1 | " | NECK BUSH | | |
| F | 1 | " | GUARD RING | | |
| G | 1 | " | GLAND BUSH | | |
| H | 1 | CAST IRON | GLAND | | |
| J | 1 | WOOD | PACKING RING | | |
| K | 1 | COPPER | PIPE & COUPLINGS COMPLETE | | 1" BORE |
| L | 1 | " | THREE WAY COCK | | 1" BORE |
| M | 2 | MILD STEEL | KEYS | | |

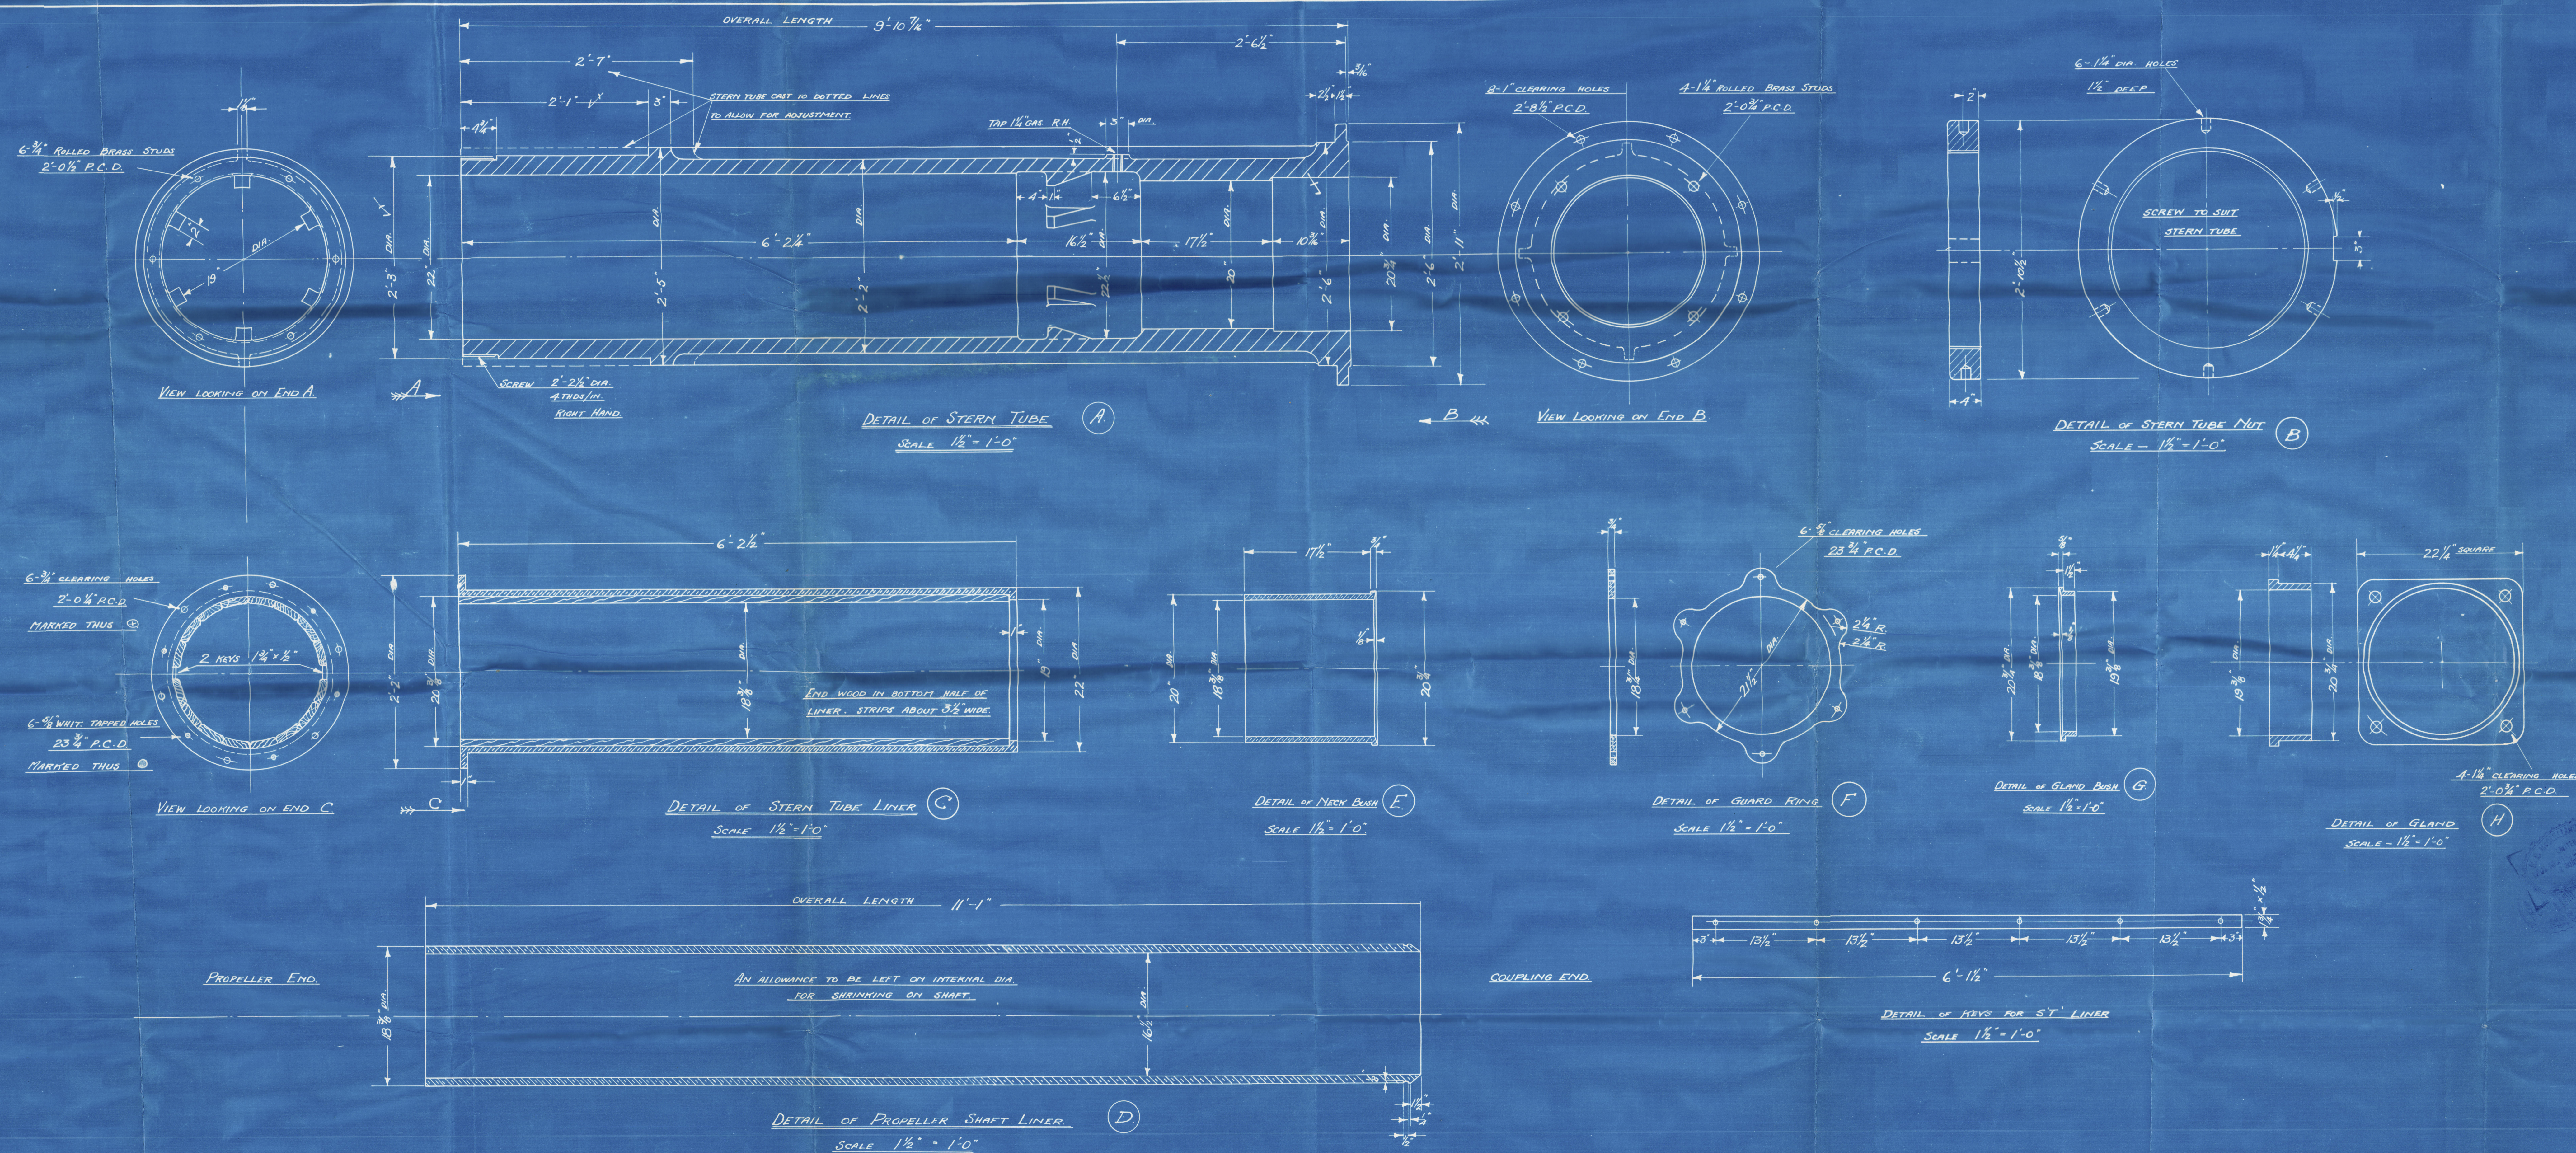

Scrawls 16 1/2" diameter
under continuous line

APPROVED
JUL 8 - 1920
REGISTERED
HALIFAX SHIPYARDS LIMITED
HALIFAX, N.S. CANADA

ARRANGEMENT & DETAILS
OF STERN TUBE
ENGINES NOS. 384
PLAN NO. 4
SCALE: 1/2" = 1'-0"
DATE
N.E. McCLELLAND - C.O. L. MONTREAL

RETAIN
Canadian
Cruiser

Am. & Details of Stem Tube

W367-0015

RETAIN


Canadian
Cruiser



© 2021

Lloyd's Register
Foundation

W367-0015

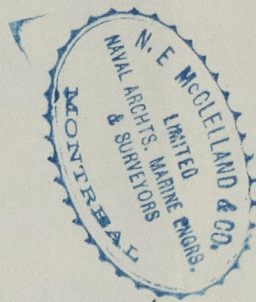

© 2021

Lloyd's Register
Foundation



© 2021

Lloyd's Register
Foundation