
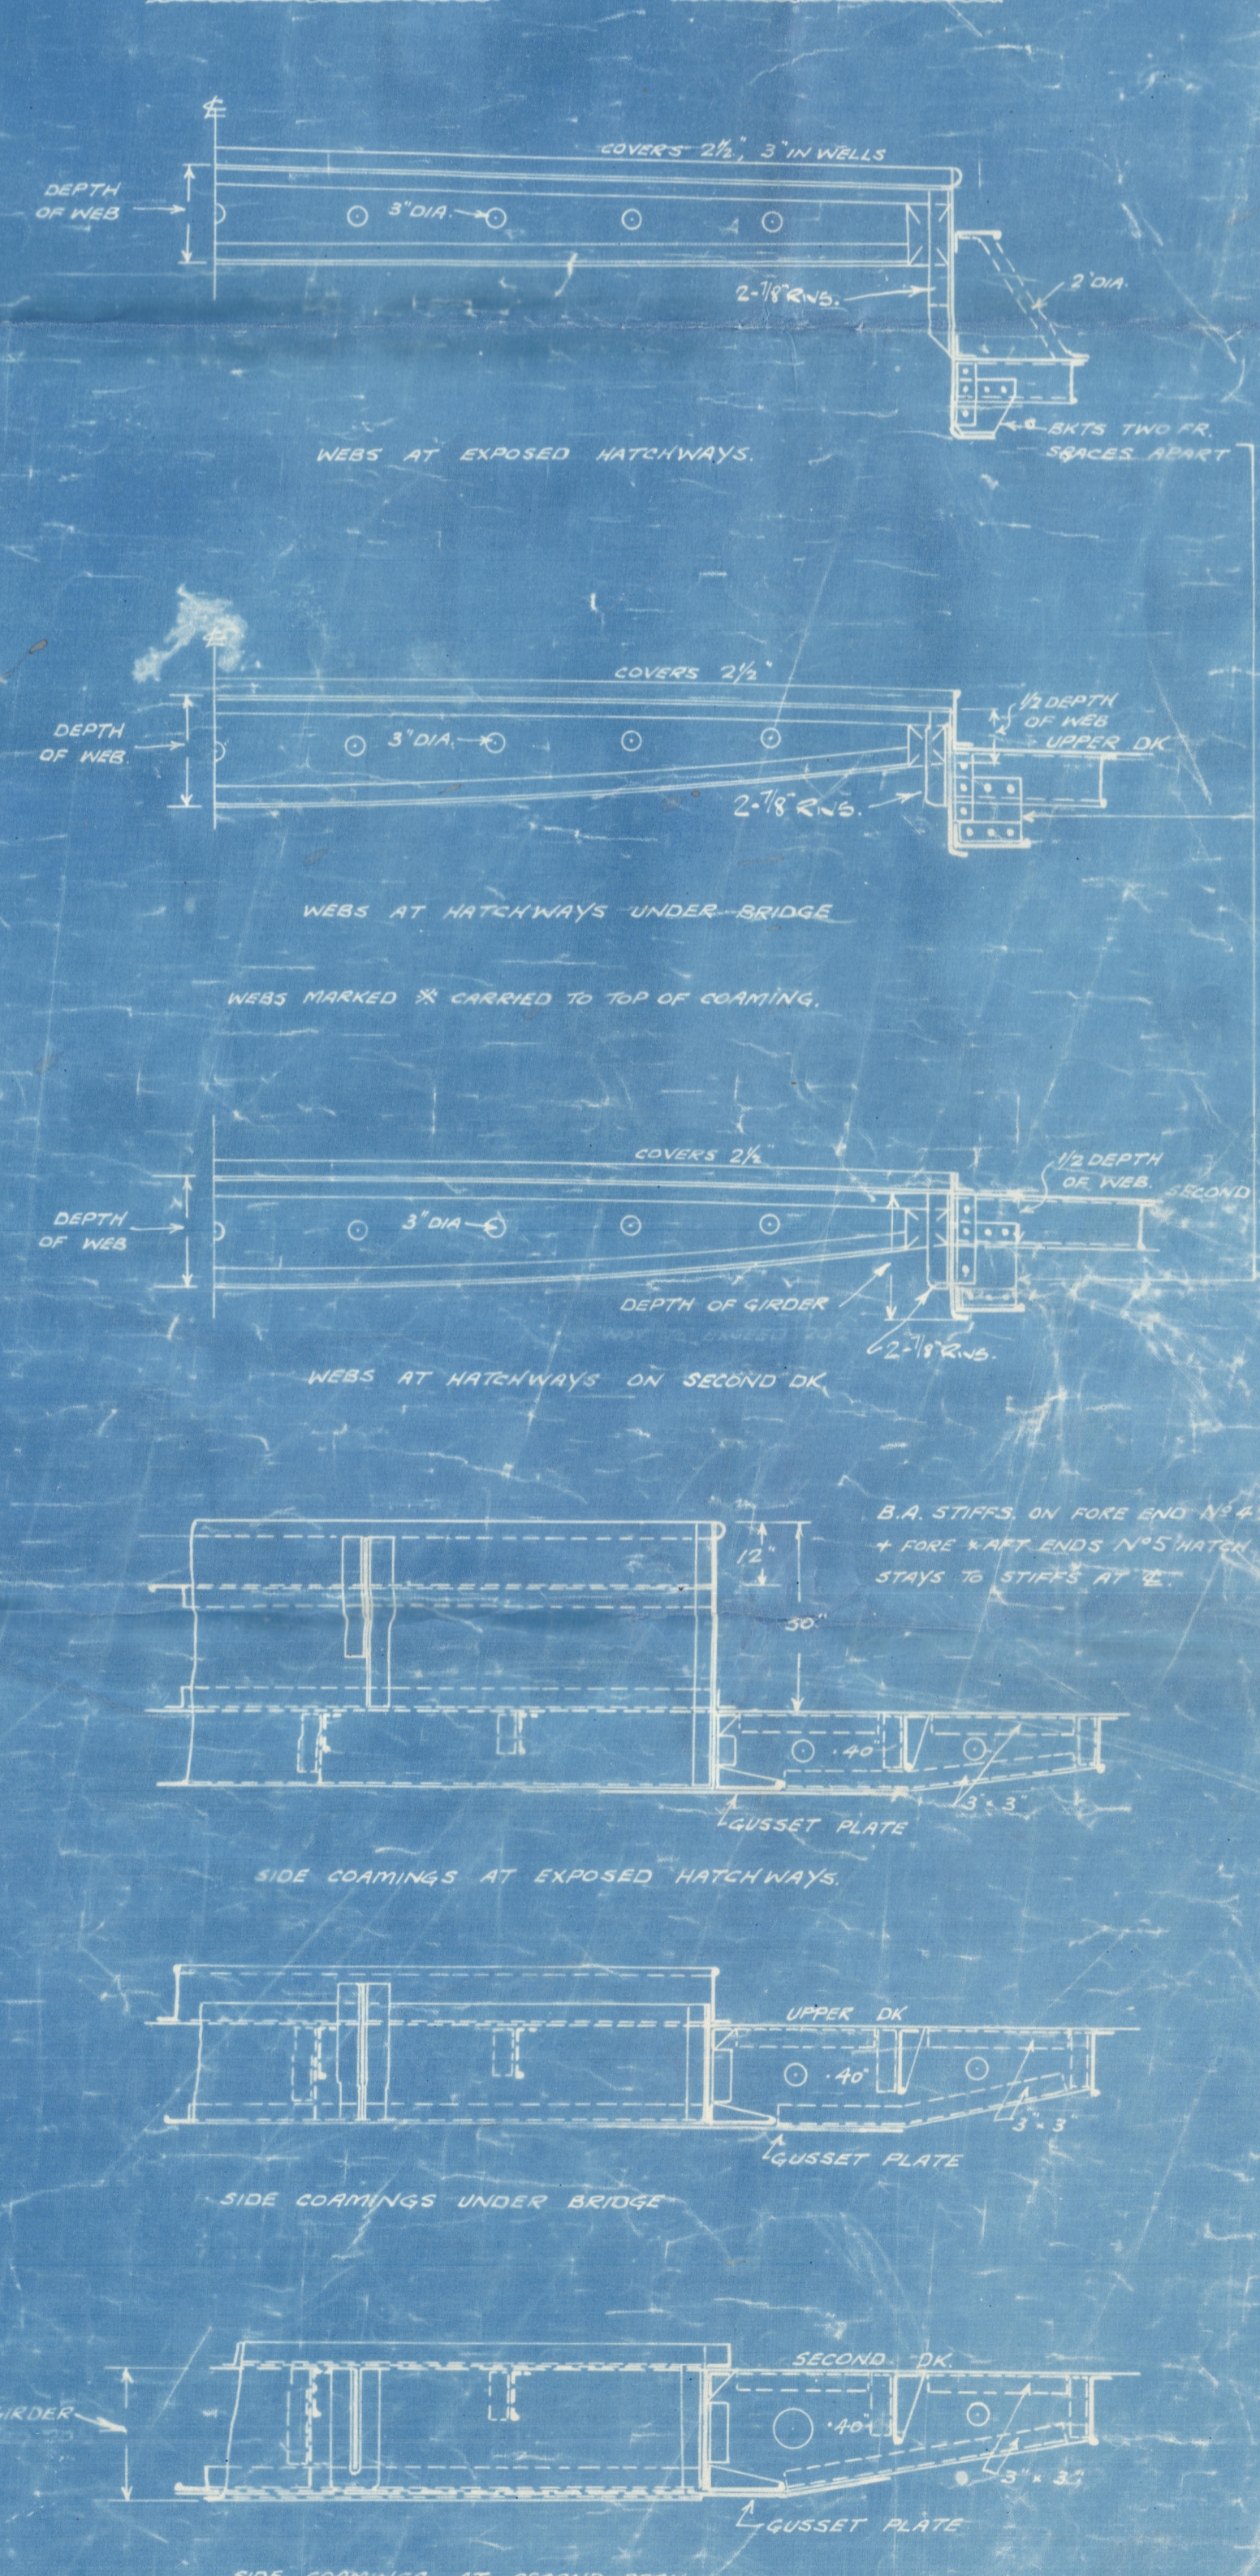
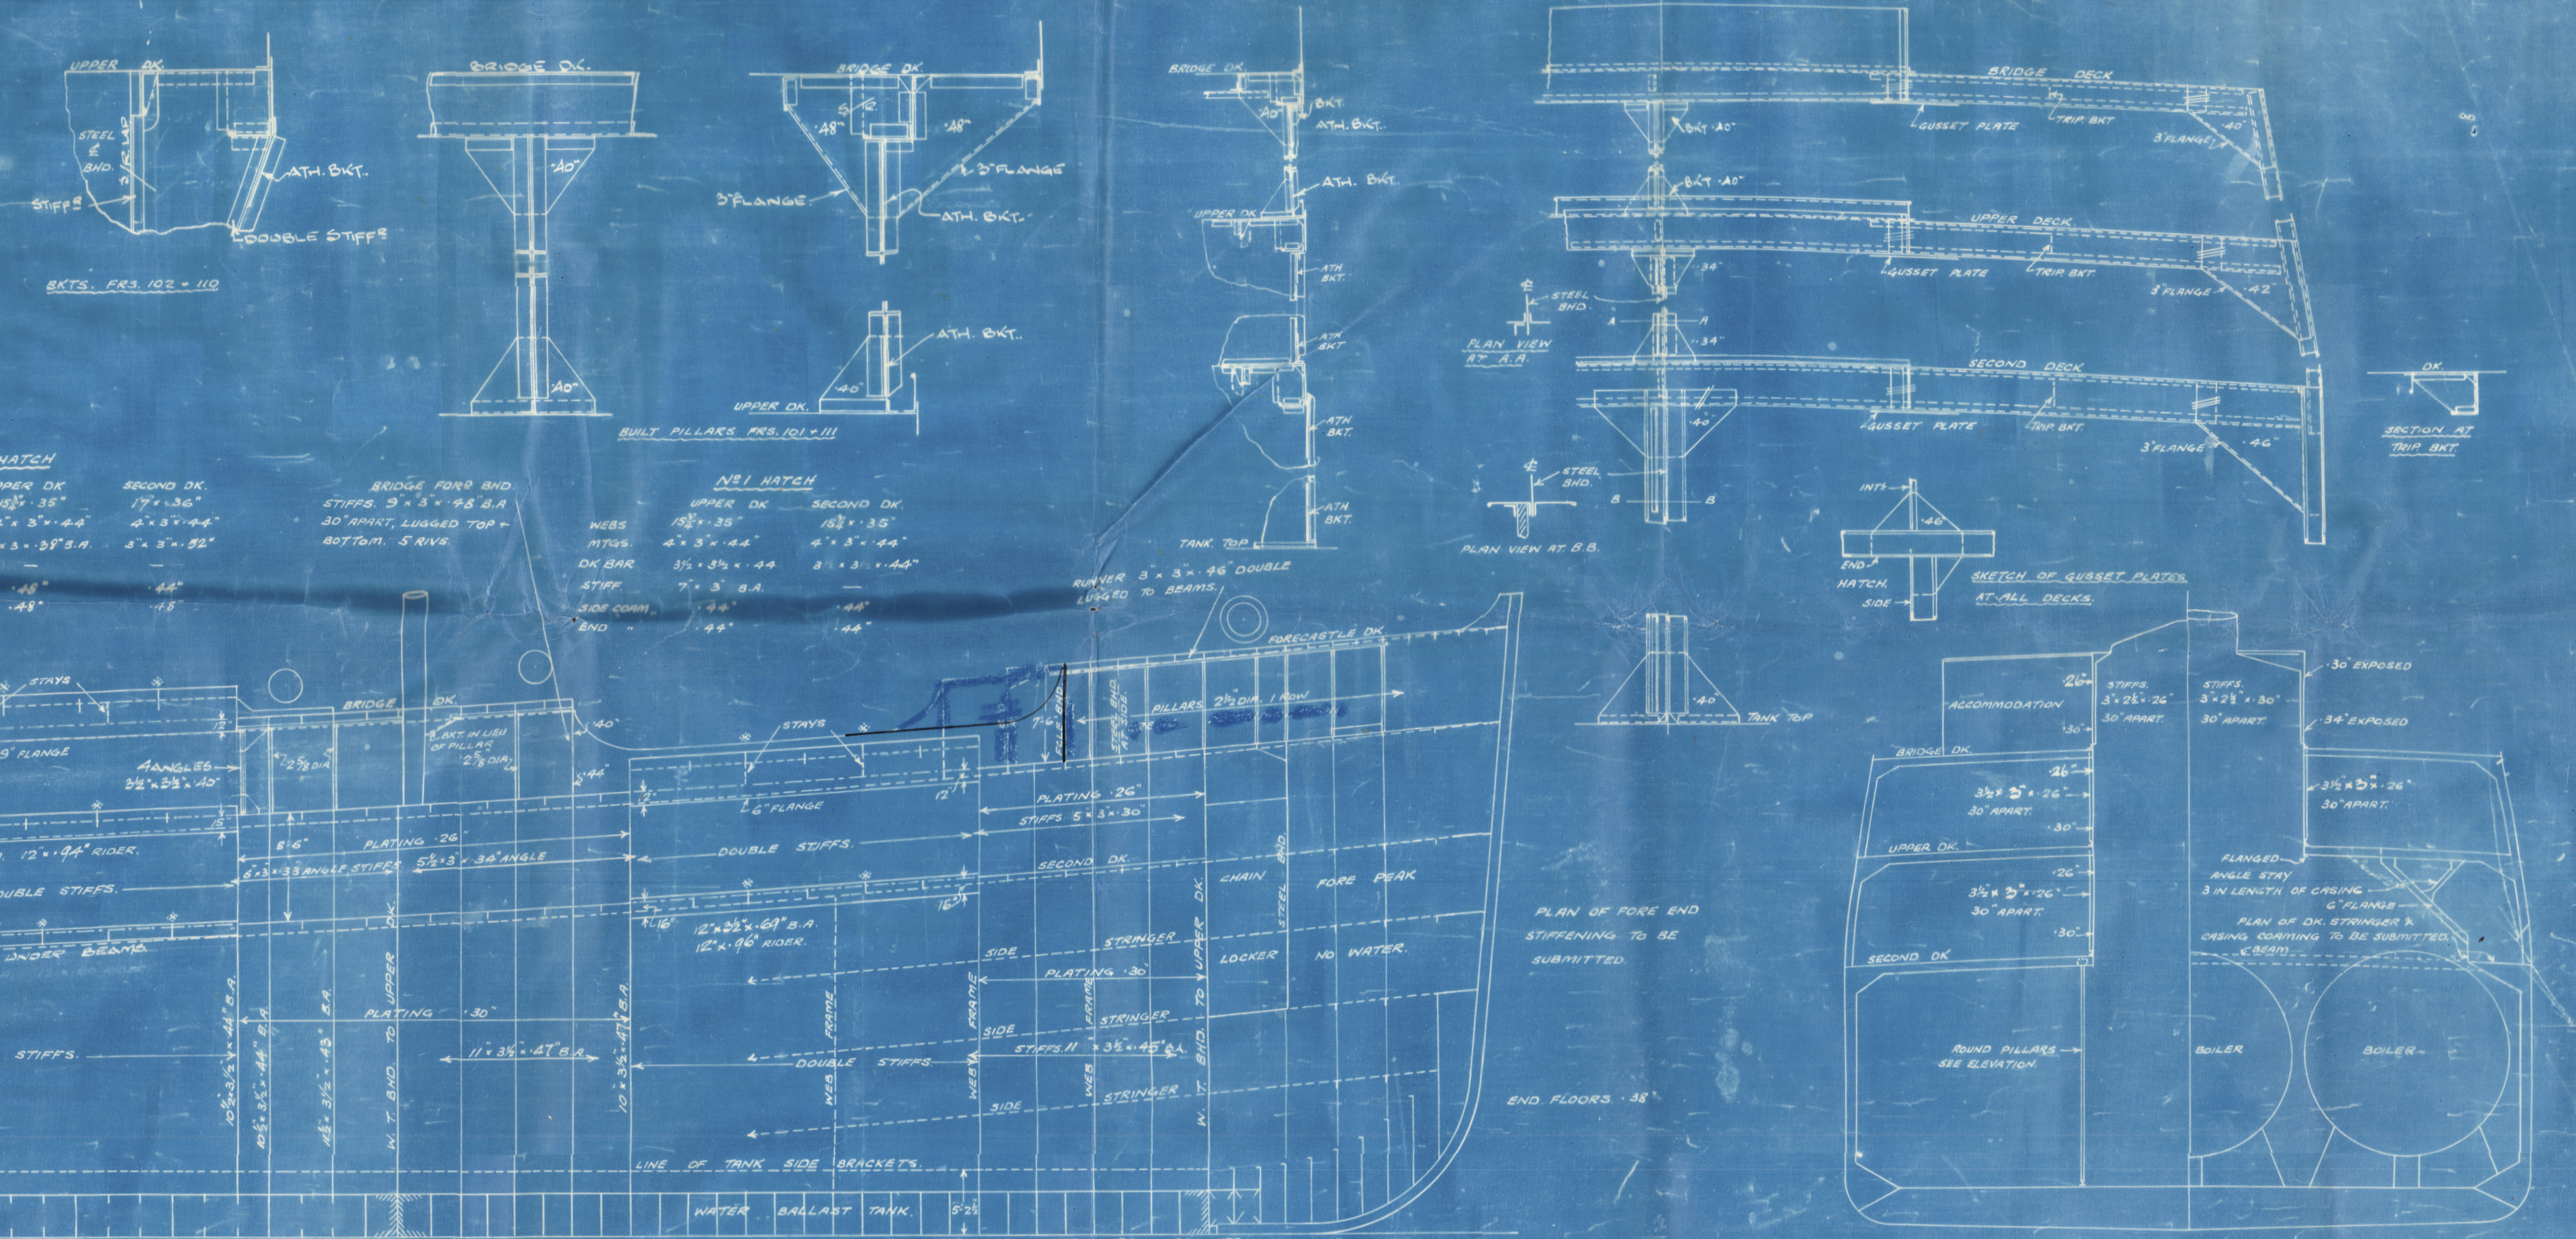


S.S. CAPE ST ANDREW.
PROFILE & DECK PLAN.
No 381.

SCALE 1/8" IN = 1 FT.
TO CLASS 100 A1 AT LLOYDS
RULE DIMS. 404' 7 1/2" x 53' 3" MLD. = 29' 0" MLD. TO UPPER DECK

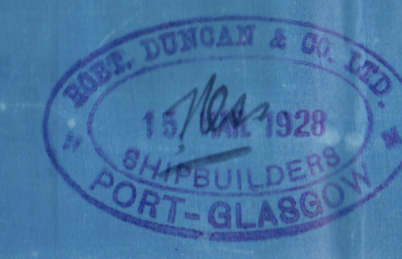

R. DUNCAN & Co.

N^o 381.

PROFILE AND DECK PLAN. (As Built).

S. S. "CAPE ST. ANDREW."

GREENOCK REPORT N^o 18856.

RETAIN

RETAIN

W368-0102



© 2020

Lloyd's Register
Foundation