



—N° 656.—

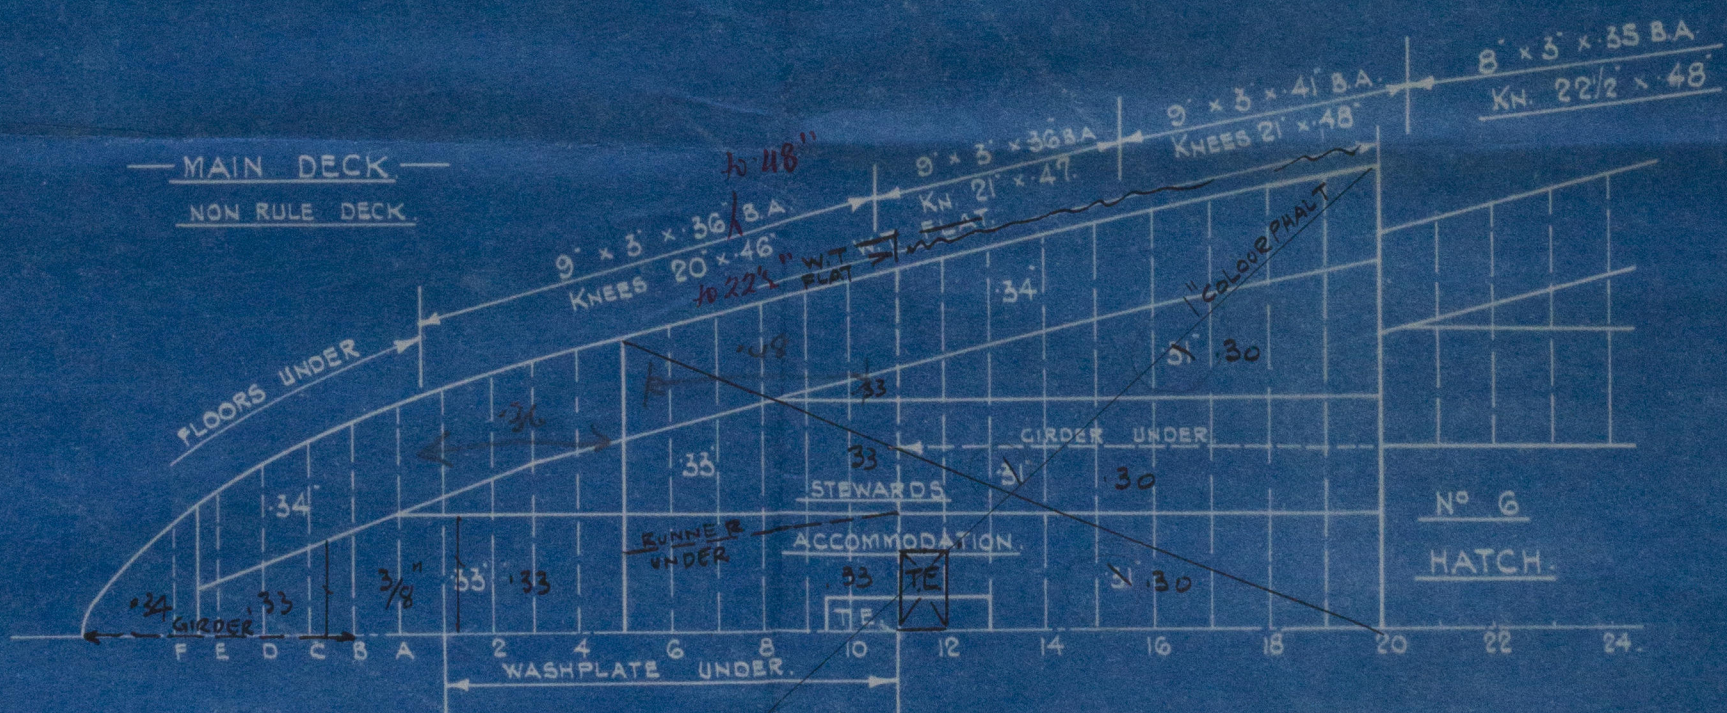

—PROFILE & MAIN DECK AT AFTER END.—

Scale: $\frac{1}{8}'' = 1 \text{ Foot}$.

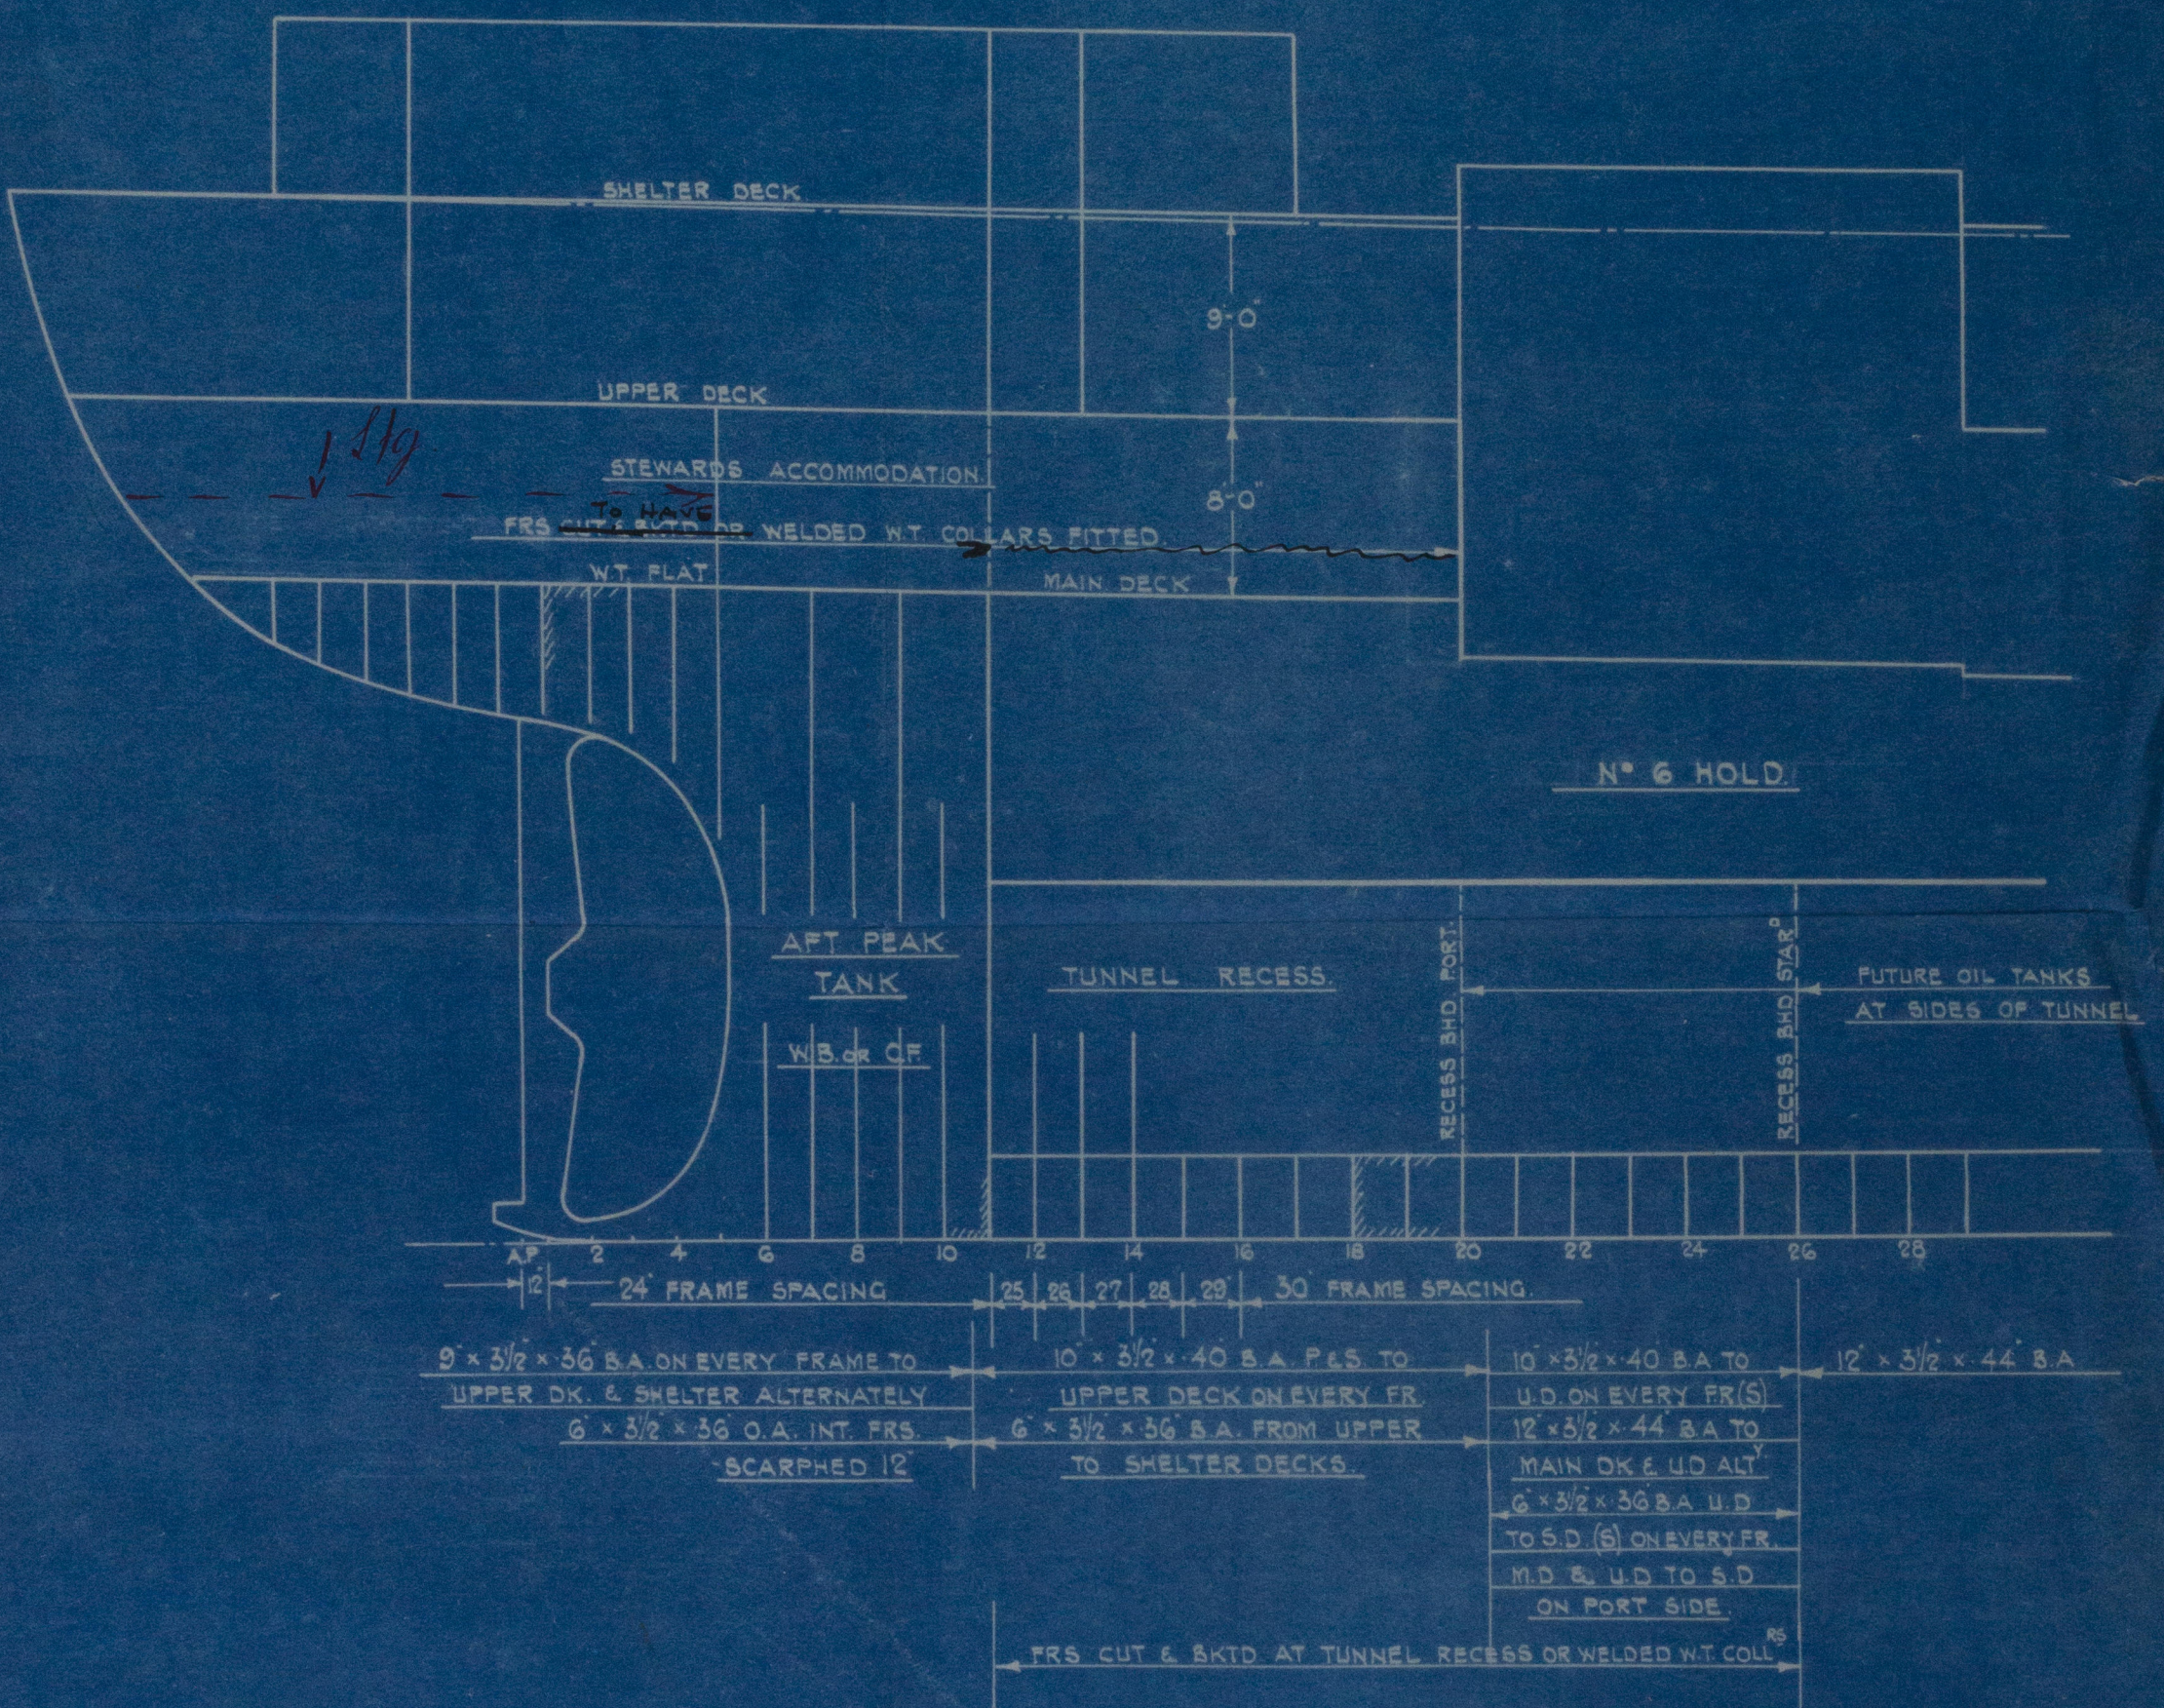

APPROVED

LLOYD'S REGISTER OF SHIPPING

Richardson

DATE 4-11-35



Lloyd's Register Foundation

W369-0121

34

Messrs. Barclay, Curle & Co. Ltd.


Yard No 656.

Profile & Main Deck at After End.

"City of Benares"

GLASGOW REPORT No. 57571

RETAIN

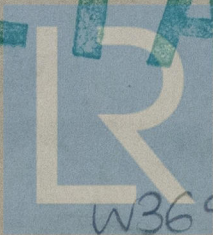

© 2020

Lloyd's Register
Foundation

W369-0121