


SCALE $\frac{1}{8}$ = 1 FT.

Amended to agree with
the vessel as built.


alt.
alt.

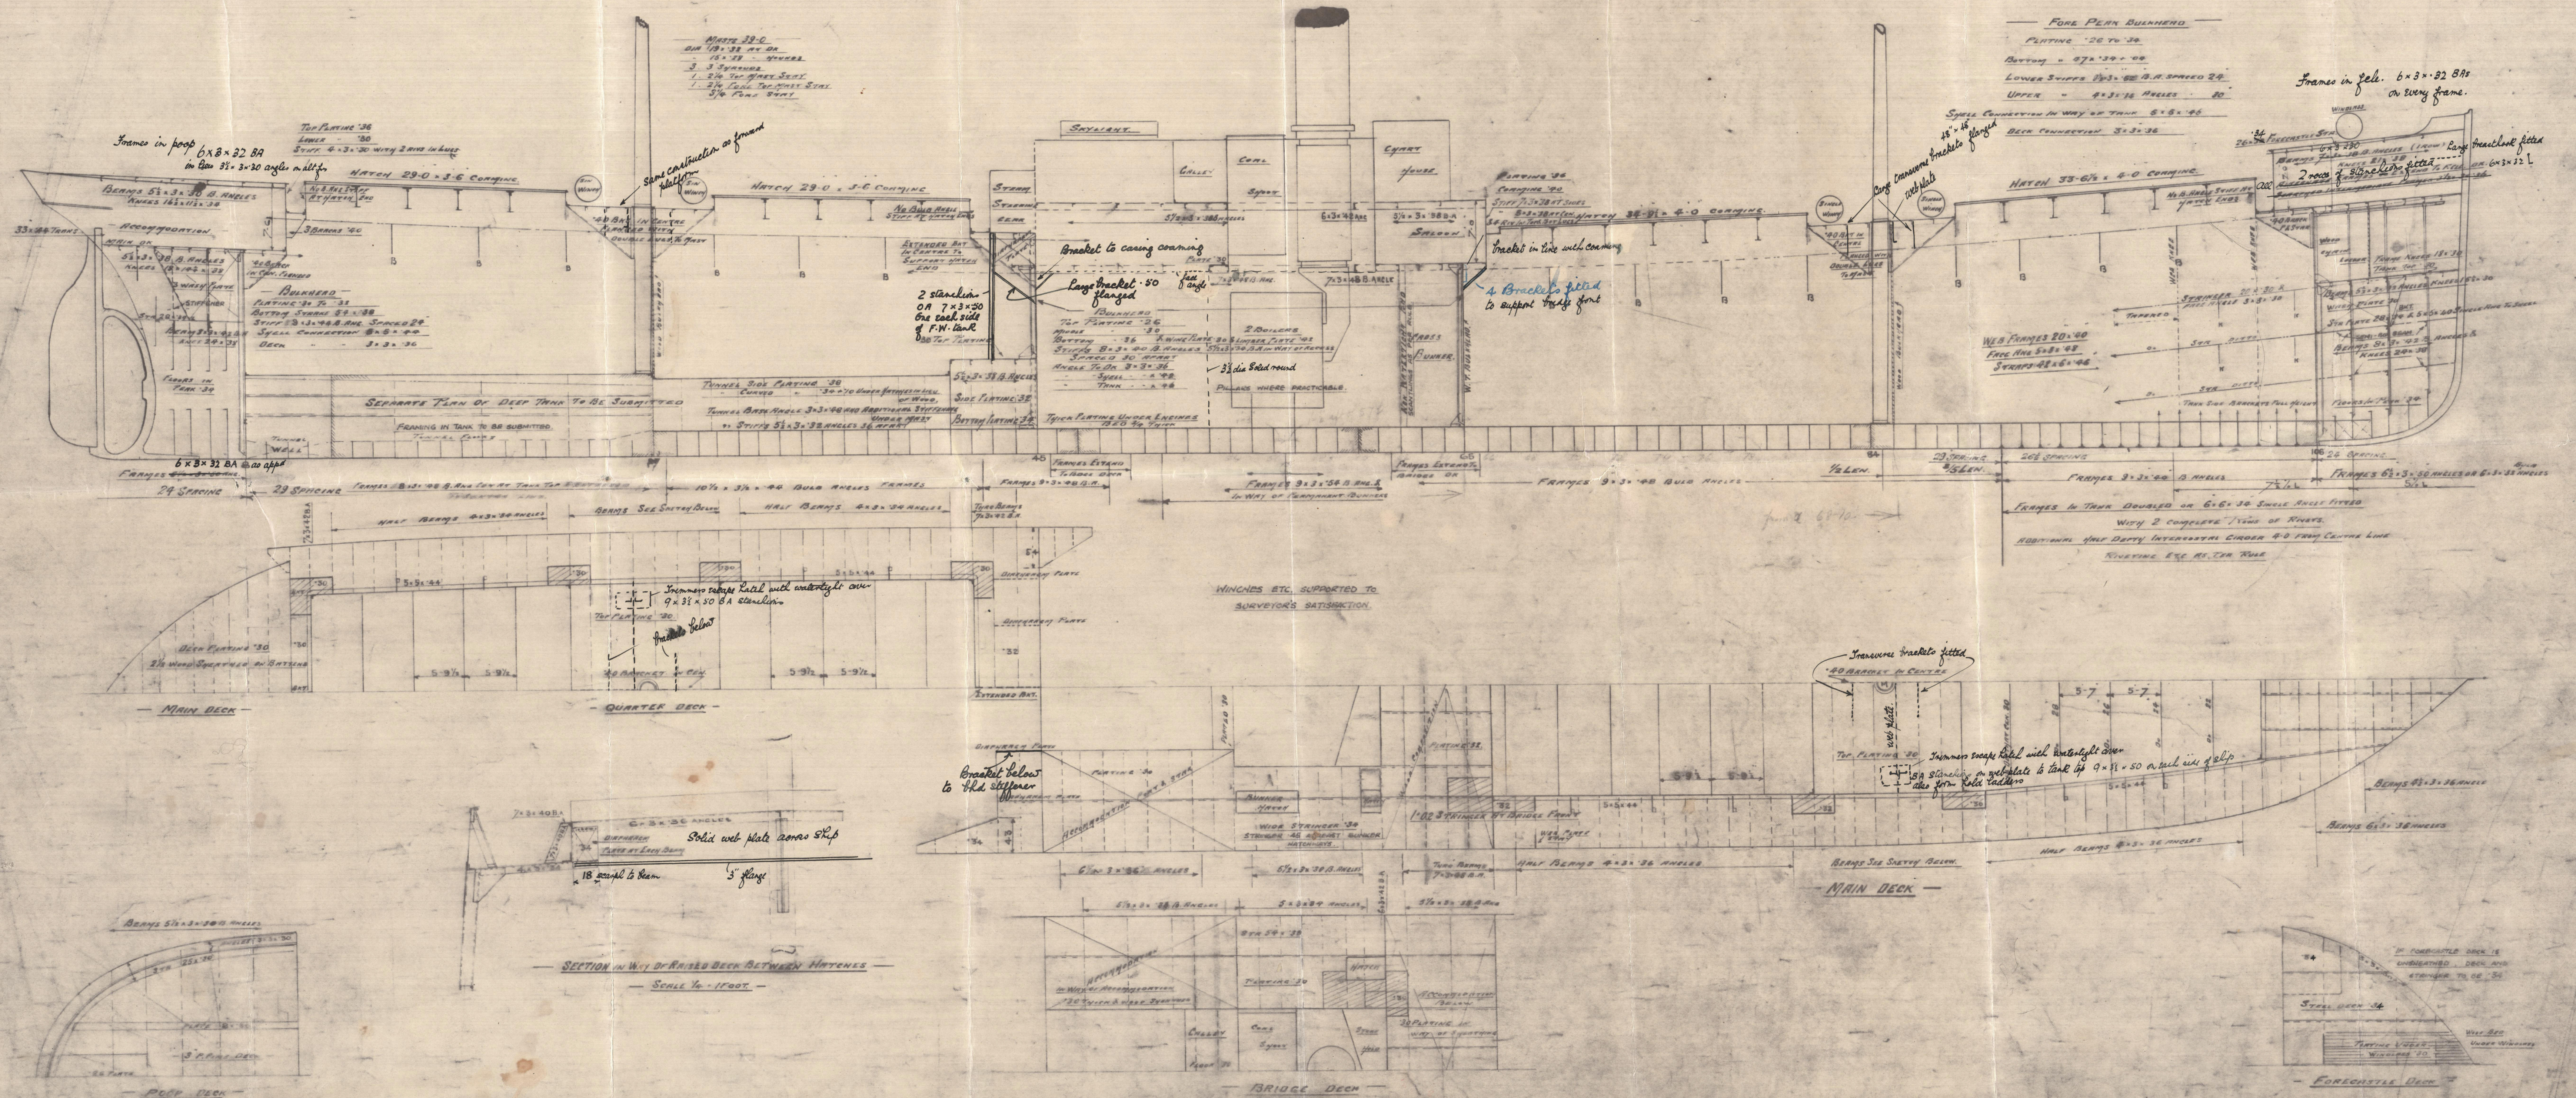

S/S "Fetnwood"

Profile as built.

DUNDEE RPT: NO. 28684

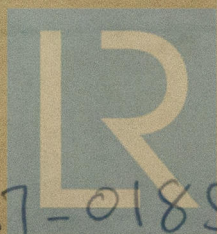

© 2021

Lloyd's Register

W37-0185 Foundation