

18.12.22


S. Nos 68788

PROFILE

DIMENSIONS

268'0" x 37'8" x 20'3"

SCALE 1/4" = 1 FT.

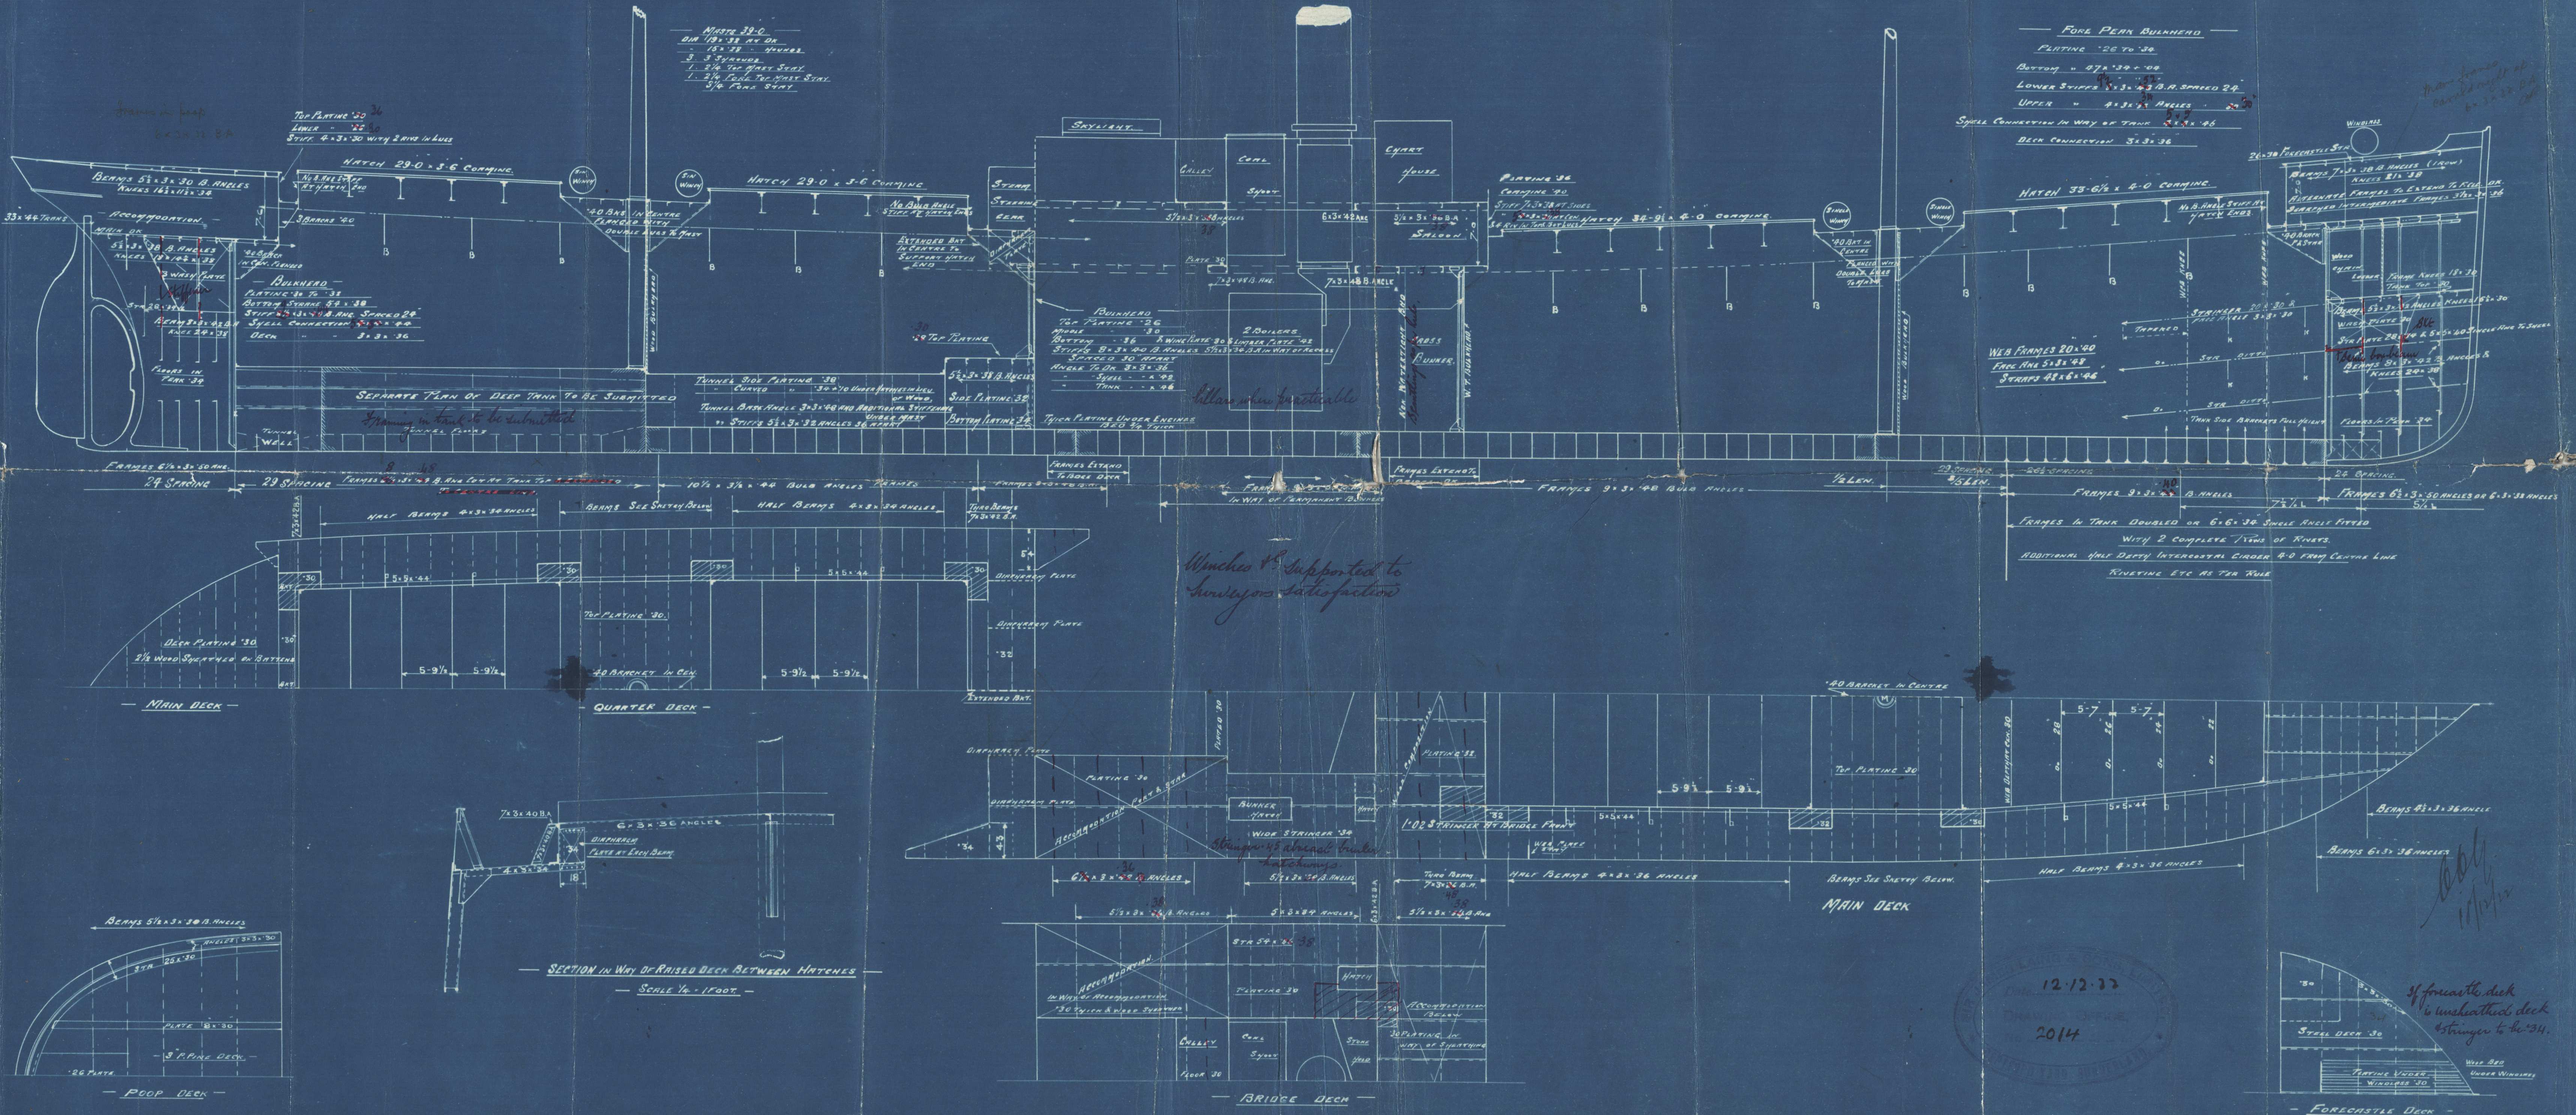

Winches & supported to
hull for satisfaction

12-12-22
DRAWING OFFICE
2014


if possible deck
is unsketched deck
is stronger to be 34.


SUNDERLAND

MESSRS LAINGS

Nos 687 & 8

PROFILE & DECKS

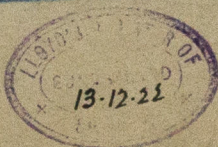

"Fernwood" 

SUNDERLAND RPT. NO. 28684

"Moorwood"

SUNDERLAND RPT. NO. 28423



© 2021

Lloyd's Register

Foundation

W37-0086