

RETAIN

Palmer, S.B. & Co. Ltd.

No 848



Midship Section ✓

See Amended Midship

Section

13/11/14

9 1/2

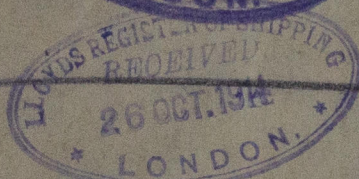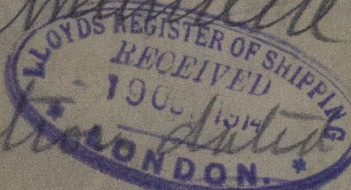

S S CADILLAC' JUNK.
NEWCASTLE ON TYNE.

Report No. 70543.

S.S. SARANAC' JUNK.
NEWCASTLE ON TYNE.

Report No. 70987.

RETAIN

W370-0082



Lloyd's Register
Foundation