

848

### ISHERWOOD SYSTEM (PATENT).


Per WAB 2/10/1



AMENDED PROFILE SHEWING MODIFICATIONS  
 IN LENGTH OF OIL FUEL TANK, NO 3 OIL TANK & FORE HOLD.  
 DIMENS:- 530'-0" x 66'-6" EXT. x 42'-0" TO SHELTER DECK.

8848

ISHERWOOD SYSTEM (PATENT).  
 1/8" SCALE.

 

CHAIN  
 LOCKER.  
 SKETCH TO BE SUBMITTED  
 FORE PEAK  
 WATER BALLAST

6-10-14

W370-0053




Palmis No 848

Amended Profile showing modification in  
length of oil Fuel tanks, No 13 oil tank + Fire Hold

S. S. CADILLAC  
NEWCASTLE ON TYNE.


Report No. 70543

RETAIN

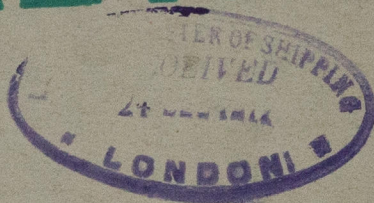


S. S. 'SARANAC'  
NEWCASTLE ON TYNE.

Report No. 70987

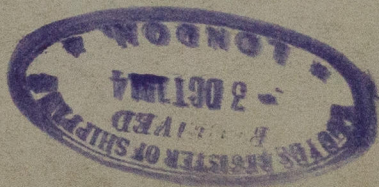

W370

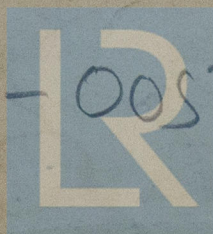

© 2021

Lloyd's Register  
Foundation