

DIMENSIONS:- LENGTH 530'-0" x BREADTH EXT 66'-6" DEPTH M.D. 34'-0"  
SCALE 1/2" = 1 FOOT  
ISHERWOOD SYSTEM (PATENT)

LHOVAS NUPPEA 3  
 BREATH MLO 66 1/2  
 DEPTH MLO 34 0  
 100 15 TRANS NO  
 LENGTH B.P. 5 30 ✓  
 5307 10 00 LONG 1/2 M

DOUBLE STRAPS TREBLE RIVETS  
WHERE OVER 6 THICKNESS. TO  
TREBLE OVER LAPS AT ENDS.

[illegible]

RIVERS SPACED 6 DIAS. APART. No 3  $9 \times 3 \frac{1}{2} \times .44$  B.A.

RIVERS SPACED 6 DIA. APART.



EQUIPMENT NUMBER		
LONGITUDINAL NUMBER		530.74
SHELTER DECK	$530 \times 5 \div 3$	3180
HOUSE AFT	$19 \times 5 \div 2$	296
BRIDGE	$25 \times 11 \div 2$	144
EQUIPMENT NUMBER		566.94

[illegible]







Dublin's B. & H. Co.

848 + 865

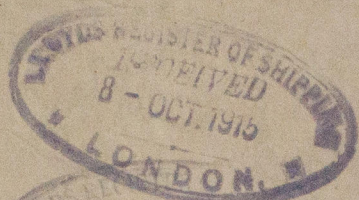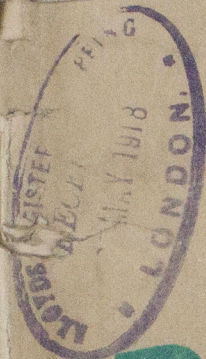


RETAIN

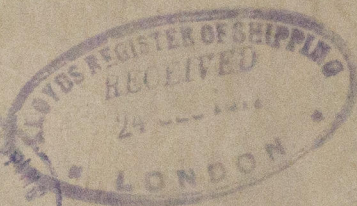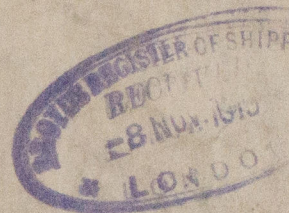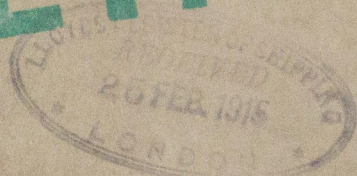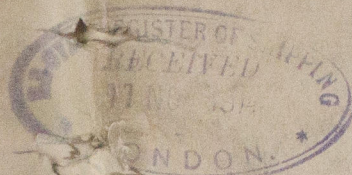

SS CADILLAC

NEWCASTLE ON TYNE.

Report No. 70543

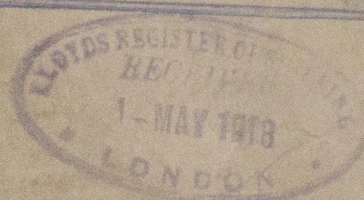

SS SARANAC

NEWCASTLE ON TYNE.

Report No. 70981

RETAIN

W370-0055



© 2021

Lloyd's Register Foundation