

MIDSHIP SECTION

STEAM SCREW TRAWLERS

NOS 1203-4 & 5

175'-0" B.P. x 30'-0" MLD. x 16'-0" MLD.
TO CLASS 100.A.I. STEAM TRAWLER.

SCALE 1/2" IN = 1 FT.

NUMERALS

L x D ----- 2800
L x (B + D) ----- 8050

EQUIPMENT

1ST BOWER ANCHOR	13 CWTs. STOCKLESS
2ND " "	12 " "
KEDGE " "	4 1/2 " EX. STOCK
150 FMS 1 5/16" STUD LINK CABLE	
60 " 6" HAWSER	
60 " 6" WARP.	

RIVETING


ALL LANDING EDGES TO BE DOUBLE RIVETTED
EXCEPT TOP EDGE OF SHEER-STRAKE WHICH IS
TO BE SINGLE RIVETTED

BUTTS OF GARBOARD AND SHEER-STRAKE STRAPPED
AND TREBLE RIVETTED FOR 1/2 LENGTH, STRAPPED
AND DOUBLE RIVETTED AT ENDS

BUTTS OF E. & F. STRAKES OVERLAPPED AND TREBLE
RIVETTED FOR 1/2 LENGTH, OVERLAPPED AND DOUBLE
RIVETTED AT ENDS.

REMAINDER OF BUTTS OVERLAPPED AND DOUBLE
RIVETTED ALL FORE & AFT.

SHELL RIVETS TO BE STEEL, REMAINDER IRON.

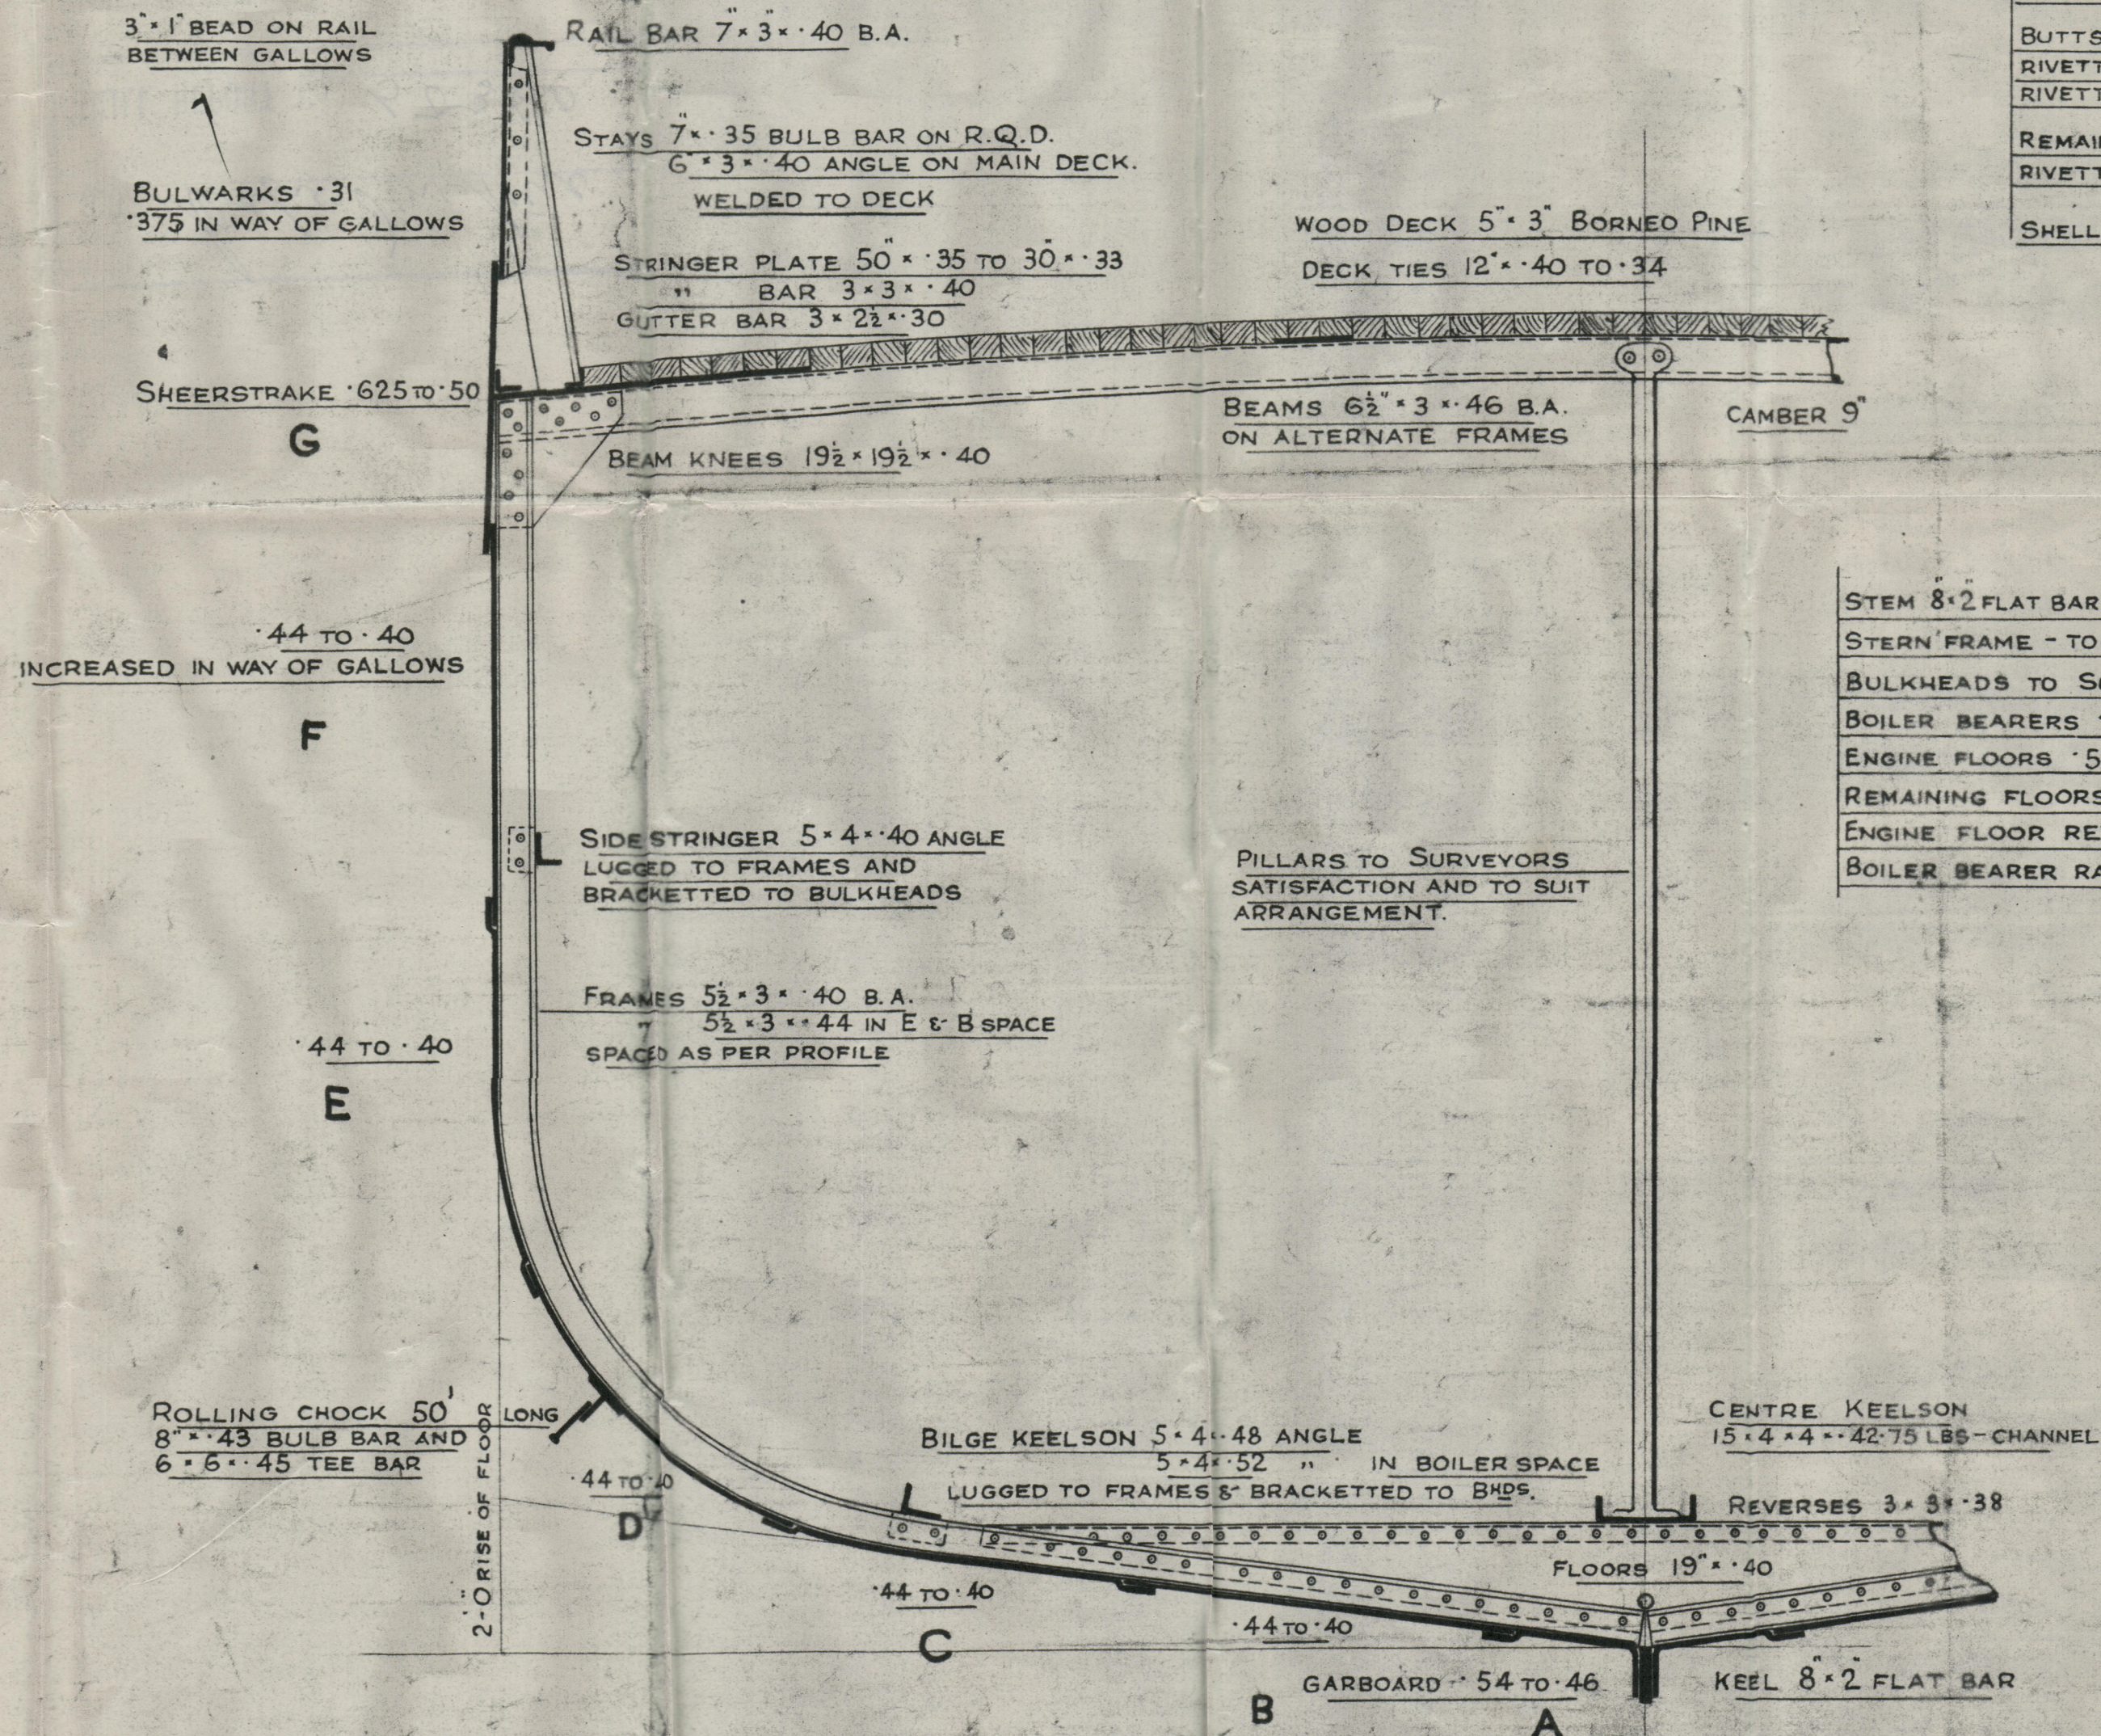

STEM 8" x 2" FLAT BAR AT BOTTOM - DISHED PLATE AT TOP
STERN FRAME - TO BE SUBMITTED
BULKHEADS TO SURVEYORS' SATISFACTION
BOILER BEARERS .625
ENGINE FLOORS .50
REMAINING FLOORS IN E. & B. SPACE .45
ENGINE FLOOR REVERSES 3 1/2" x 3 1/2" x .43 DOUBLE
BOILER BEARER RADIUS BARS 5" x 5" x .50

8.8.

Cape Finistère

HULL REPORT No. *50360*


*Midship Section
(a built) ✓*



CAPE FINISTERRE

HUL RPT NO 50360

RETAIN

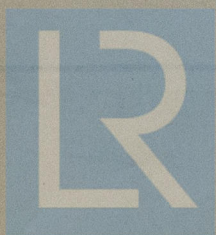

© 2019

Lloyd's Register
Foundation

W371-0012

PLAN No. 3773
FOR ENCLOSURE TO
Messrs Lloyds Register
of Shipping
FROM
COCHRANE & SONS, LTD.
SHIPBUILDERS, SELEY.
DATE 16.10.39

RETAIN



© 2019

Lloyd's Register
Foundation