



6.3.15  
30.4.15  
2.6.15  
17.9.15

44/2

—SS.N°44.—

—LONGITUDINAL PLAN—


180'-0" x 30'-0" x 14'-0"

CLASSED AT LLOYD'S  $\clubsuit$  100 A 1

SCALE  $\frac{1}{8}" = 1'-0"$

TRANSVERSE NUMBER B+D = 30+14 = 44

LONGITUDINAL .. L(B+D) = 180 x 44 = 7920

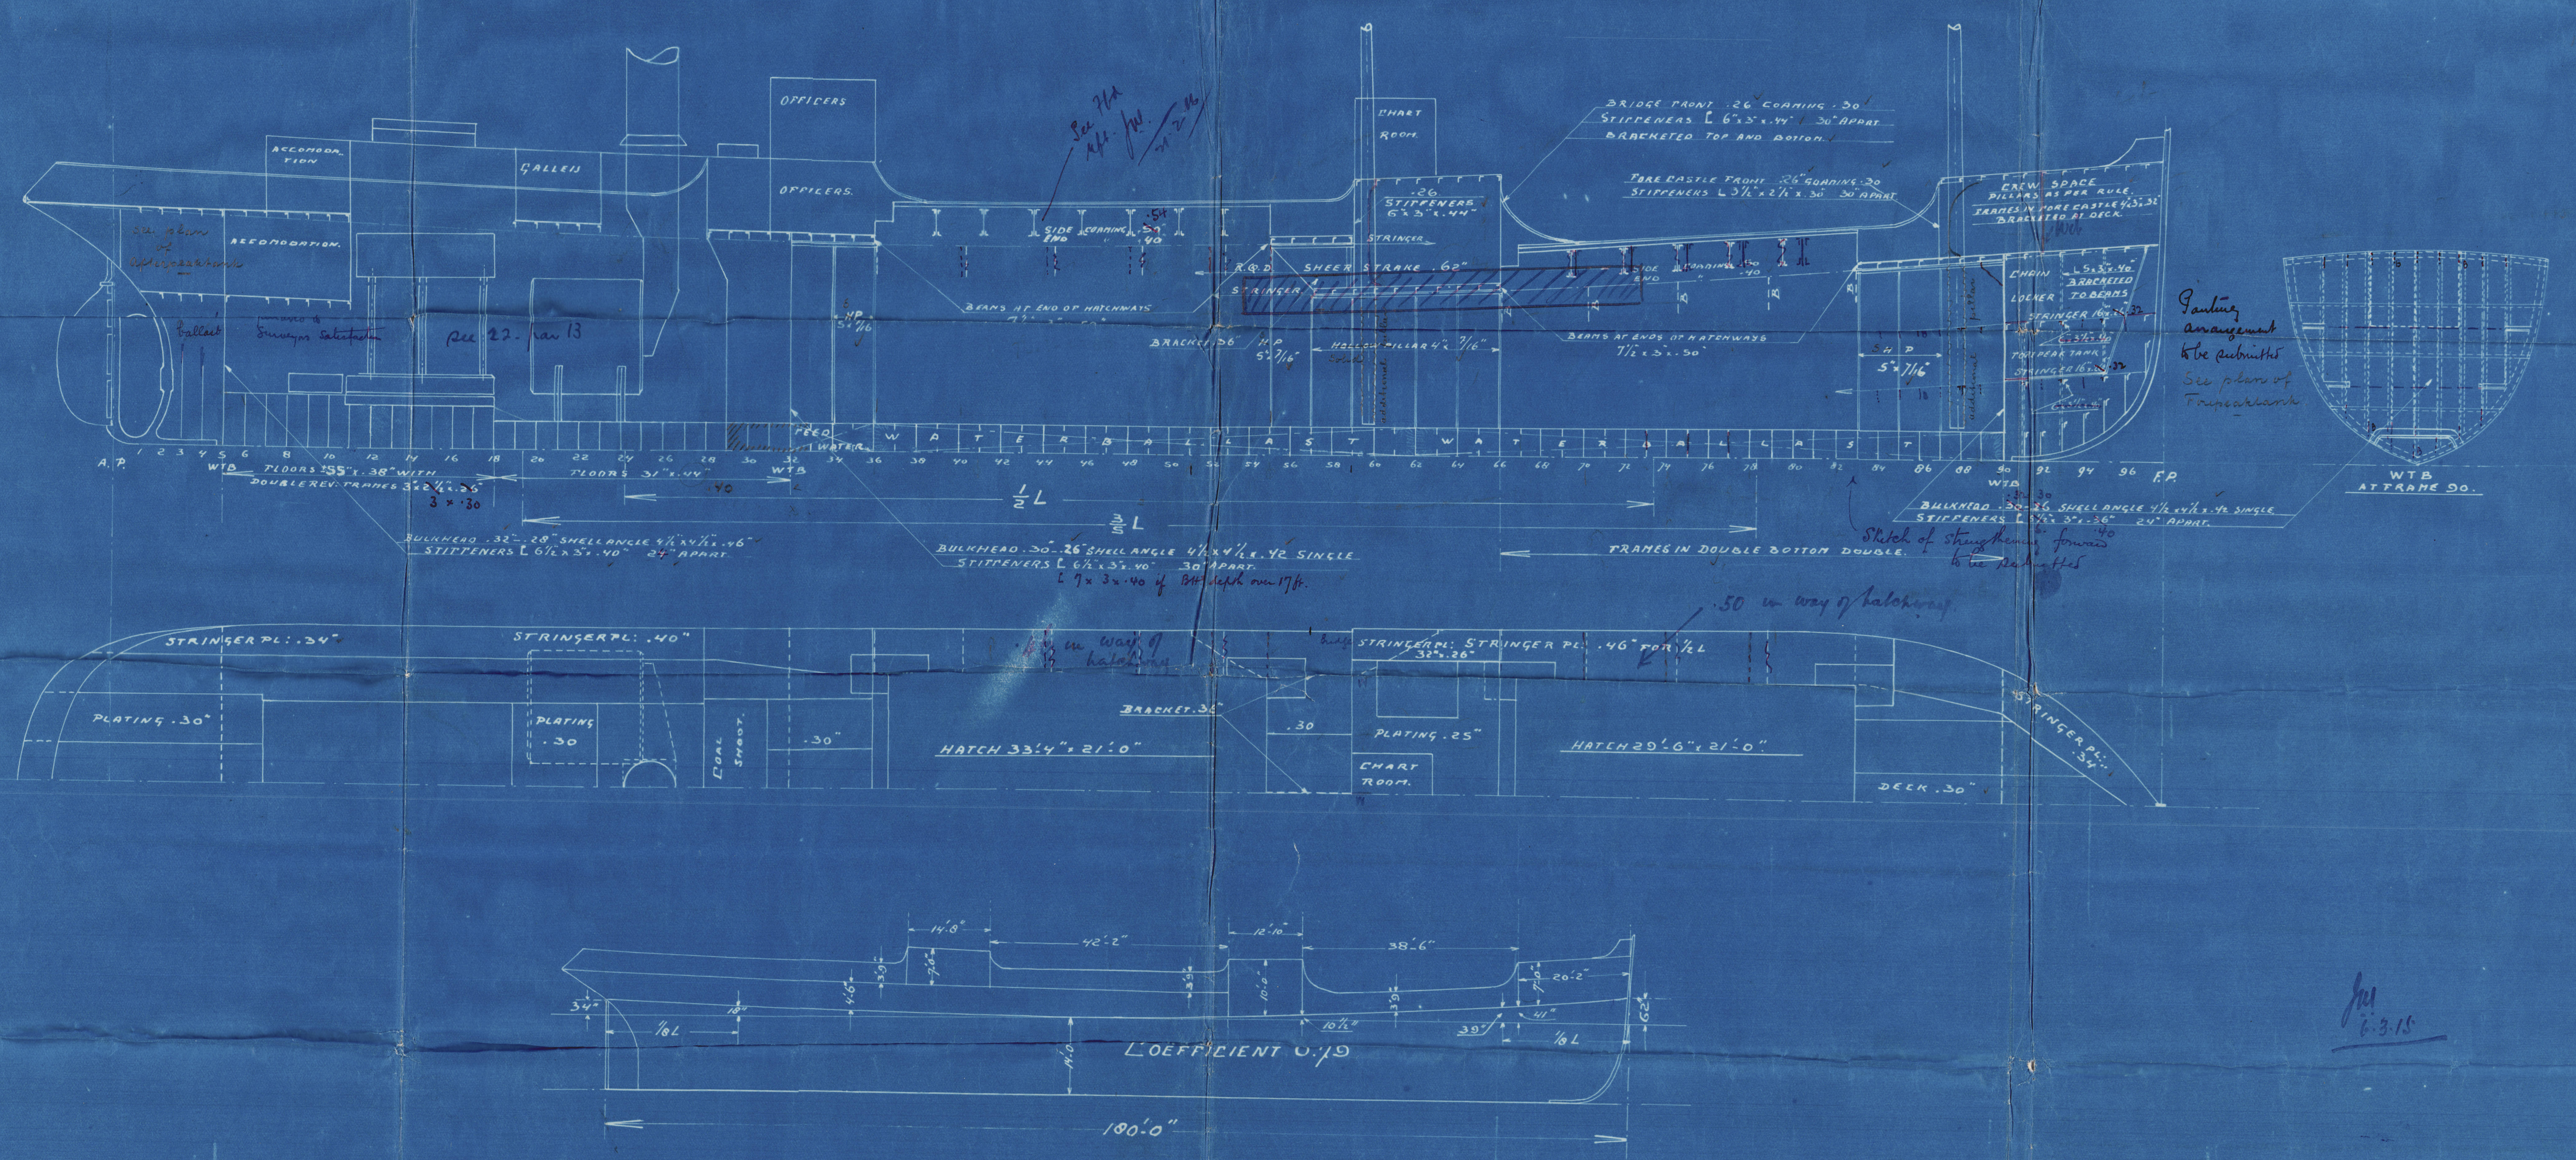


Painting  
arrangement  
to be submitted  
See plans of  
Transatlantic

6.3.15


16/  
3/2-15





S/s "Boekelo"

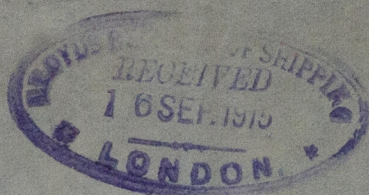

Profile and Deckplan

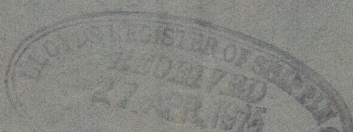

RETAIN

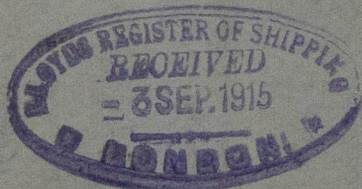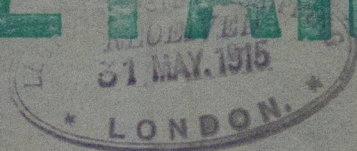

Rotterdam

Report No. 210028

W373 - 0109's Register  
Foundation