

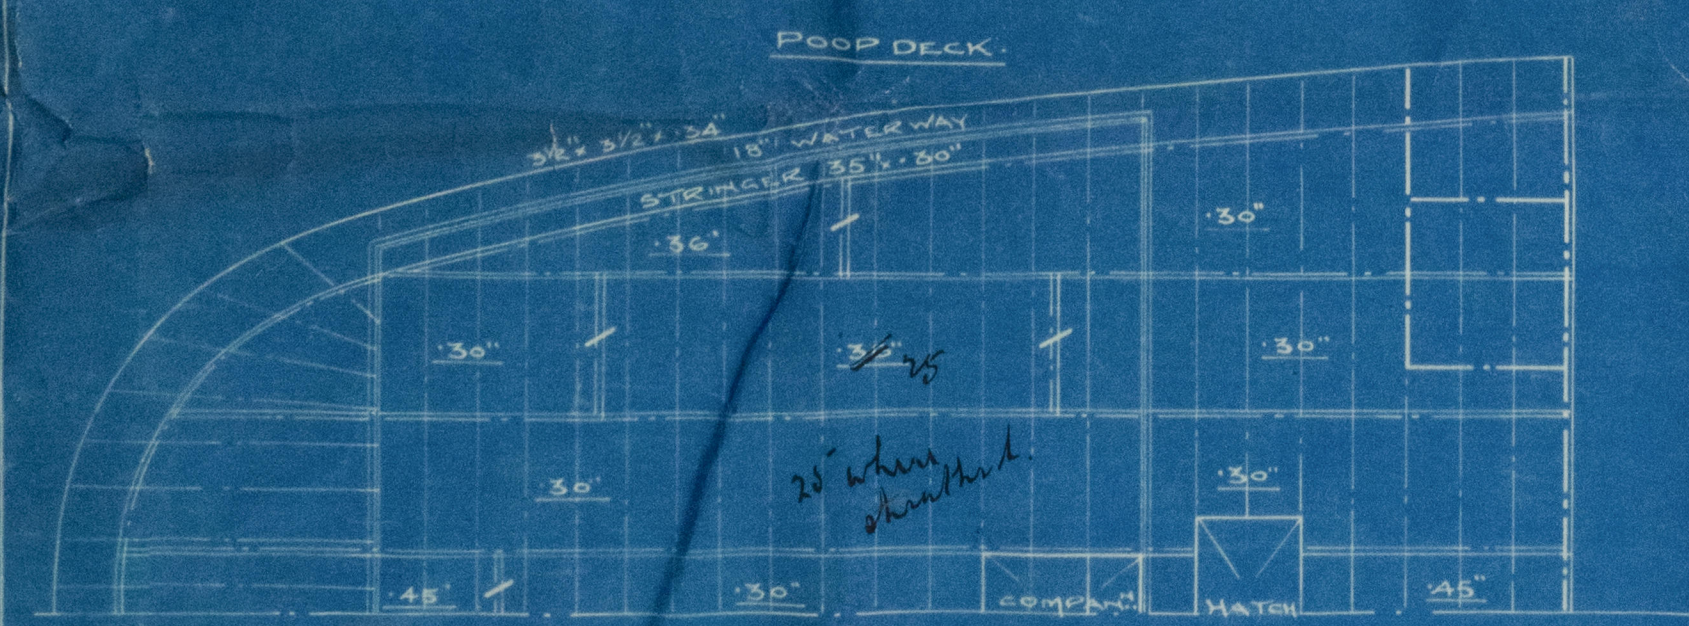




PROFILE AND DECK PLANS.
 DIMENSIONS 400' 0" x 52' 0" x 31' 0"
 TO CLASS 100A-1 LLOYDS REGISTER.
 SCALE 1/8" = 1' 0"

 

REINFORCING OF BULKHEADS IN WALLS.
 REINFORCING THRU BULKHEADS & LANDING OF STANCHIONS & THREE ADJACENT STANCHIONS
 SPACED AS PER RULE FOR PLATING 7/16" TO 5/8" THICKNESS.
 REINFORCING THRU STANCHIONS & DECK PLATING TO BEAM SPACED 5' 0" DIA. FOR
 7/16" TO 5/8" PLATING. RULE SPACING OF 7' 0" DIA. BELOW THIS.

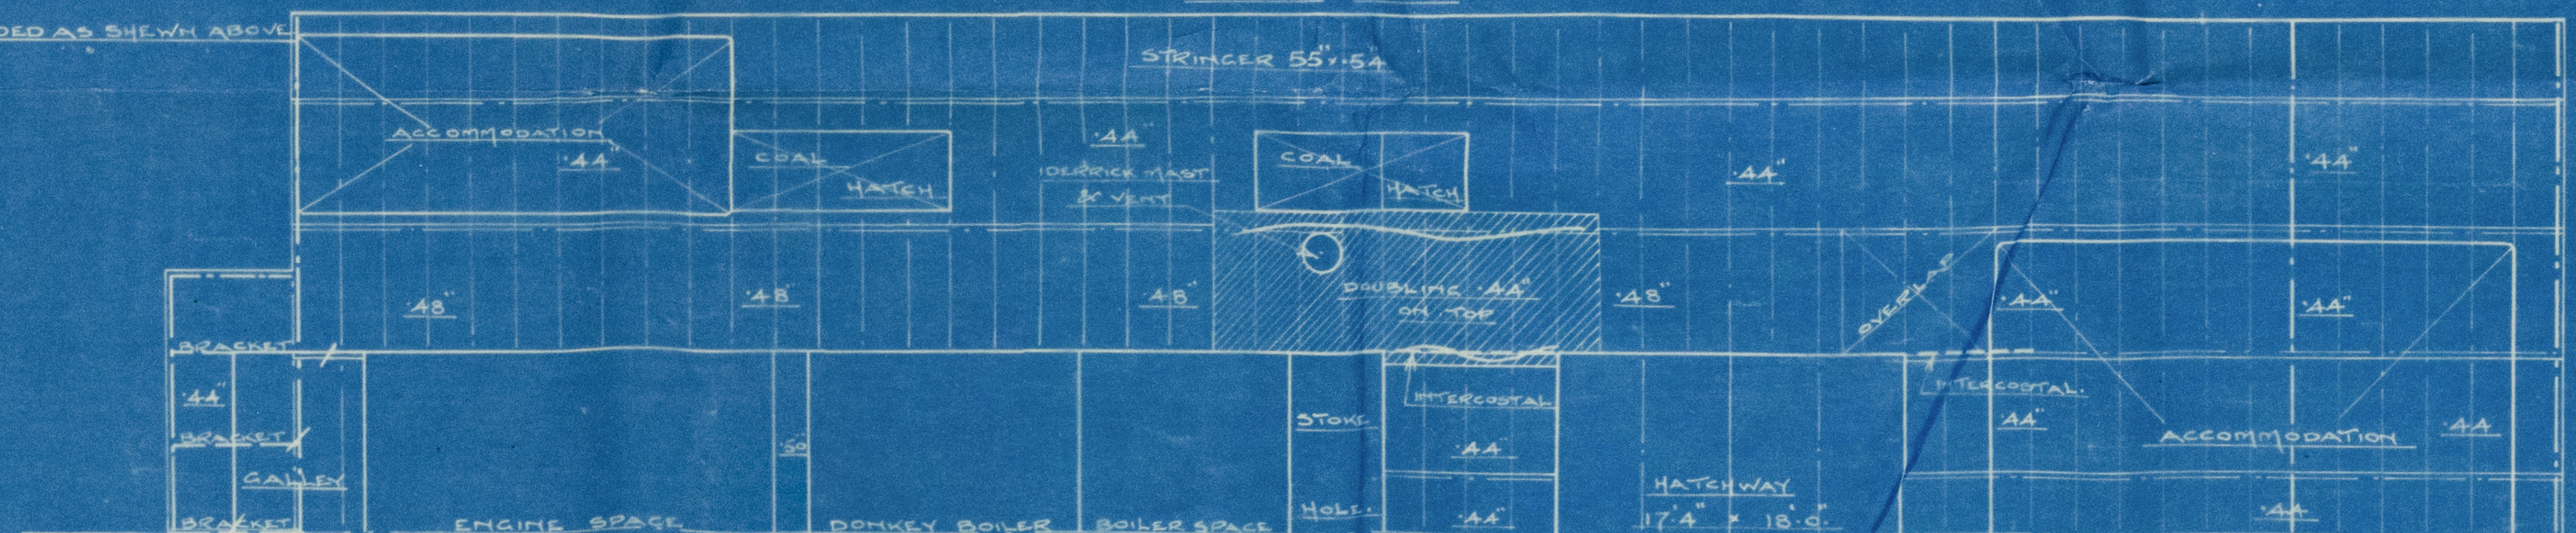

UPPER DECK STANCHIONS WITH ENCLAMPED RAILS OUTSIDE BRIDGE.
 WHERE ONLY ONE ENCLAMPED RAIL AT END.
 THERE STANCHION NEXT STANCHION OVERLAPPED RAIL TO BE IN WELLS.
 THE RAIL IN BRIDGE WELLS AT END.
 REMAINDER OF DECK BEING 2" THE RAIL TO BE AT END.
 BRIDGE DECK STANCHION BOTH Sides.

 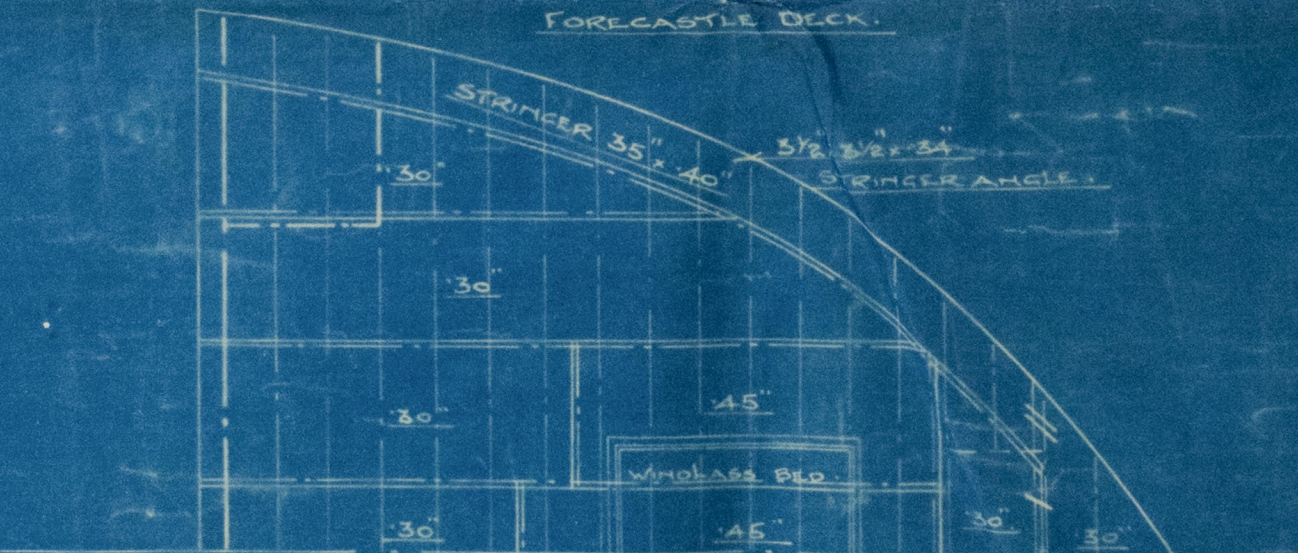

RICHARDSON DUCK & CO LTD
 SHIPBUILDERS.
 STOCKTON ON TEES.
 TRACING NO 6592
 1/10/19

677
 3.10.19
 W374-0040

Messrs Richardson Buck & Co^{ys} Ltd

No 677


Profile & Deck Plan

of "Clarton"

Mdb report No 10491

RETAIN

RETAIN

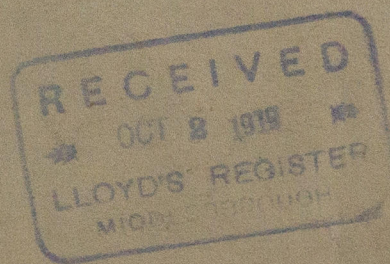

W374-0040



© 2020

Lloyd's Register
Foundation