



NOOT: VOOR DETAILS KNIEN ZIE DWARSSCHOTTEN.

APPROVED BY
[Signature]
 4, LLOYD AVENUE,
 LONDON, E.C. 3.
 DATE 27/4/36
[Signature]

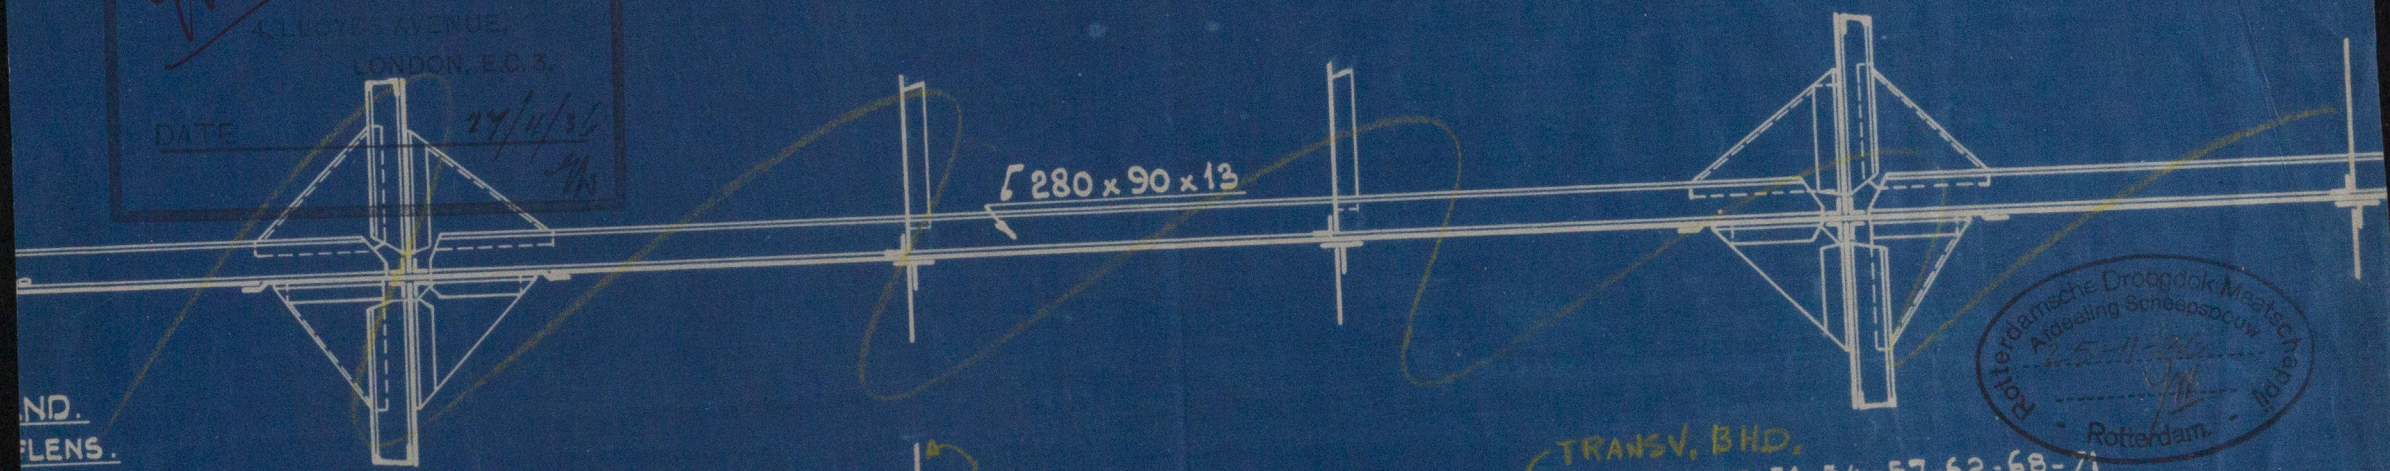

Rotterdamse Droogdok Maatschappij
 Afdeling Scheepscouw
 25-11-36
 Rotterdam


AT AFT END OF BHD. 51 ONLY.
 ALLEEN AAN ACHTERK. SCH. 51

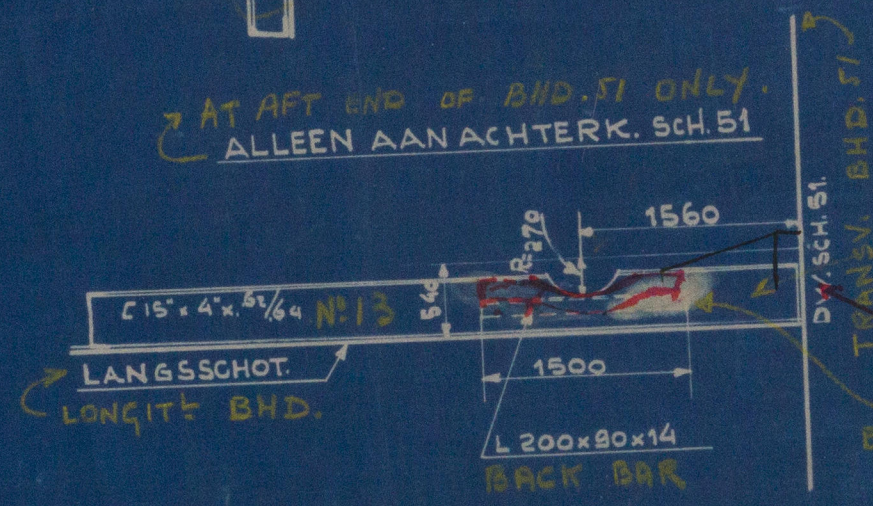

LONGIT. STIFFENER

Dbl. 1-6 legs
 in four trans. Bulkhead
 to land
 BACK BAR.

TRANSV. BHD.
 DWARSSCHOT 51-54-57-62-68-71

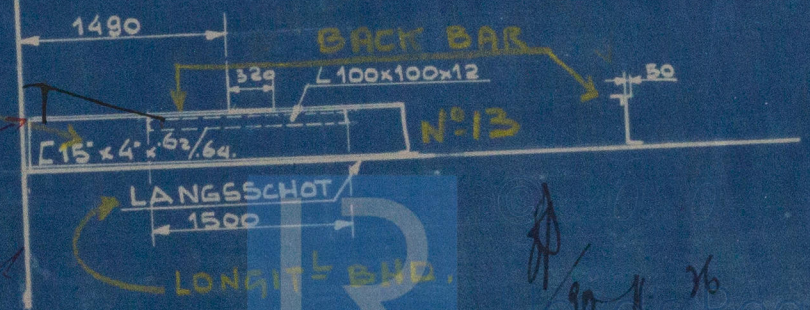

W374-0127

O.T. LONGITUDINAL BULKHEADS 197017

4

"CLEA".

Longitudinal

Lloyd's Register
Foundation

W374-0127