

# LONGITUDINAL SECTION. S.S. N<sup>o</sup> 143.

SCALE 1/8" = 1 FT.



DIMENSIONS: 245' O.B.P. x 36' 9" EXT x 18' 4" D.M.L.

144 x 145 x 146

"ATUL"  
S.E.M/M

18.11.07  
27.11.07  
3.2.08 (No 144)  
5.10.08 (No 145)  
11.11.08 (No 146)  
30.12.09

FRAMES SPACED 23' APART AND LONGER  
INCREASED IN SIZE IN LIEU OF EXTRA  
LONGER IN WAY OF RAISED OR DECK.

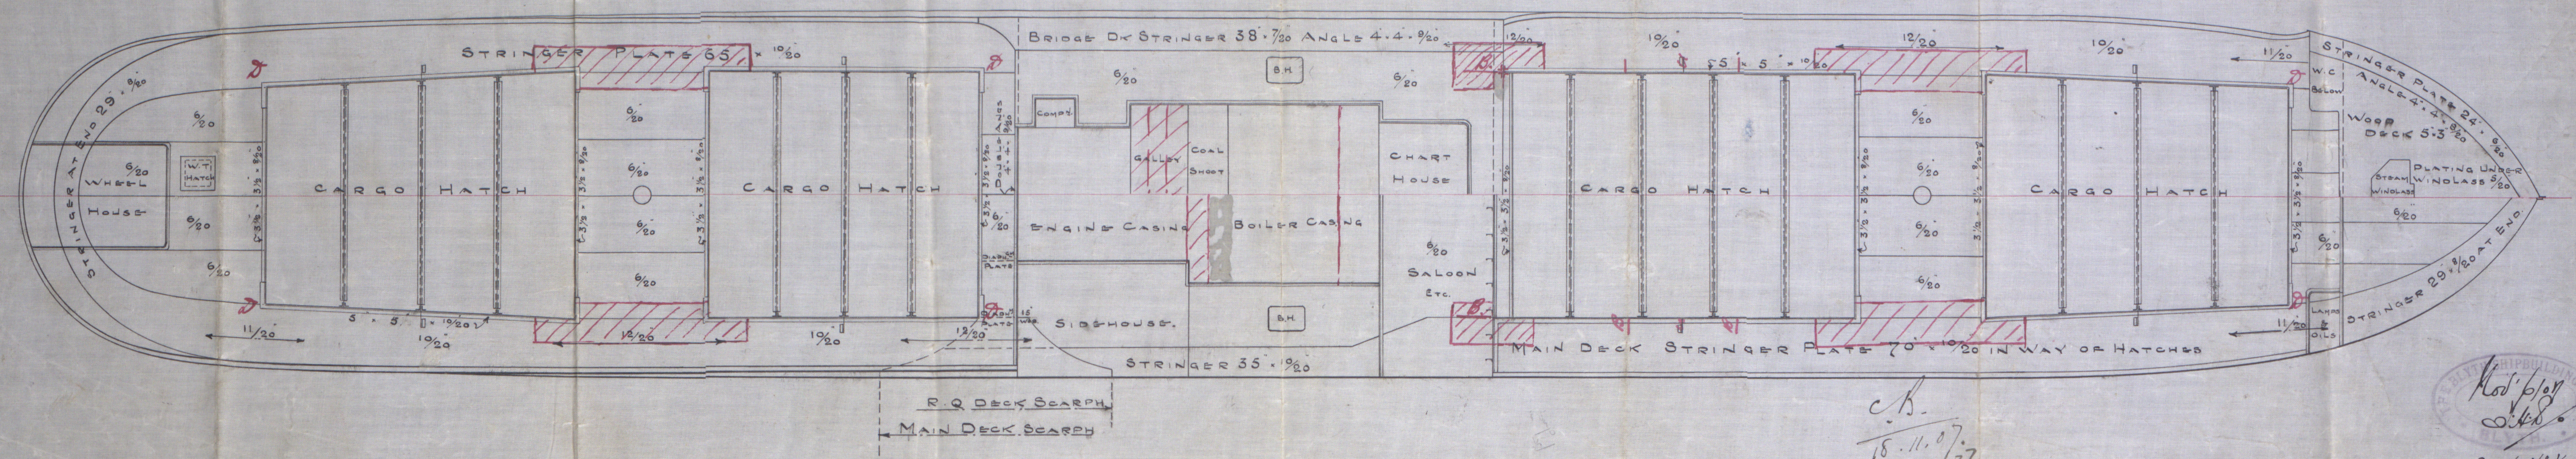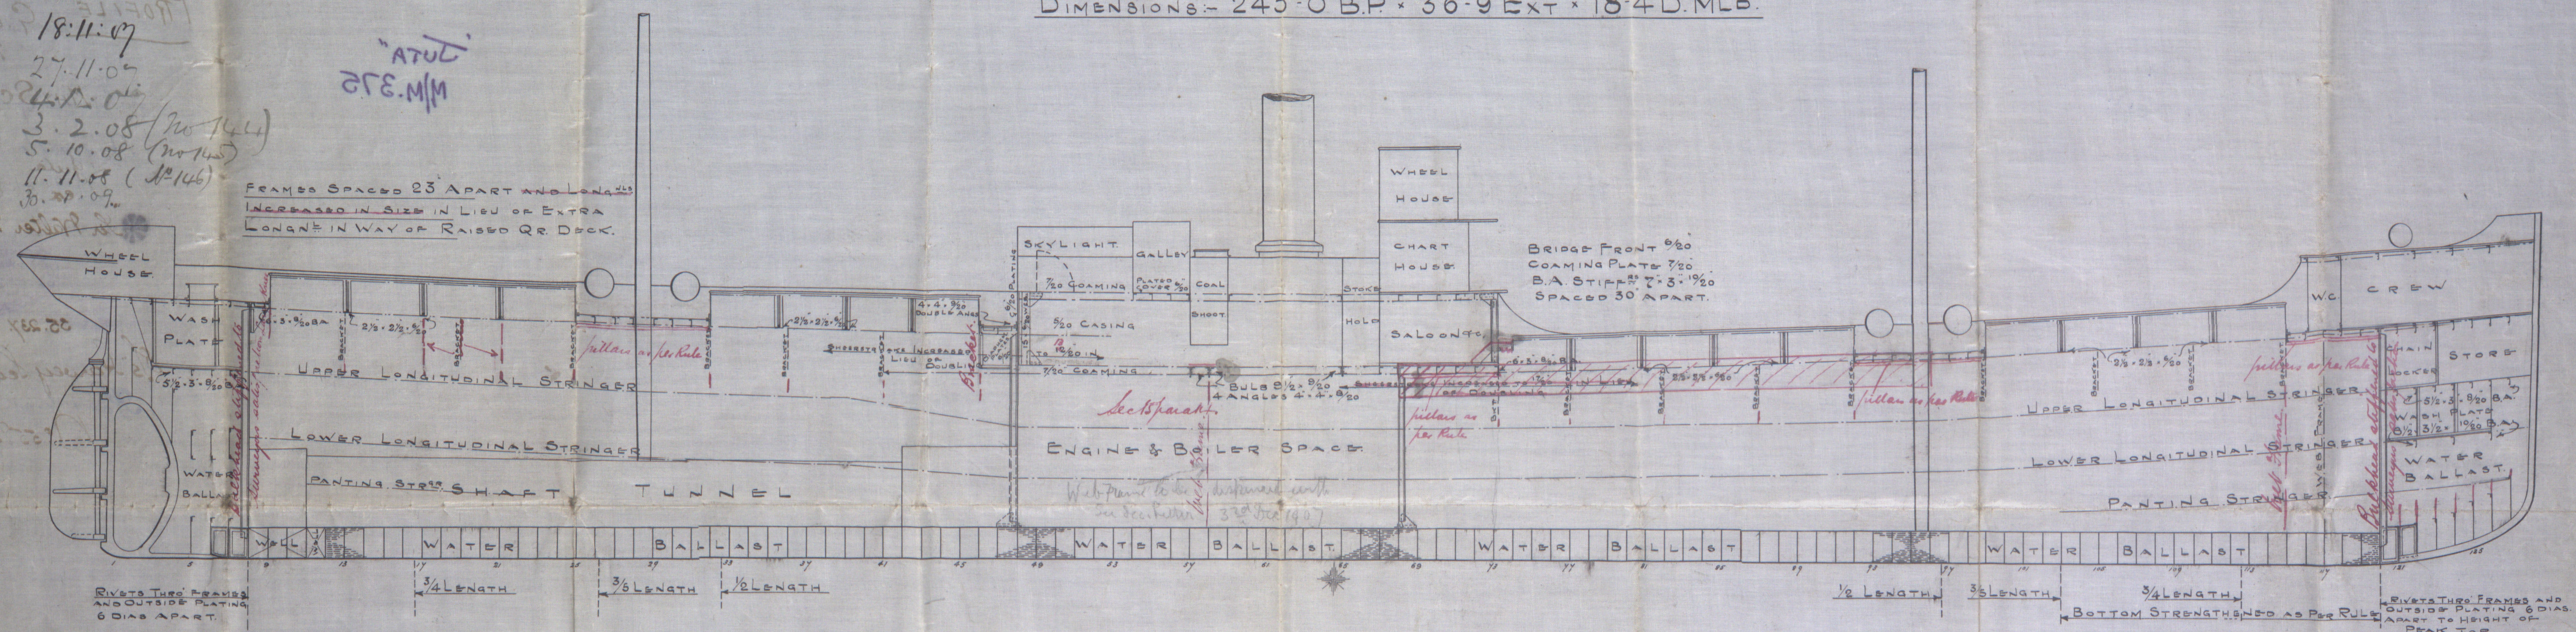

c.b.  
18.11.07  
27.11.07  
3.2.08

18.11.07  
27.11.07  
3.2.08



Newcastle-on-Tyne

Blyth Shipbuilding Co

S.S. No 14 3<sup>rd</sup> 4

PROFILE G.A.D.S. 15  
9-11-07 16

J.G. MAY Scott

Harvey Report  
Jula

ex 56810

✿ Sir Walter Scott.

35.237.

St. Harvey Scott


No 55853

Lloyd's Register  
Foundation



(145) Constantine

— hwe 57707.

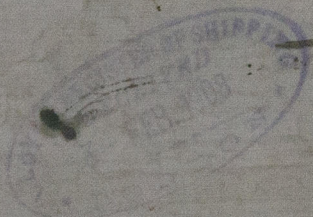

'JUTA'

M/M.375

RECEIVED 23 APRIL 1907  
INCREASED IN SIZE IN LIST OF EX-  
HIBITS IN WAY OF RAISED Q. D.



© 2020

Lloyd's Register  
Foundation