

S.S. No 143. ^{2144 2145 2146}

26.11.07
3.2.08 (144)
5.10.08 (2145)
11.11.08 (2146)

PROPOSED CAST STEEL
SCREW FRAME.

SCALE 1/2" = 1 FT.

HOLES 1 3/16 DIA SPACED 5 5/8" APART C & C.

PLATING No 17493.91

PROPOSED SINGLE-PLATE
RUDDER FORGING.



SCALE 1/2" = 1 FT.

HOLES 1 3/16 DIA. SPACED AS SHOWN AND
COUNTERSUNK ON OUTSIDE.



COUPLING
6 BOLTS 1 5/8" DIA.
1 3/4"

ENLARGED SKETCH OF ARM.

SCALE 1" = 1 FT.

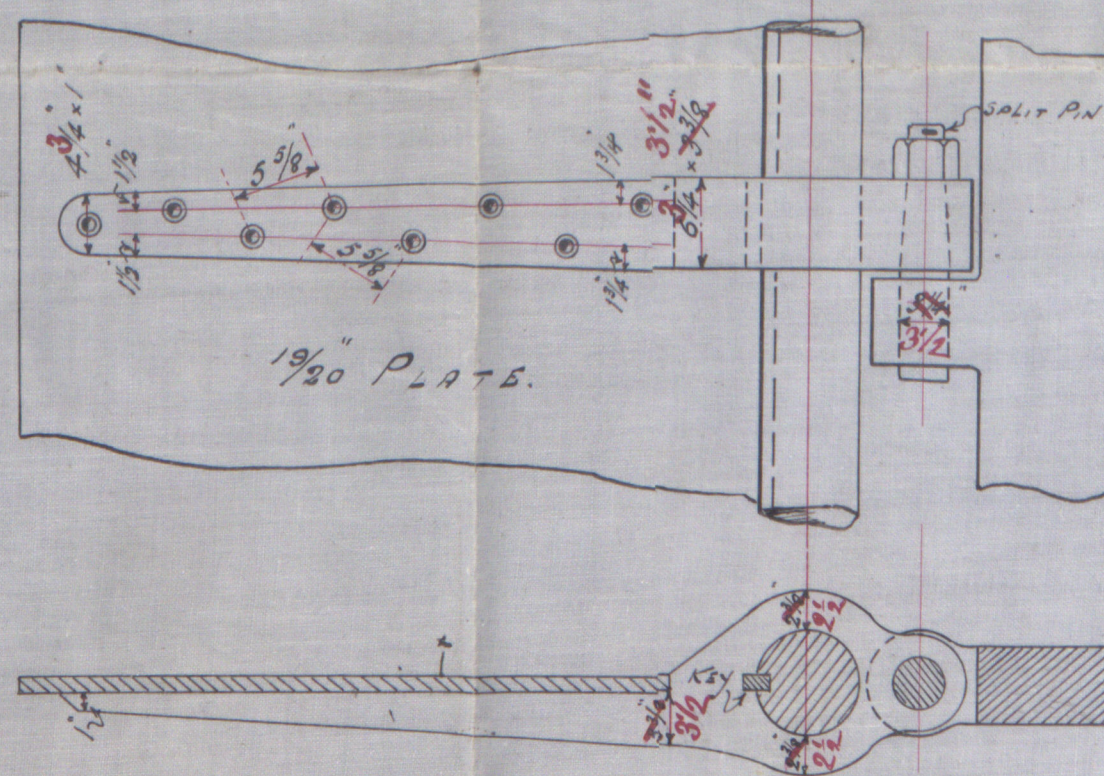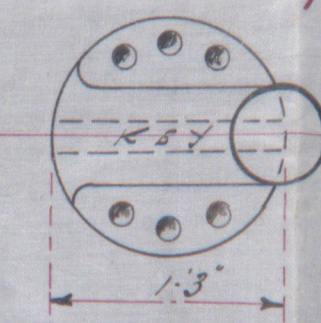

25' 9" EXT LENGTH

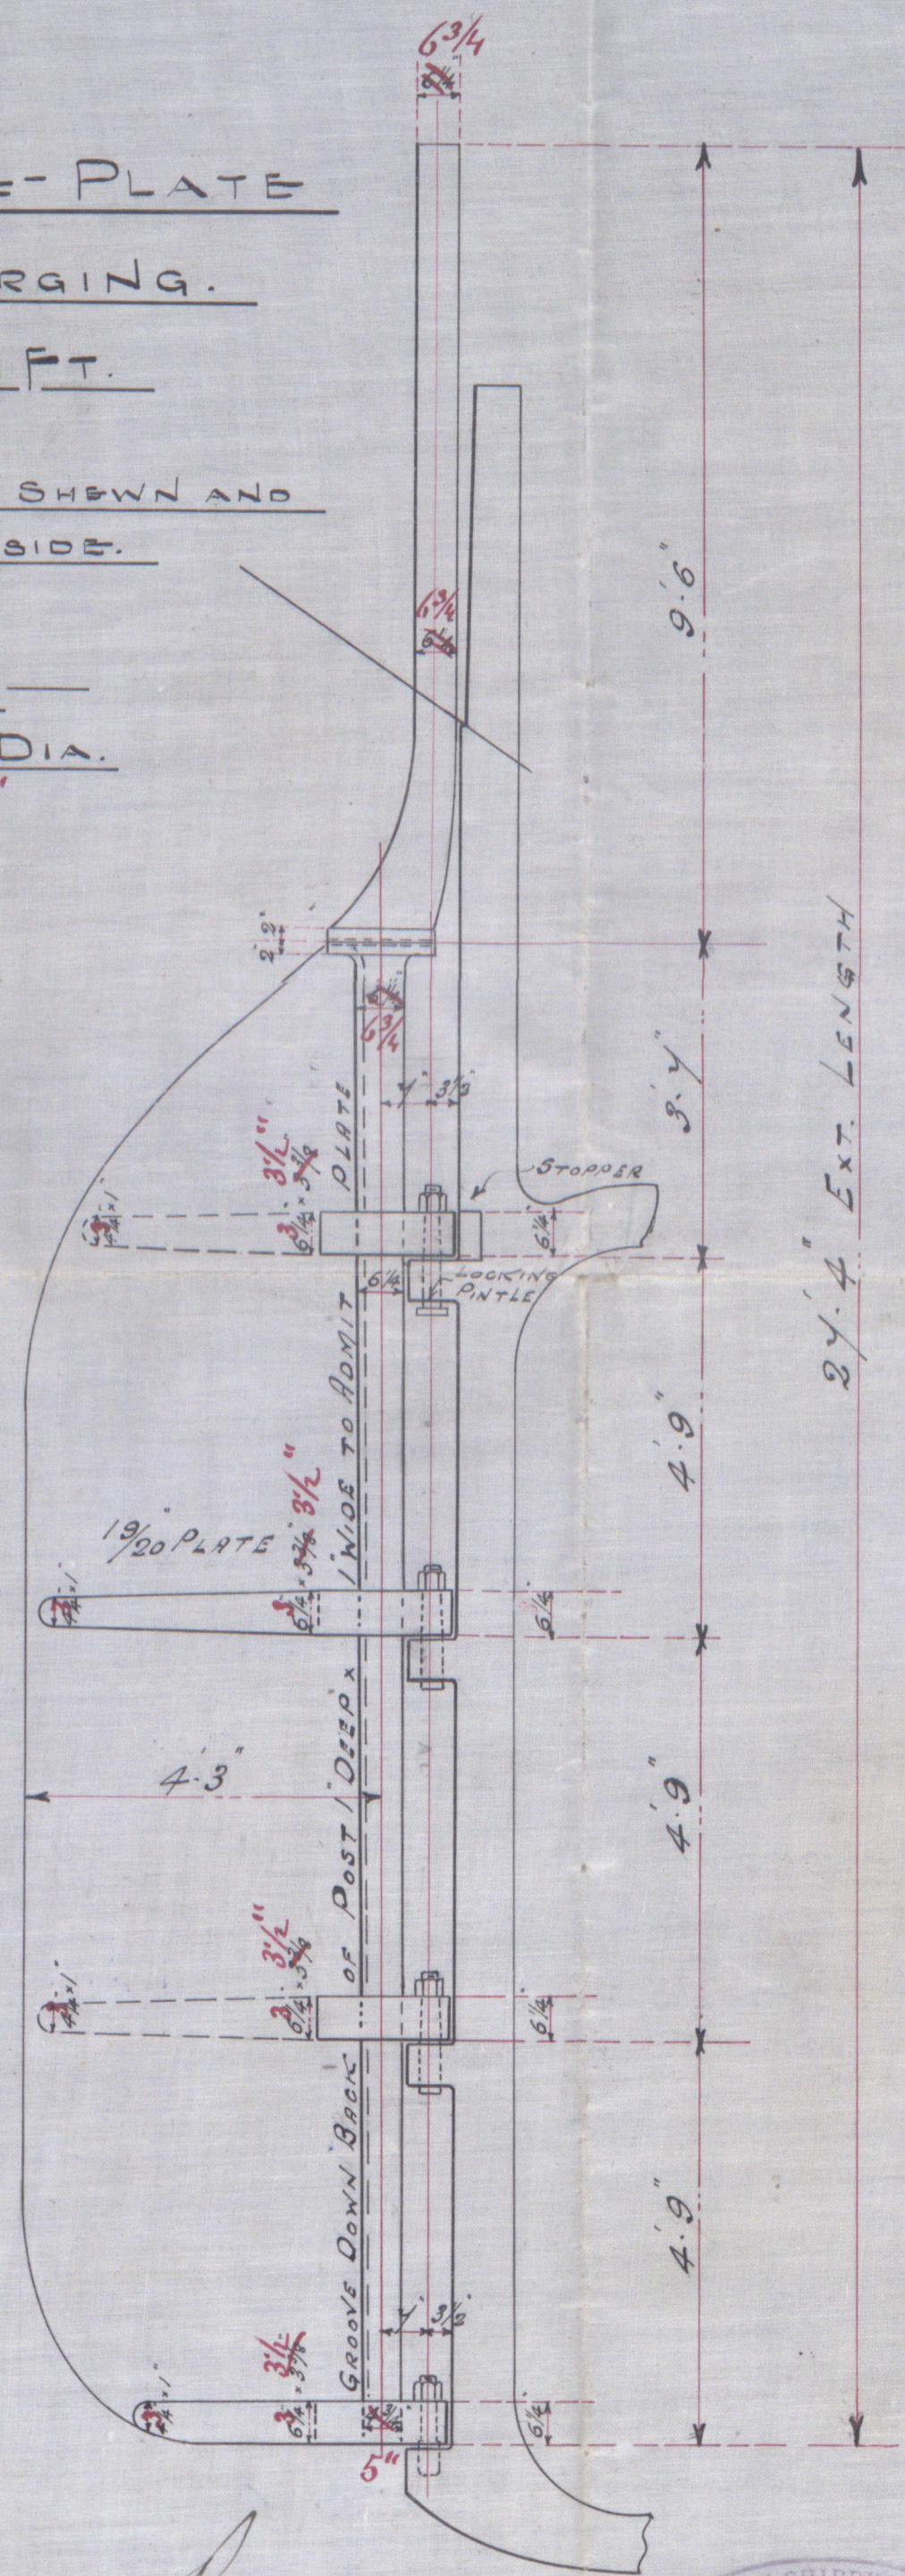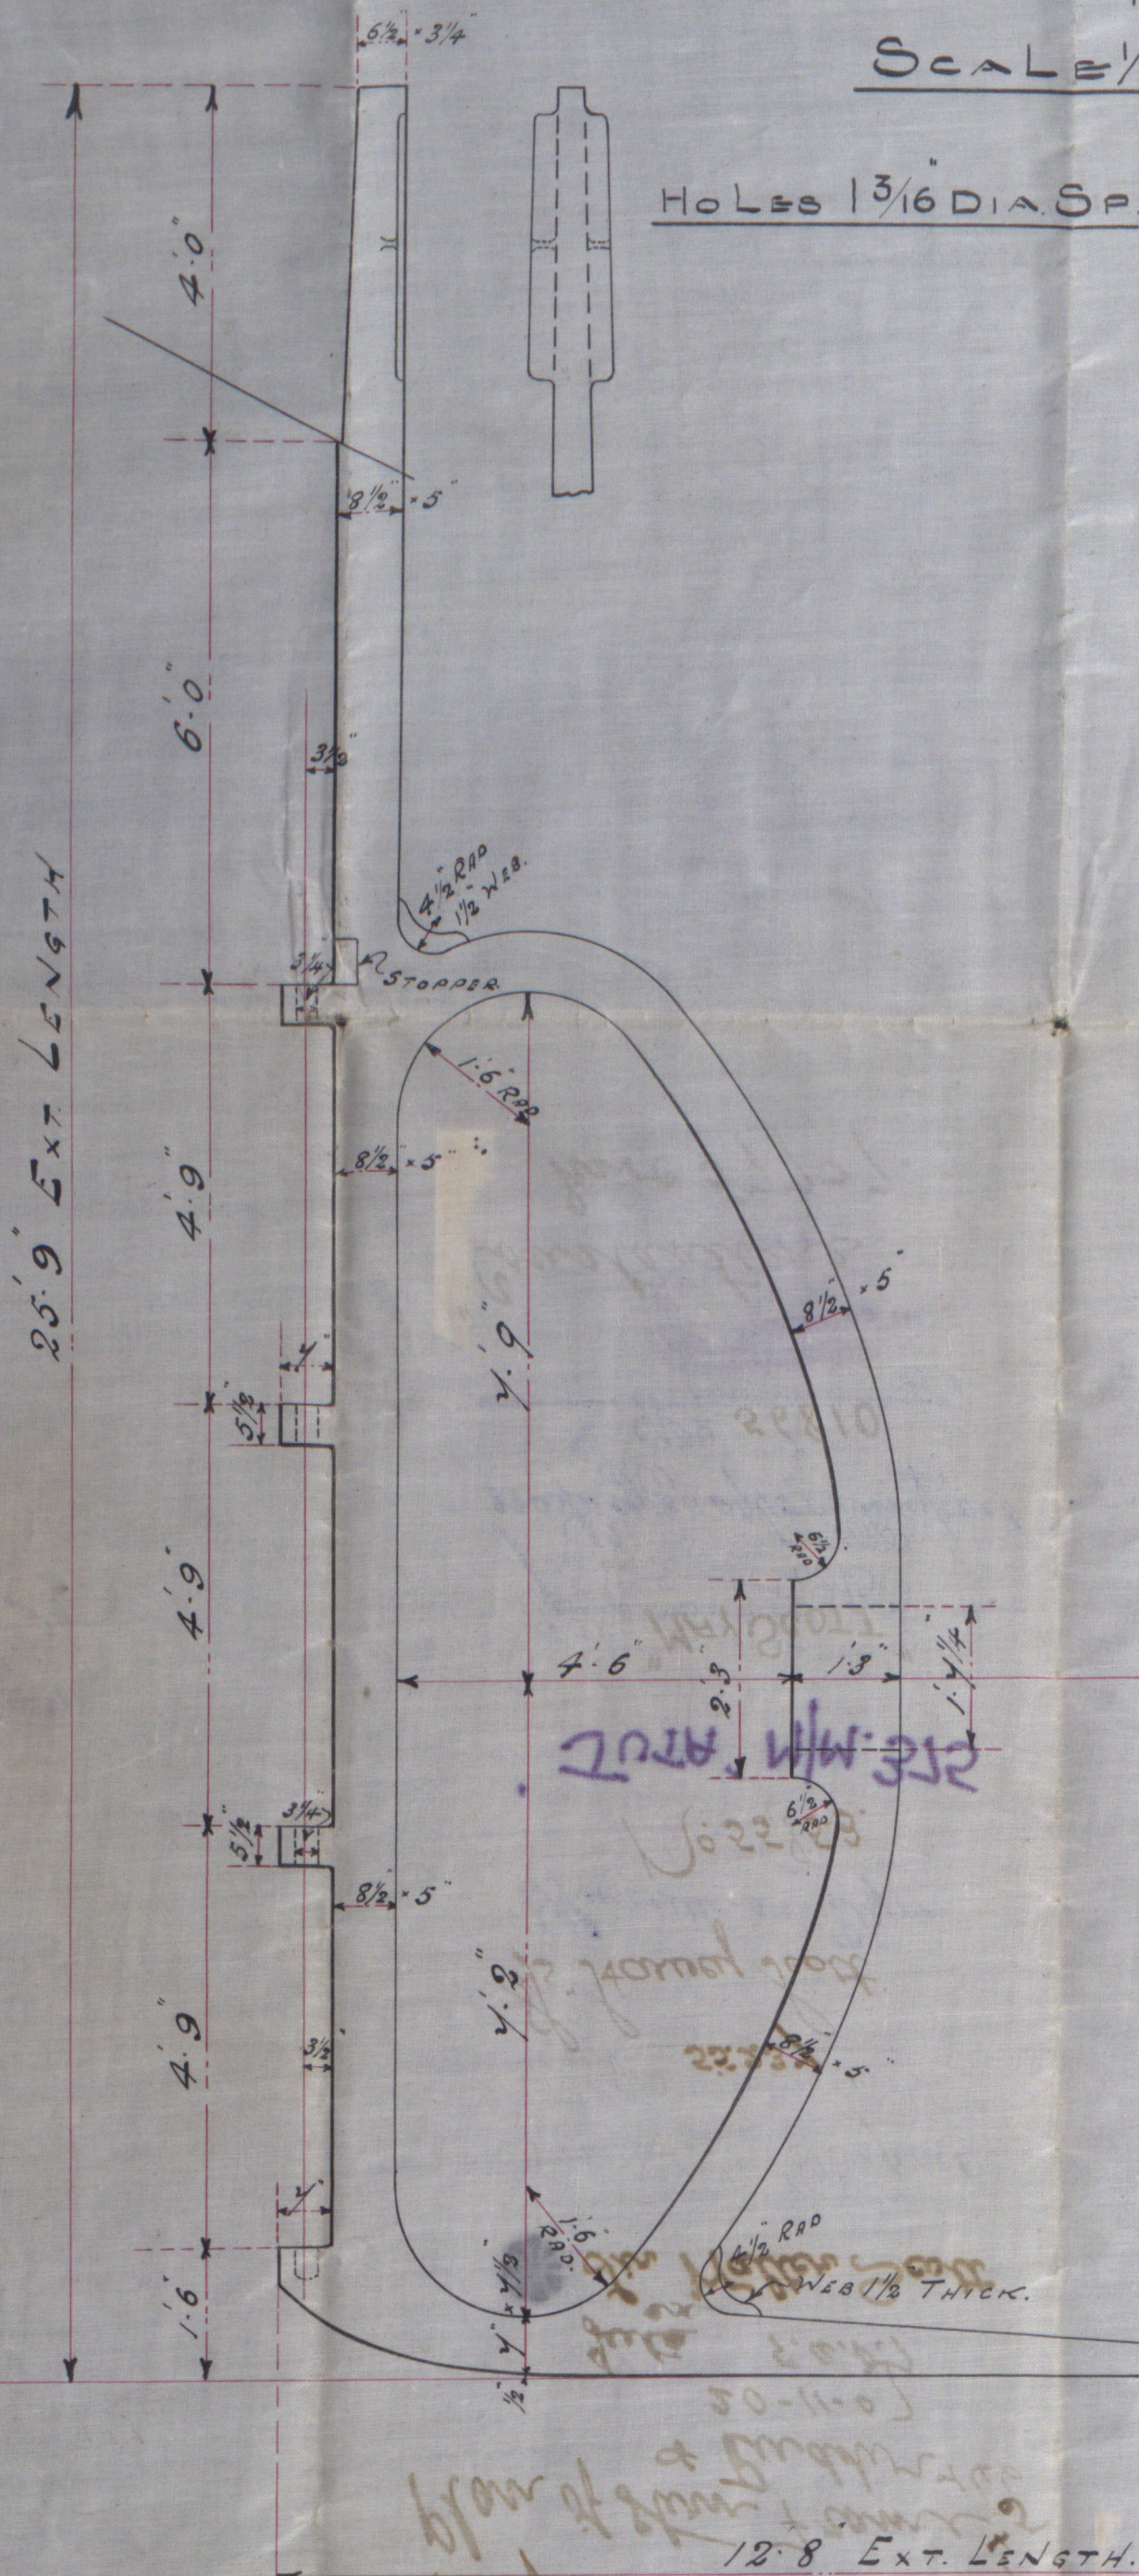

C.B.
3.2.08



Newcastle-on-Tyne

12lyth S.S. No 14 3x4
Plan of stern Frame
& Rudder 146

20-11-07

Juta S.C.D.

Sir Walter Scott

Newcastle Report

55237

S. Harvey Scott

Newcastle-on-Tyne

No 55853

JUTA M/M. 375

"MAY SCOTT"

Newcastle Report

56810

"Constantine"

Hoy's Register
Foundation