


R. Williamson & Son


S. S No 206 & my

Midship Section

New Rpt. 1314

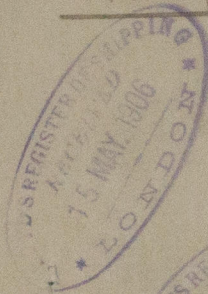


"VOLPONE"

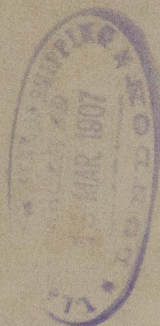

Continental

Coaster n/a

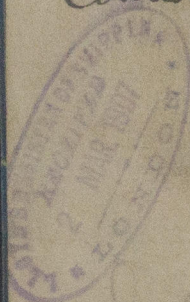

RETAIN

RETAIN

WME



©2019

Lloyd's Register
Foundation

W374-0155