


31.12.32

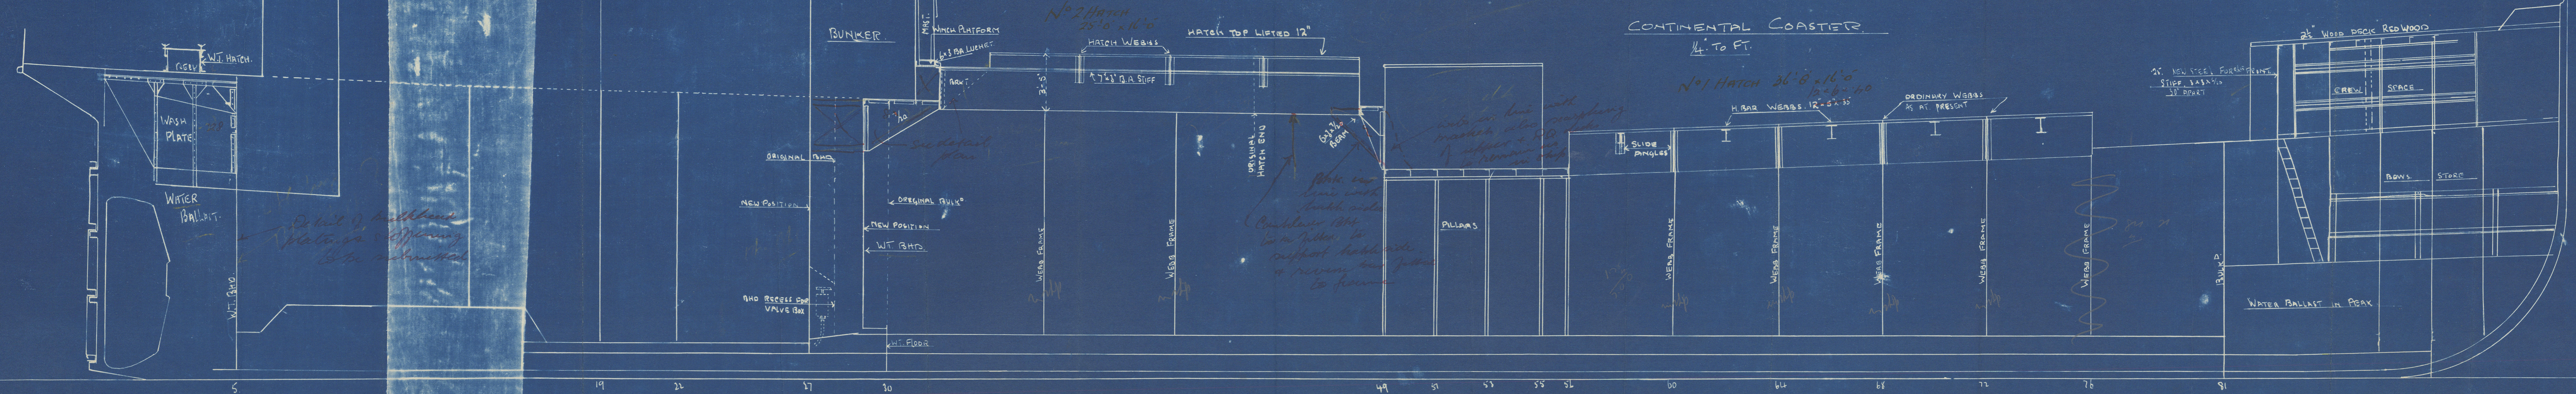

31.12.32

HULL

Continental Coaster

boxed with
Hul rept. No. 43467.

from ship 183
Profile plan (Alternations)

to be returned to Hull
RETAIN

18/11/32 to 15/2/33

W377-0157

RETAIN



© 2019

Lloyd's Register
Foundation