

26.3.19.
5.5.19.

S.S. N° 485-6-89

MIDSHIP SECTION

SCALE 1/4" = 1 FOOT

DIMENSIONS - 105' 0" B.P. x 53' 3" B.M. x 78' 0" DEPT. UPPER DECK
TO CLYSS 100' 11" ANNING DECK AT LLOYD'S SURVEY

NUMERALS

B = 53.25
D = 78.00
1st Number = 81.25
2nd Number = 52906

PROPORTIONS

1/2 = 11.75
1/4 = 5.875


EQUIPMENT NUMERALS

BOS = 81.25
ANNING DECK 3/4 (100 x 8)
ALL DECKHOUSE 3/4 (100 x 7.5)
MIDSHIP SIDE HULLS 1/4 (100 x 1.5)
SALOON HOUSE 1/4 (100 x 1.5)
FORECASTLE DECK 1/4 (100 x 1.5)
DECKHOUSE AT FORECASTLE (100 x 1.5)
MAIN 1/4 (100 x 1.5)



EQUIPMENT

2 BUNKER ANCHORS EACH 65% CWT. STEELLESS
1 BUNKER ANCHOR 65% CWT.
1 STEEL ANCHOR 110% CWT. 1 x 1000
1 KNUCKLE ANCHOR 75% CWT. 1 x 1000
20 TANKS 2" TO 3" DIA. CHAIN CABLE
50 1" DIA. STEEL NIPS
20 3/4" DIA. S.M. TONNAGE
20 3/4" DIA. HANDS & MARKS
20 3/4" DIA.

SECTION IN WAY OF PACKET FLOORS

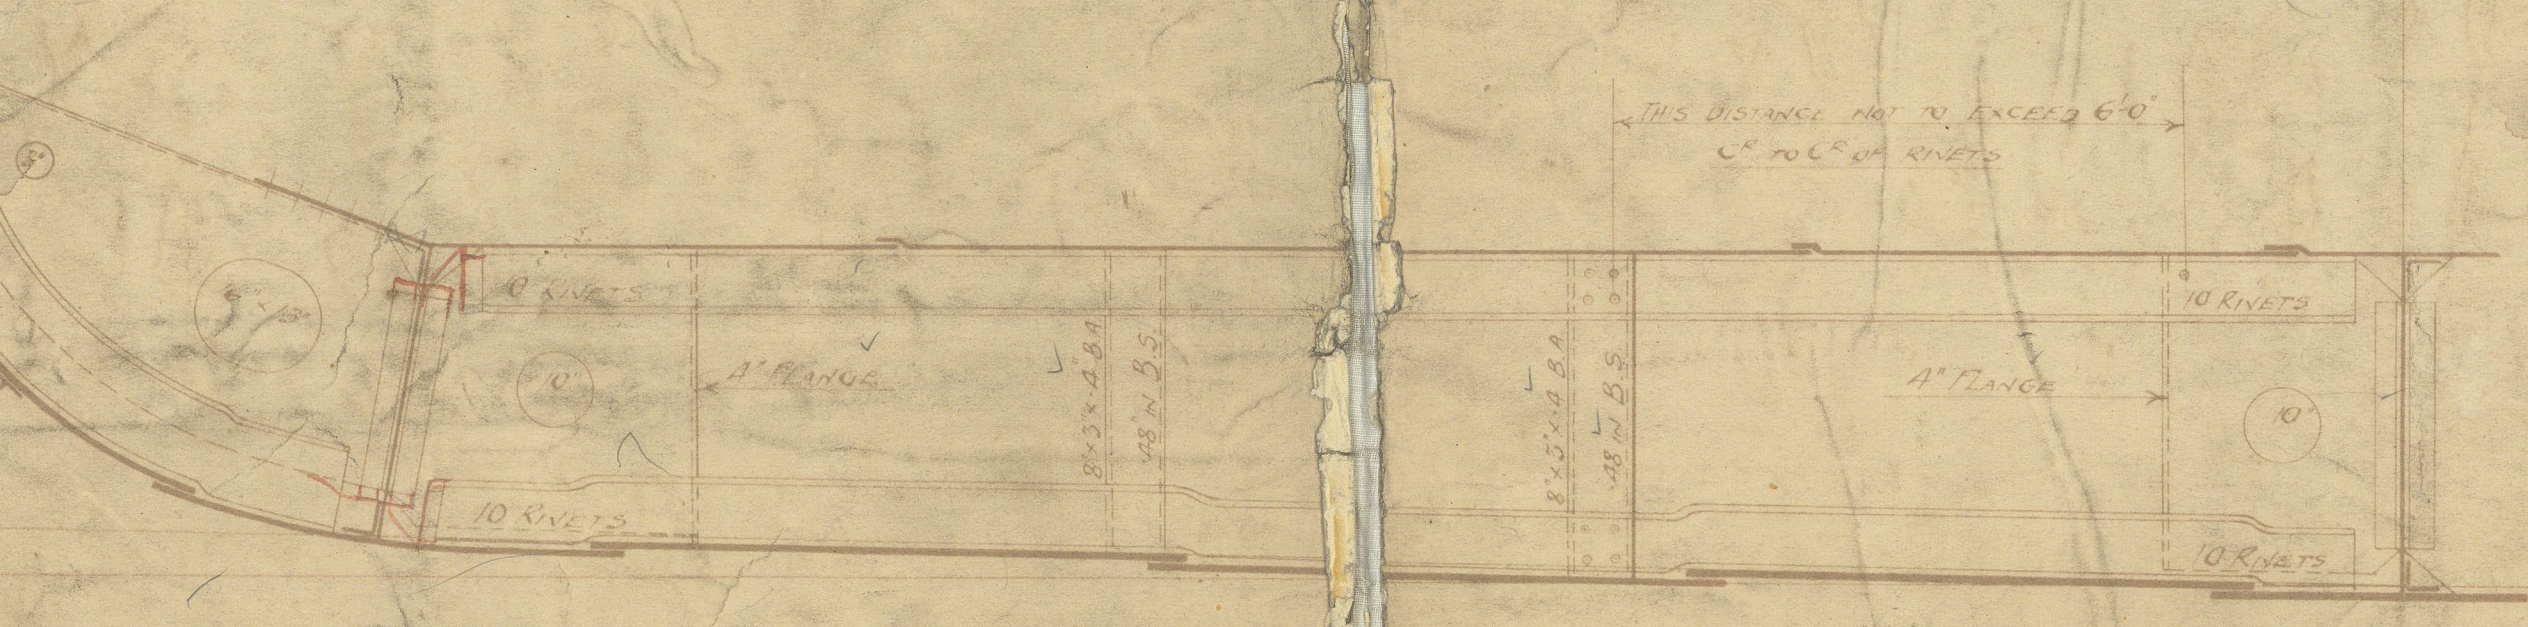

SECTION THRU MACHINERY SPACE

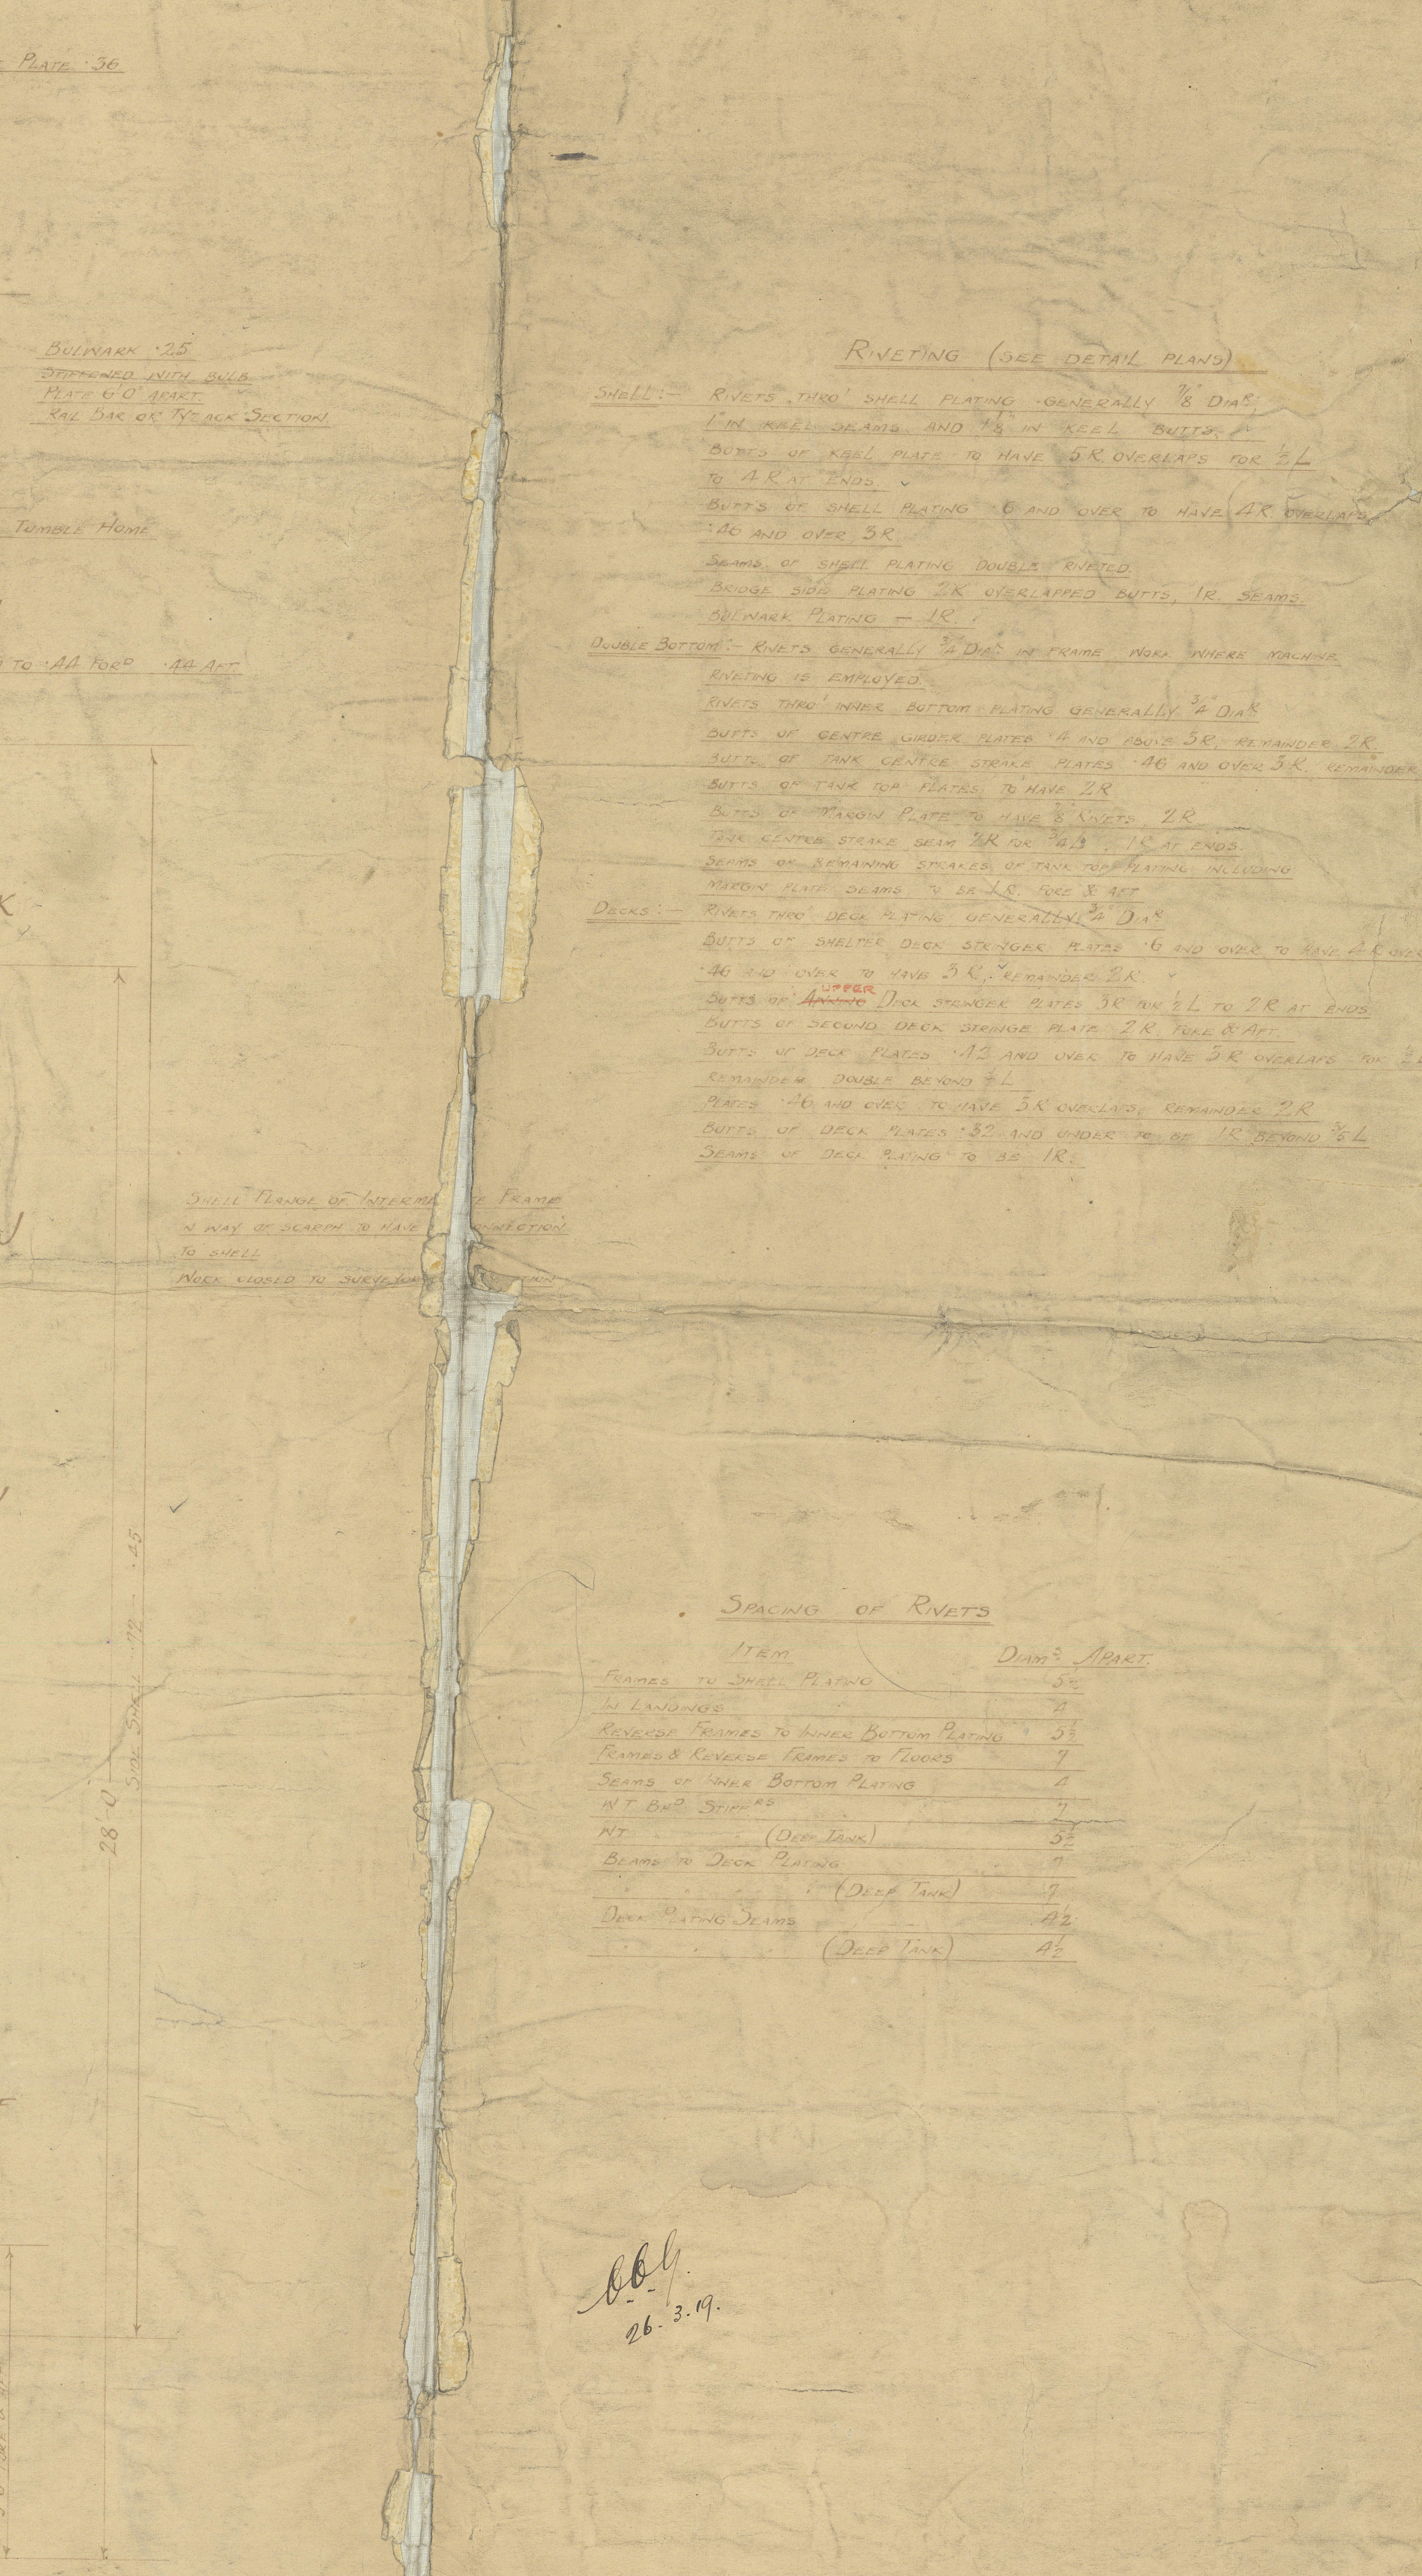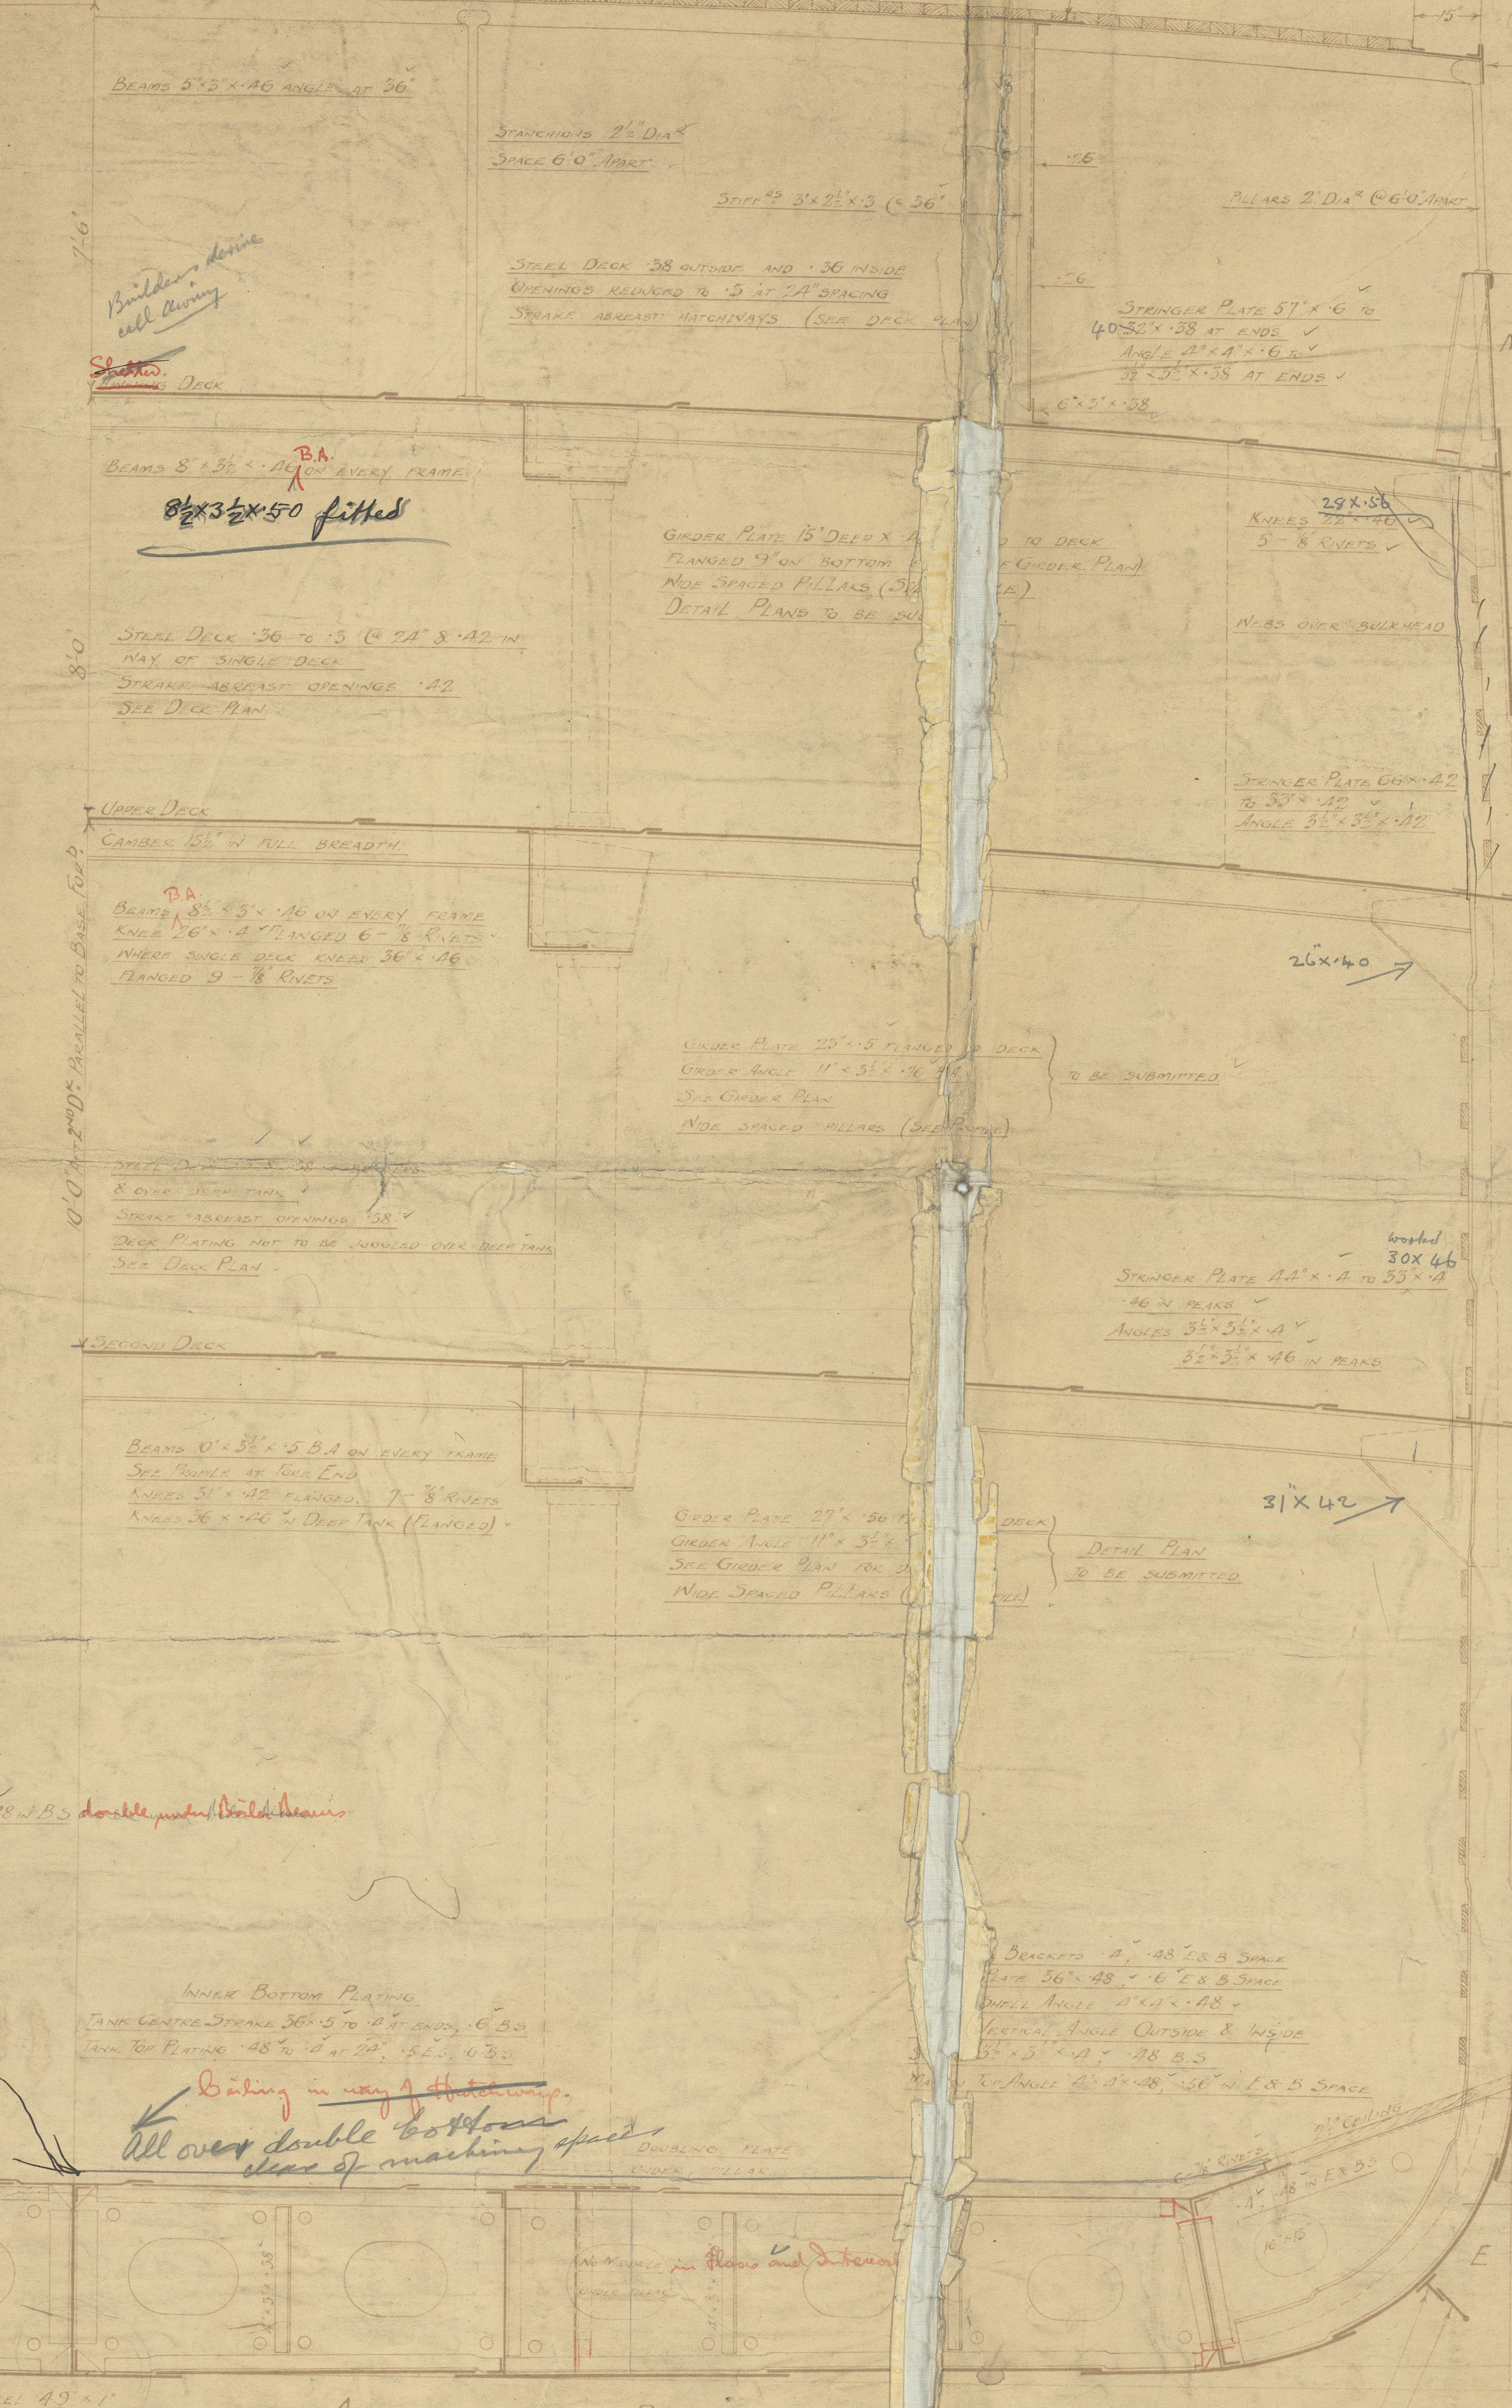

26.3.19.

RIVETING (SEE DETAIL PLANS)


SPACING OF RIVETS

RETAIN

Ayrshire Dockyard Co

Wos

485-6-8-9

Original Approved Midships Section

(See plan of modification to side framing)

No 485 - Isblars Macnab

No 486

Alan Macneil

GLASGOW REPORT No.

41481

No 489.

Alan Macneil

GLASGOW REPORT No.

41706



© 2019

Lloyd's Register
Foundation

W377-0304