


PEAK FLOORS 40  
IR LAP ON BA. FRAME

SCANTLINGS x DETAIL OF CONSTRUCTION NOTED HEREON  
ARE SUBMITTED ON THE UNDERSTANDING THAT THEY ARE  
THE MINIMUM WHICH WILL BE ACCEPTED FOR CLASS, ERRORS  
AND OMISSIONS EXCEPTED.

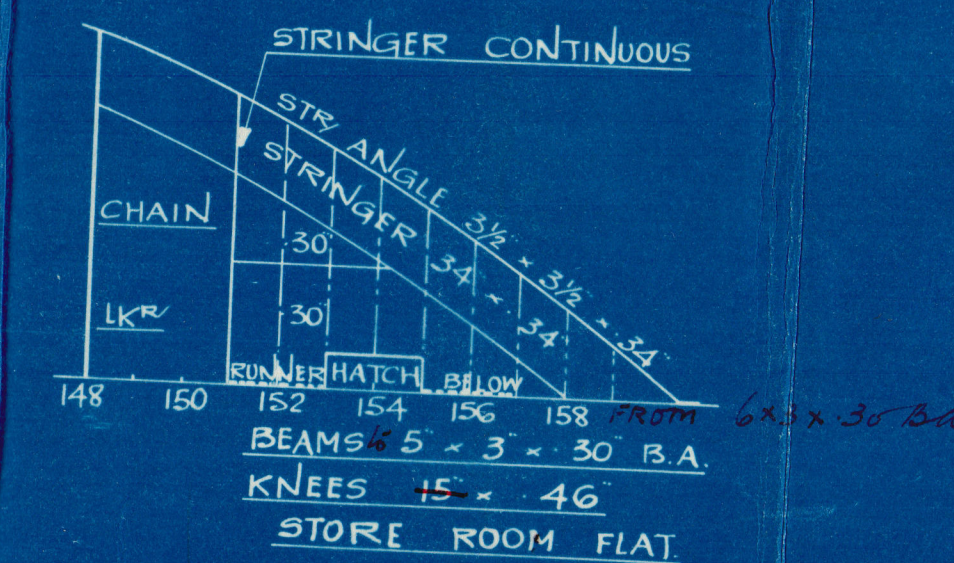



2

LITHGOWS LIP

Nº 913

PROFILE AND  
DECKS ✓

S. S. COULTARN

GRK. 1<sup>ST</sup> ENTRY REPORT Nº 20634

RETAIN

RETAIN

38-08  
18-08

W379-0093



© 2020

Lloyd's Register