



NOTE: ALL COUPLING BOLT HOLES TO BE BORED ACCURATELY ON GIVEN PITCH WITH TWO HOLES IN CRANK PIN & AS SHOWN

Looking Forward

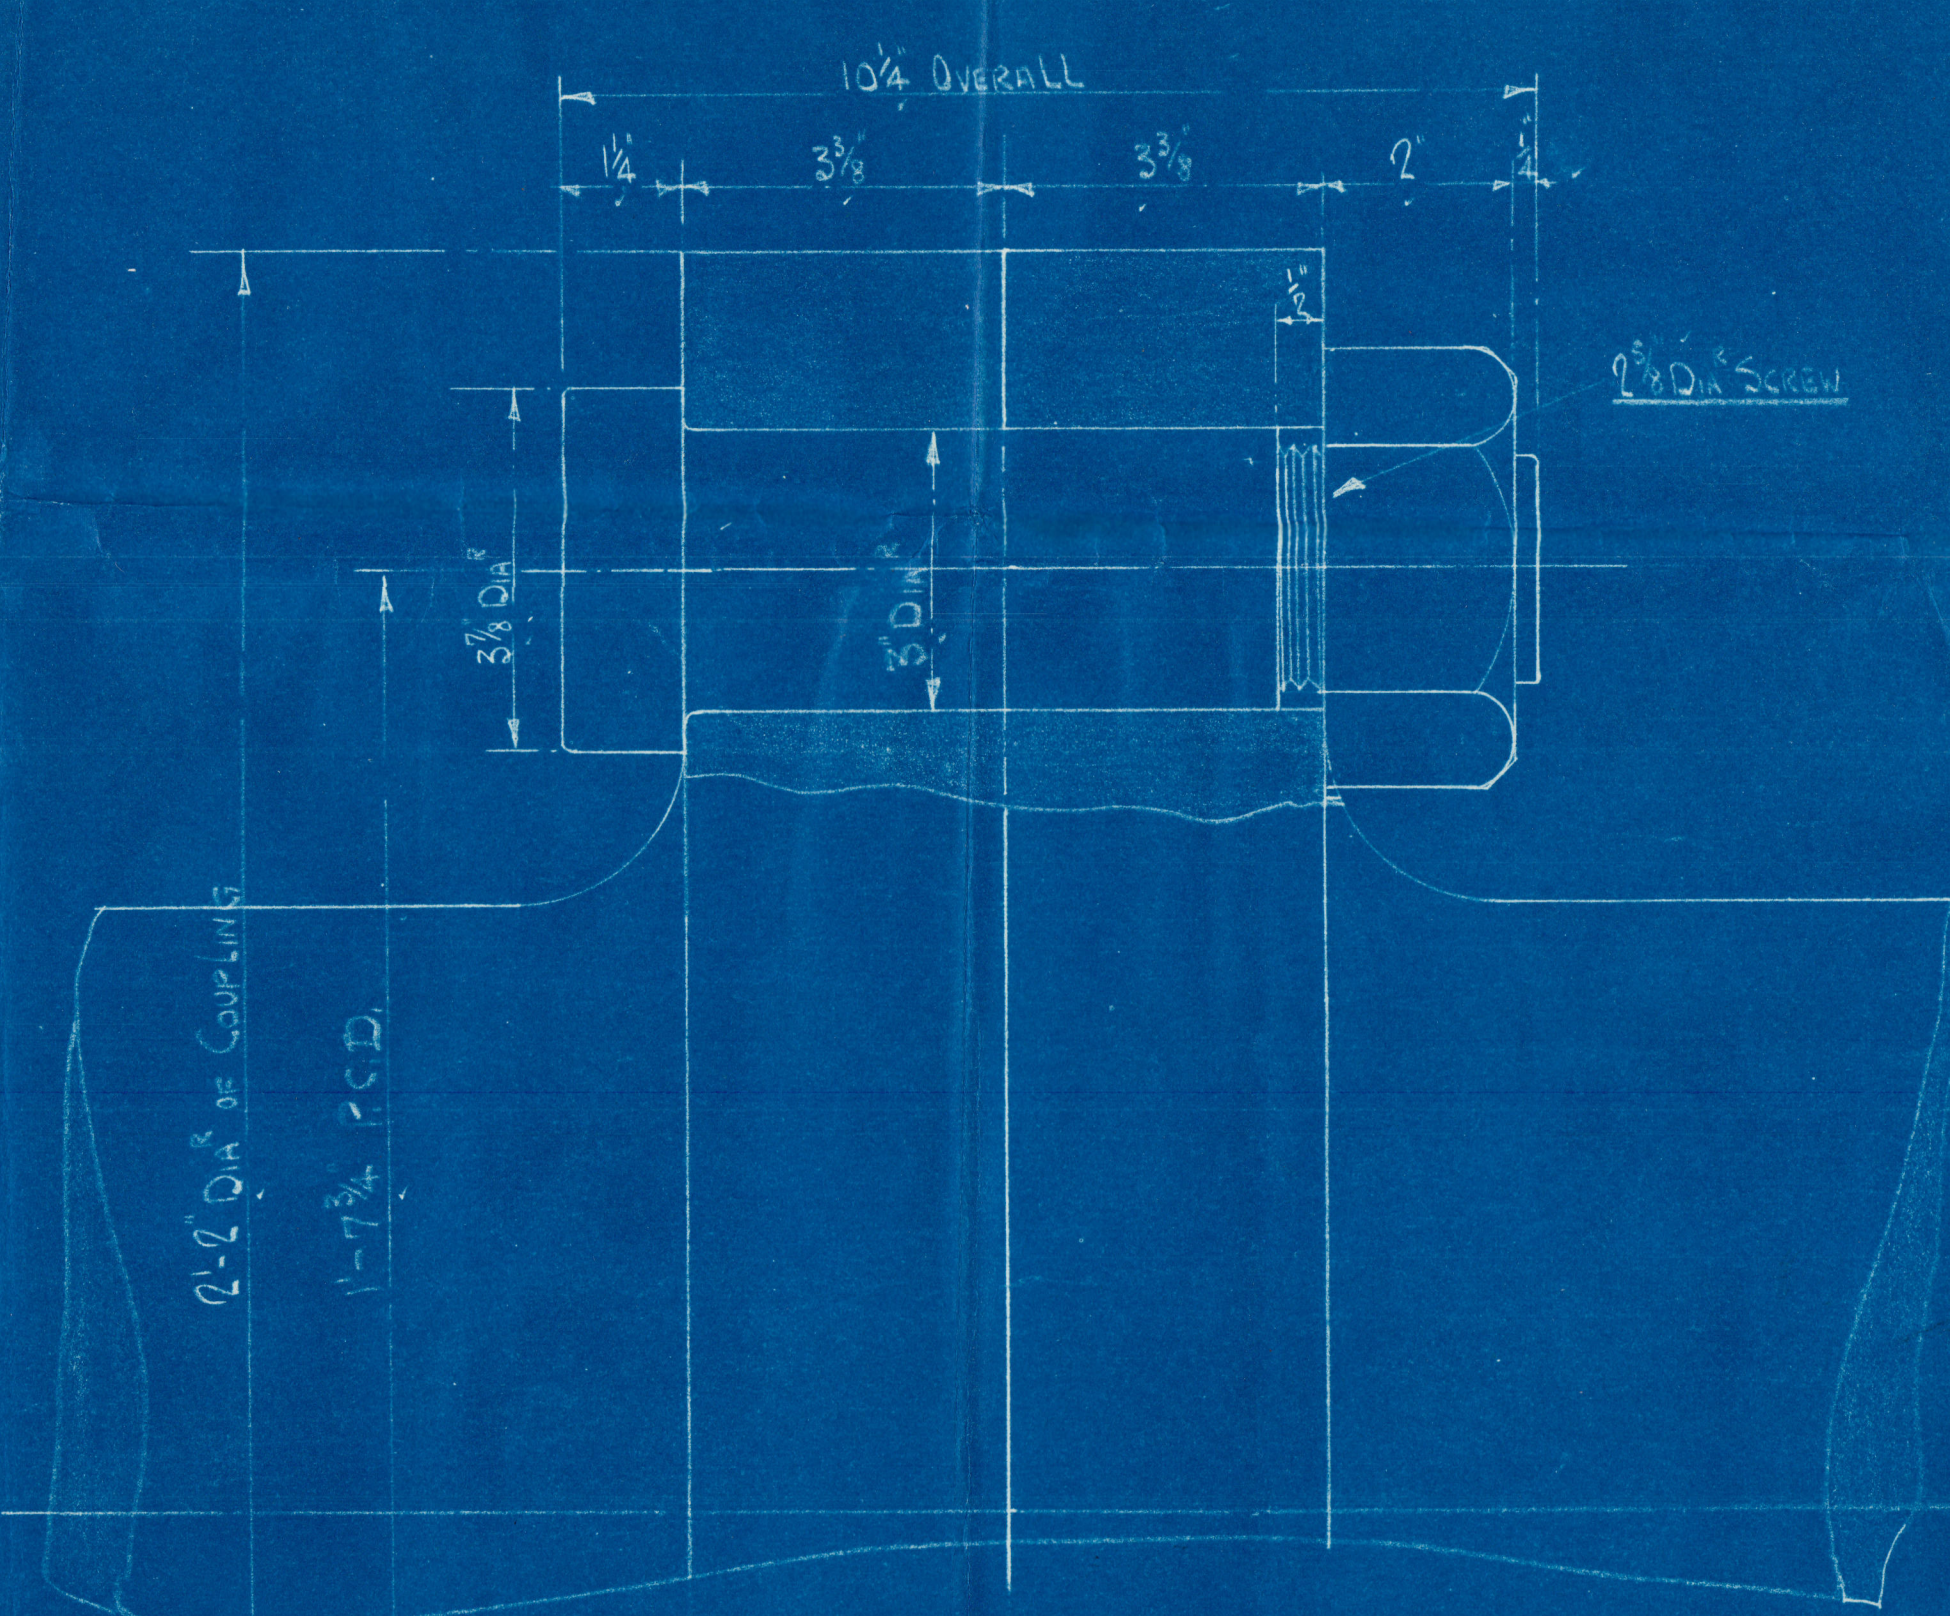

DETAIL OF COUPLINGS
6 BOLTS IN EACH COUPLING
SCALE: HALF SIZE

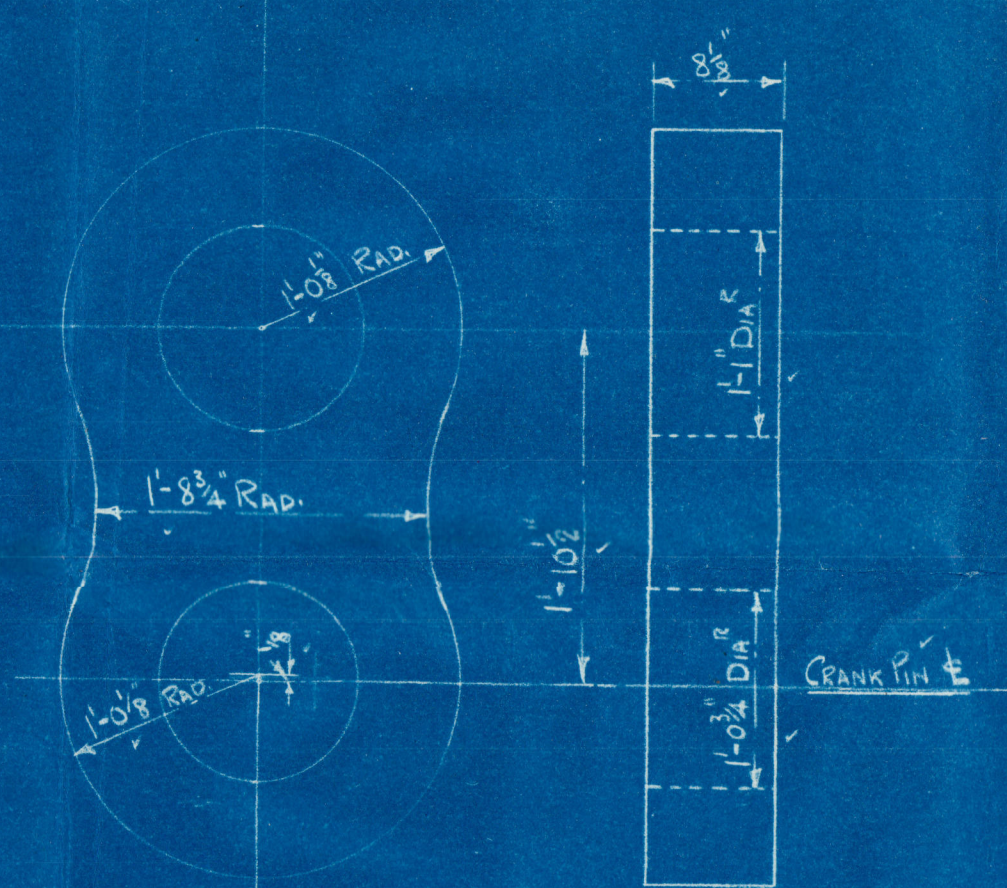


NOTE: CRANK SHAFT, PINS & WEBS ALL OF FORGED INGOT STEEL

TO PASS LLOYD'S SURVEY

SCALE: 1" & 6" = ONE FOOT

CRANK SHAFT
ENG. NO. 459

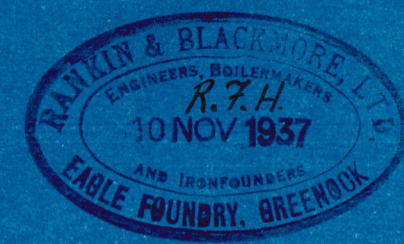

(4)


Ranbent Blackmore
N^o 459.

Blank Sheet.

S.S. " COULTARN

GRK. FIRST ENTRY REPORT N^o 20634.

RETAIN

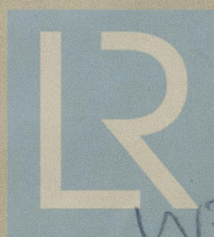

© 2020

Lloyd's Register

W378-0097