

26.1.15

MIDSHIP SECTION


N^{OS} 643'4 & 656'7

STEEL SCREW TRAWLERS

DIMNS 136'-0" B.P. x 24'-0" EX x 13'-7" MLD

SCALE 1/2" = 1 FOOT.

PLAN No. 5202
 FOR ENTRY TO
 Lloyd's Register
 Hull FROM
 COCHRANE & SONS, LTD.
 SHIPBUILDERS, SELBY.
 DATE 23rd Jan 1915

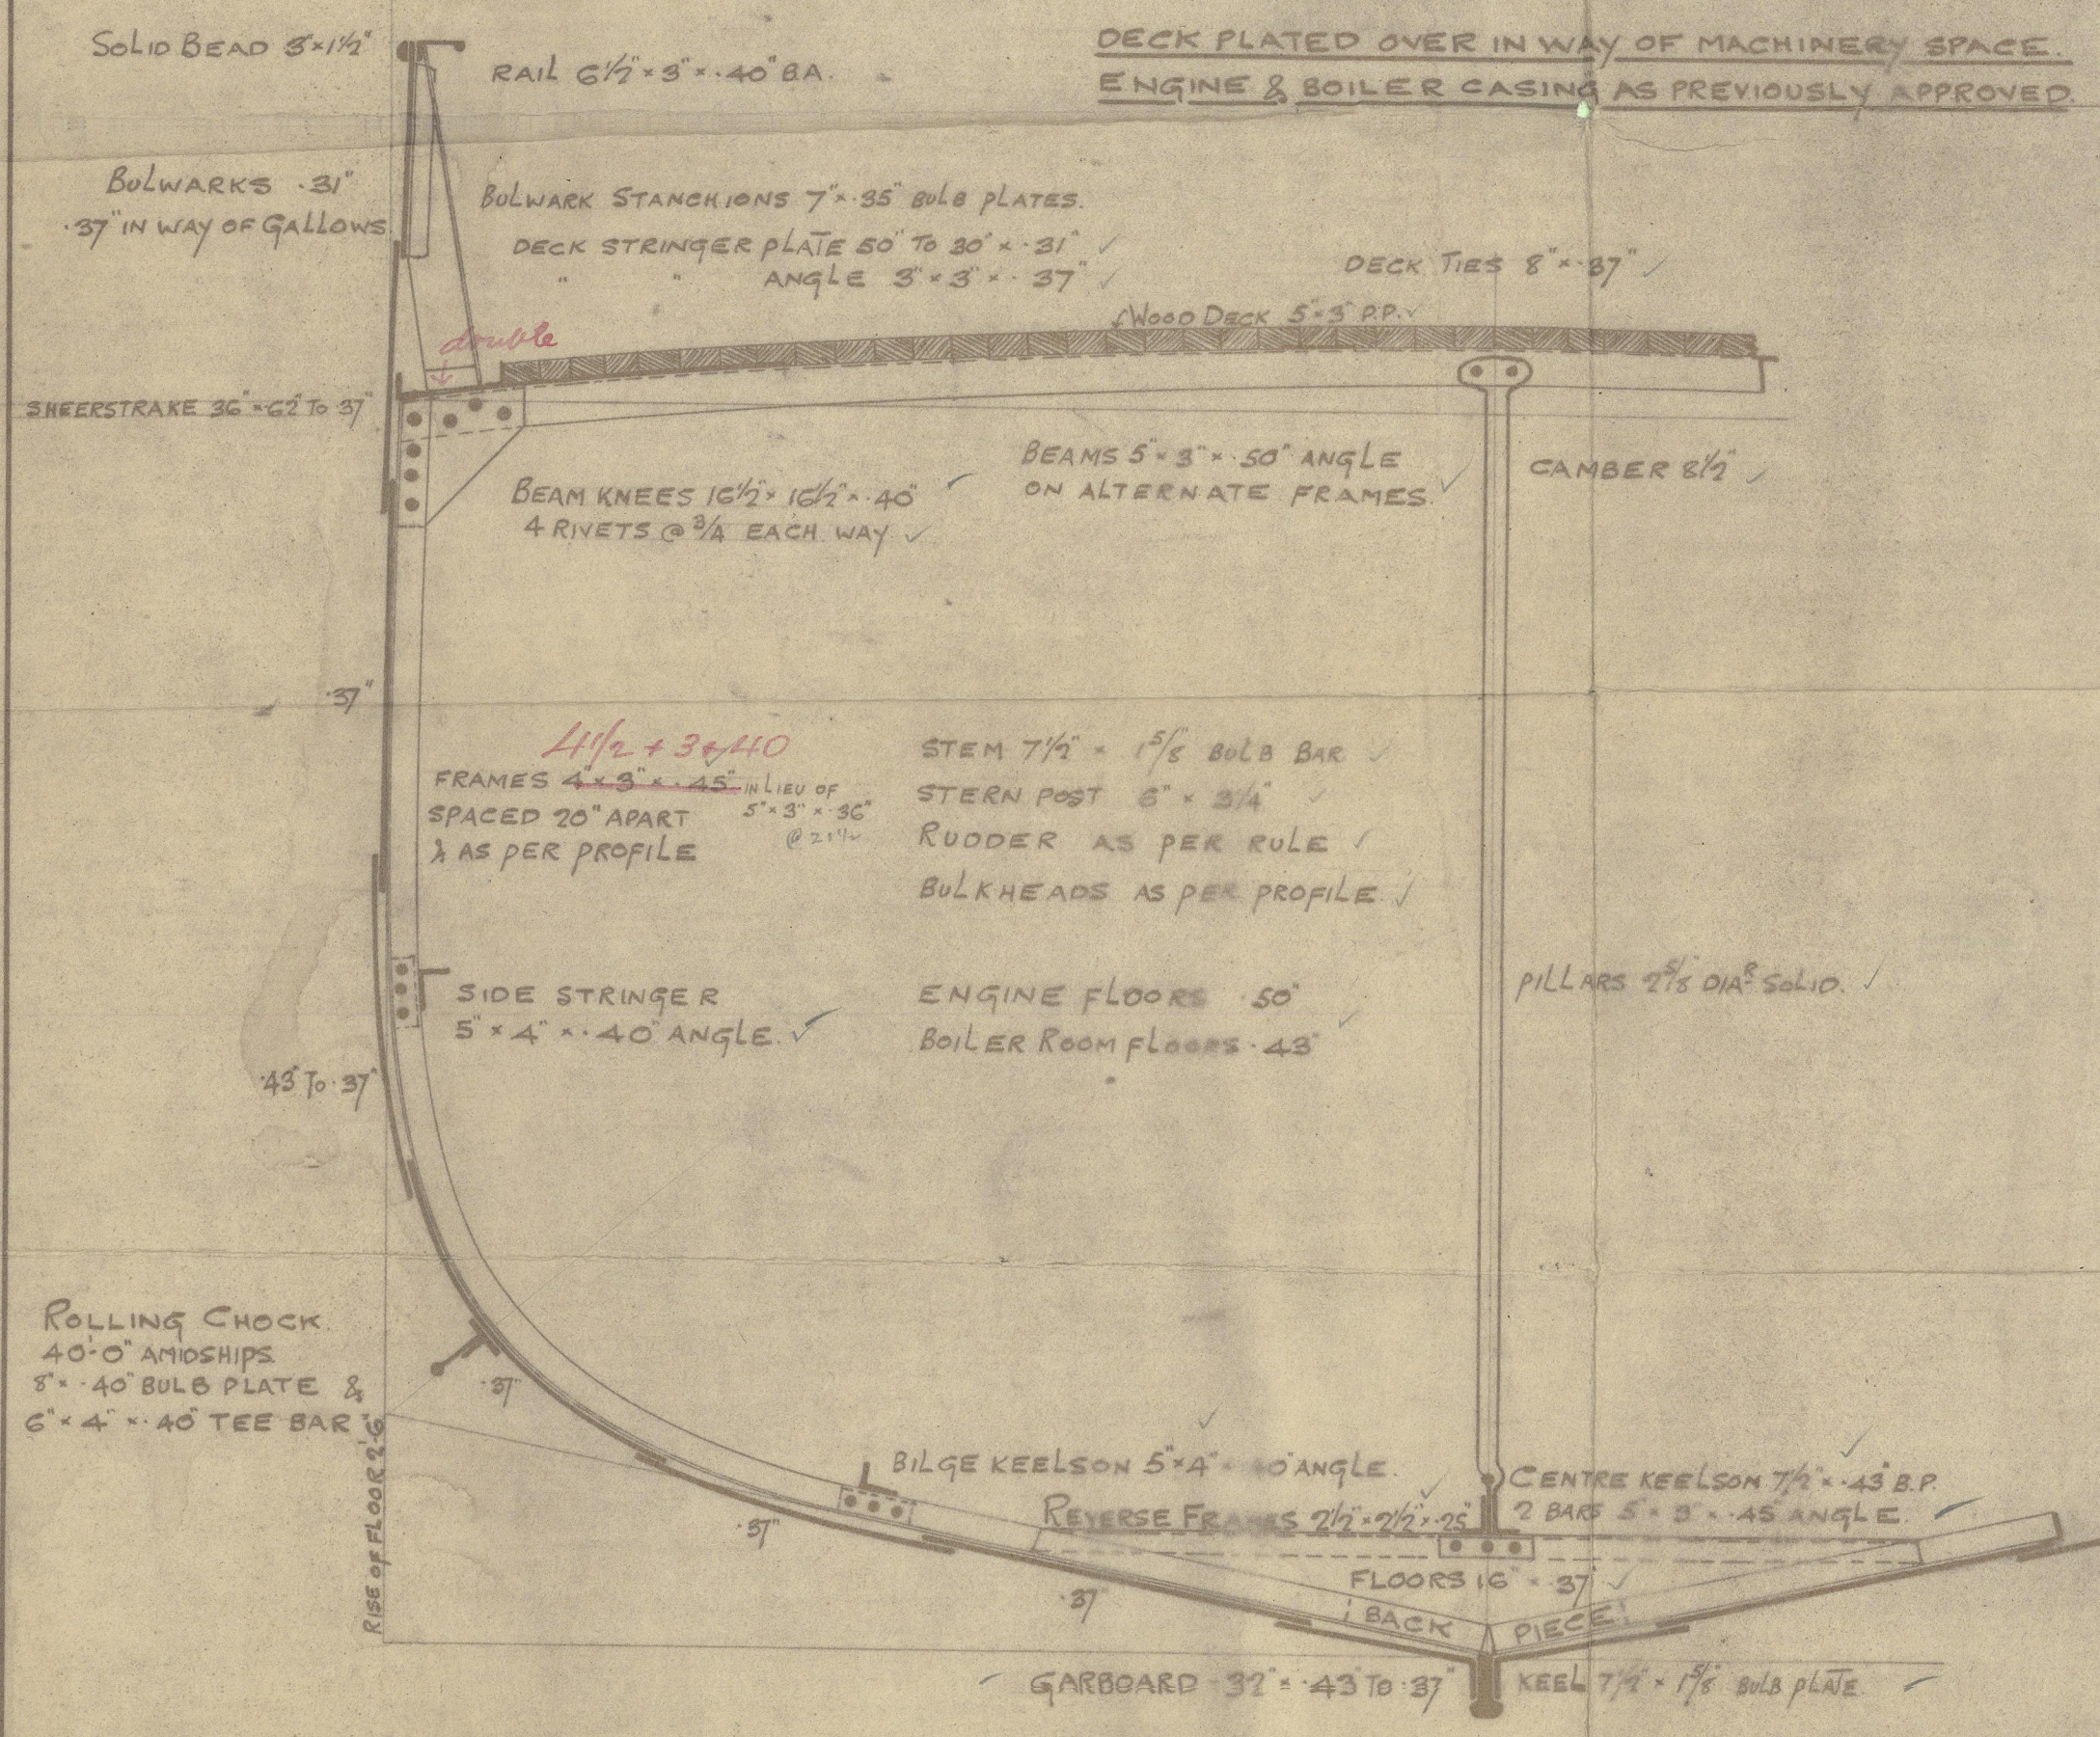

NUMERALS

B+D ----- 87' 45" ✓
 L x (B+D) ----- 5093' 20" ✓

PROPORTIONS

L/B ----- 5.69
 L/D ----- 10.01 ✓
 D = 12.25' ✓


EQUIPMENT

- 1ST BOWER ANCHOR 8 CWTs STOCKLESS
- 2ND " " 7 1/4 "
- KEDGE " 3 1/4 " EX STOCK
- 120 FATHOMS 1 1/2" STUD LINK CABLE
- 60 " 6" HAWSER
- 60 " 5" WARP

RIVETTING

BUTTS OF SHELL PLATING LAPPED & DOUBLE RIVETTED, EXCEPT GARBOARD & SHEERSTRAKE WHICH ARE STRAPPED & DOUBLE RIVETTED. LANDINGS DOUBLE RIVETTED - BULWARKS SINGLE RIVETTED.

CAF
 26.1.15.

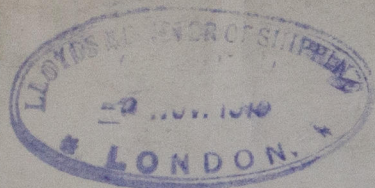

Colerane's nos
643/4 600/7.

Middle Section




S.S. Magneta Hull Reg No 28844
No 643

S.S. Kelvin ————— 28914

S.S. ^{No 644} ~~Harriet~~ Hull Reg No 2948

S.S. ^{No 656} ~~Harriet~~ ^{EXC 1915} ~~Harriet~~ Hull Reg No 29526
No 657

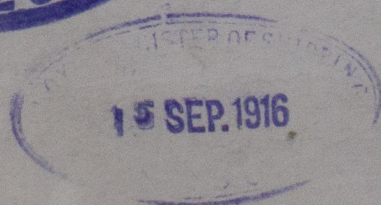

W28-0061



© 2019

Lloyd's Register
Foundation