


SHIP NO 559.
LONGITUDINAL SECTION.

DIMENSIONS - 400'-0" L.B.P. x 55'-0" B.M. x 57'-5" D.M. TO SECOND DECK
x 35'-6" D.M. TO UPPER DECK

SCALE 1/8" = 1 FOOT.

 

FORECASTLE DECK.

FORECASTLE D.K.




UPPER D.K.

SECOND D.K.

UPPER DECK.

SECOND DECK.

TANK TOP.

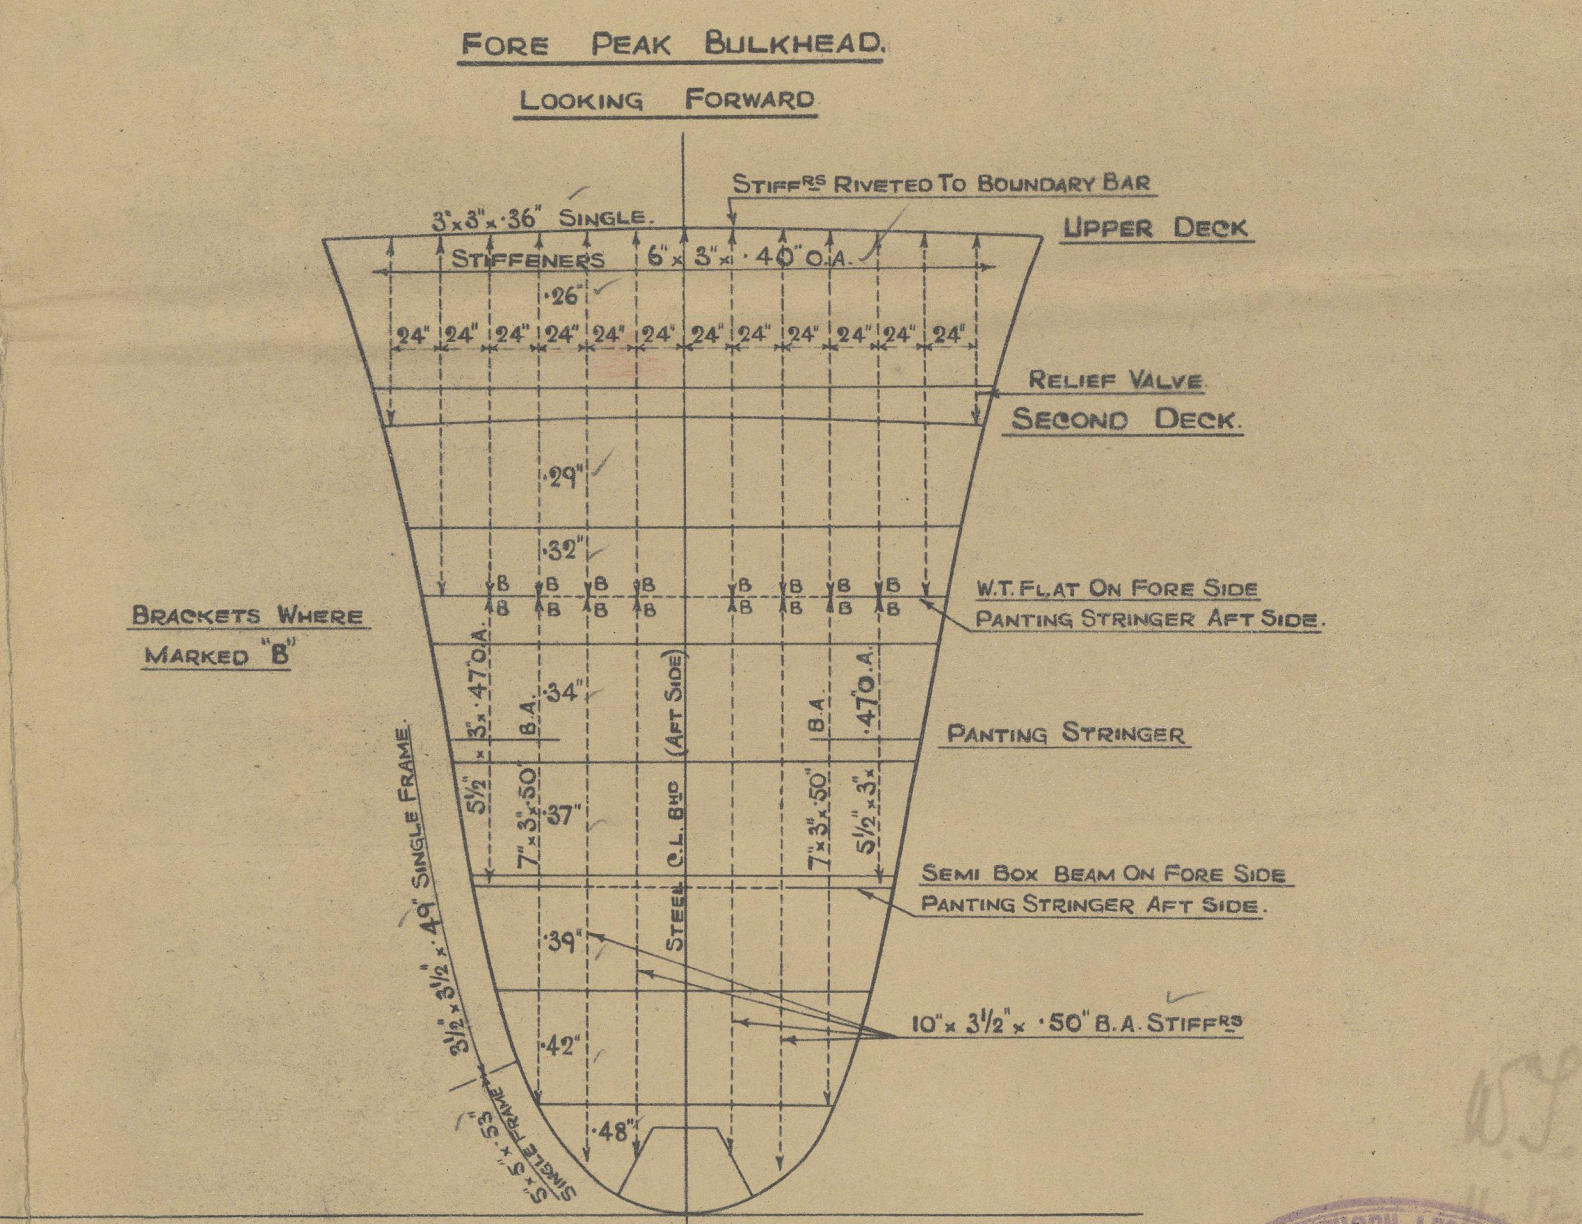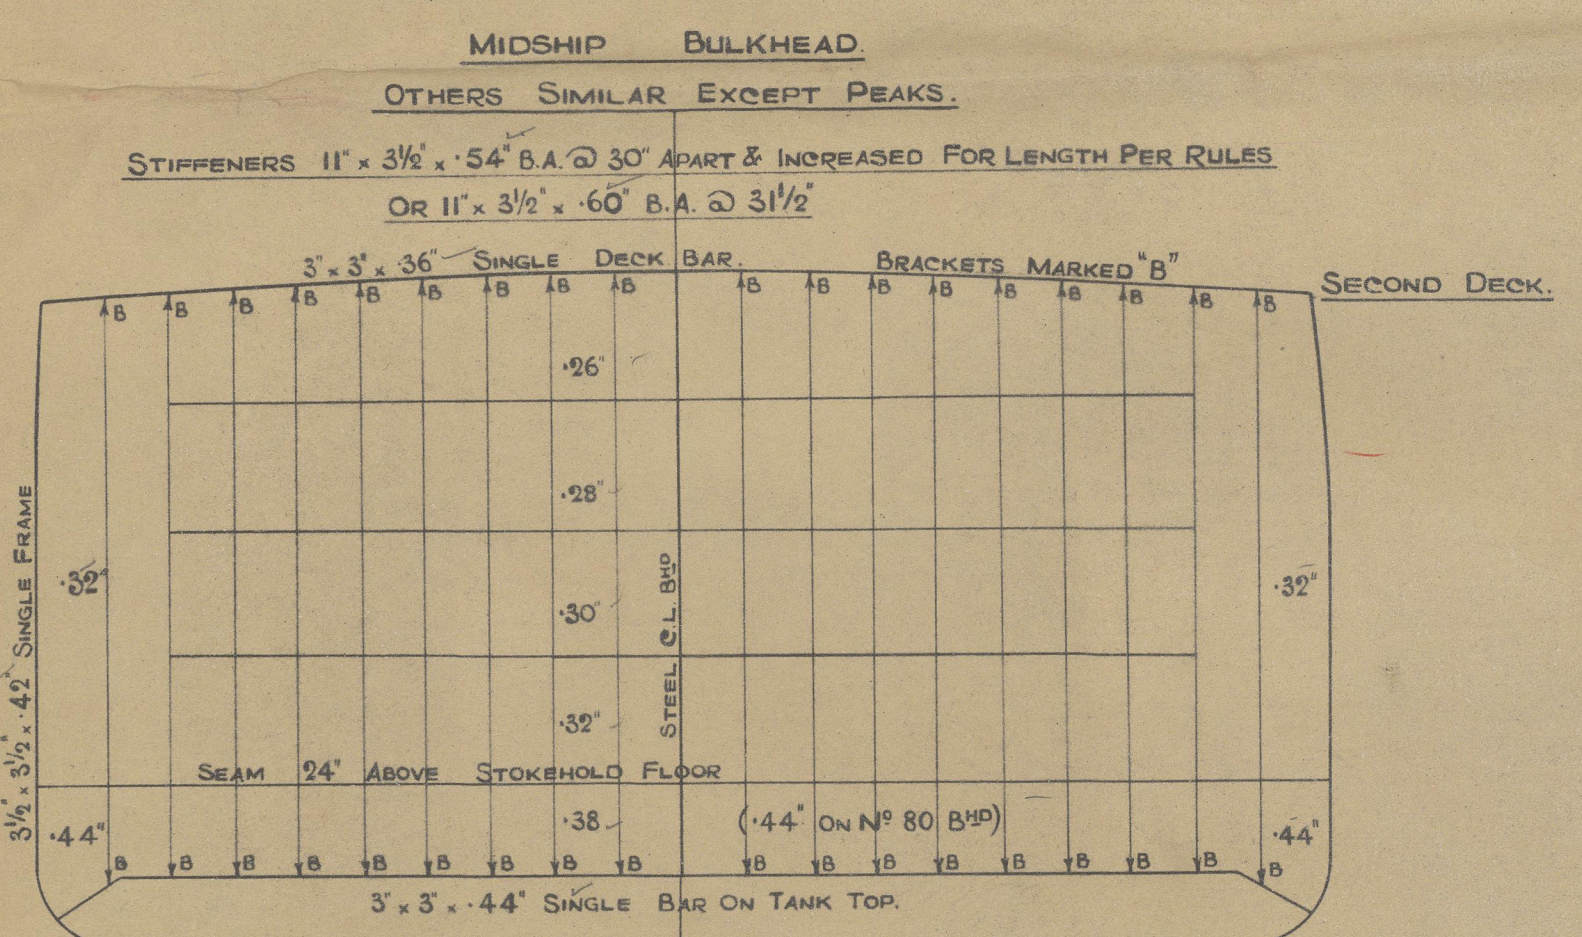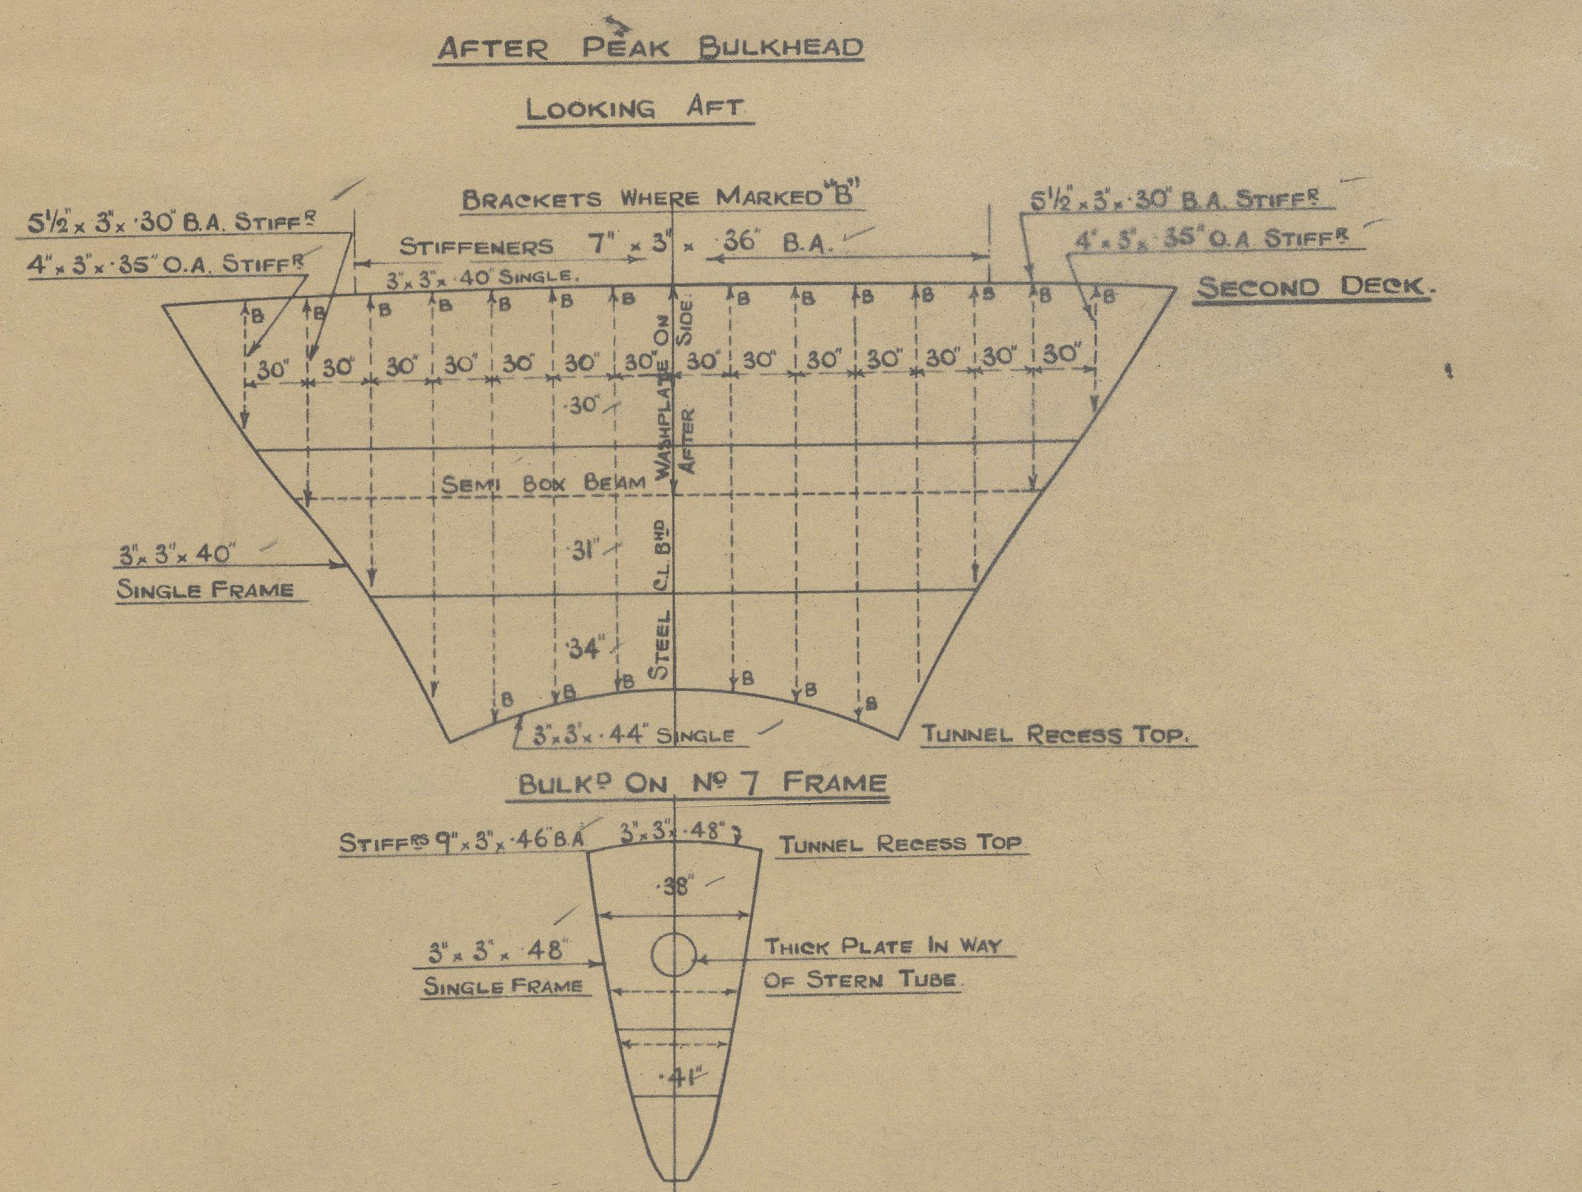

Midship Section

Hawthorn Leslie's No - - - -

Similar to then 5245

W38-0078



© 2019

Lloyd's Register
Foundation

7

7

559

Hawthorn Leslie's

539

Profile with Plans & Bulbheads

signed

Profile

FOWBERRY TOWER
S.S. ~~BELNOR~~
NEWCASTLE ON TYNE.

Report No. 844150.

W38-0078

W38-0078



© 2019

Lloyd's Register
Foundation