

Do all the Frames extend to the top height in the Poop? *Yes* Raised Quarter Deck? *Yes* Bridge House? *Deck* *Yes* Forecastle? *Yes*
 To what height do the Reverse Frames extend? *Yes*
 Has the Poop or Raised Quarter Deck an efficient Iron Bulkhead at the fore end? *Yes*
 Give particulars of the means for closing the openings in Bulkhead *1 wood hinged door + 1 hinged iron door*
 Is the Poop or Raised Quarter Deck connected with the Bridge House? *Deck* *no* Has the Bridge House an efficient Bulkhead at the fore end? *Deck* *Yes*
 Give particulars of the means for closing the openings in Bulkhead *No openings*
 What is the thickness of the Bridge Front plating? *8/20* and Coaming plate? *no coaming plate, boundary angle 6 x 3 1/2 x 9/16*
 Give scantlings and spacing of the Stiffeners *4 x 2 1/2 built + 6/16, 2 x 6 apart bracket top + bottom, 2 built heads extend 10 ft from deck to*
 Are bracket plates fitted at each end of the Stiffeners? *Yes* Are hor'l. brackets fitted connecting Bridge Bulk'd. with Bulwarks? *no*
 Has the Bridge House an efficient Iron Bulkhead at the after end? *Deck* *Yes*
 How are the openings closed? *with weather boarding 3 thick in channel bars each end 4 x 2 1/2*
 Is the Forecastle at least as high as the main or top-gallant rail? *Yes higher* Has the Forecastle an efficient Iron or Wood Bulk'd. at after end? *Yes fitted with*
 Are the Engine and Boiler openings covered by a Bridge, Poop, Raised Quarter Deck, or enclosed by a Strong Iron or Steel Deckhouse? *Deck* *Bridge deck with iron engine room skylight + fiddly over plate*
 If the openings are not so protected are the exposed parts of the Casings efficiently constructed? *There is a steel casing fitted around tunnel on*
 Give thickness of plating; scantlings and spacing of Stiffeners *Yes*
 What is the height of the exposed Casings? *Yes* Are suitable means provided for closing all openings in them in bad weather? *Yes*


Are the Weather Deck Hatchways efficiently constructed and at least equal to the requirements of Section 28 of the Rules for 1904-5? Give particulars below:— *No 6 Hatchway on Poop 16' 4" x 12' 8" No 7 - 5' 6" x 5' 6" Coaming 2' 4" casing 2' 8 1/2 sides 2' 11"*

Position and Size.	No 1 Hatchway 26 x 18.0		No 2 - 39.9 x 18.0		No 3 - 35.0 x 18.0		No 4 - on bridge 7 x 32 x 18.3		No 5 - 30.0 x 18.1 1/2	
	Ship.	Rule.	Ship.	Rule.	Ship.	Rule.	Ship.	Rule.	Ship.	Rule.
COAMING										
Height above top of DECK	2.11 and 3.1		2.11 and 3.1		2.11 and 3.1		2.11 and 3.1		2.11 and 3.1	16-4 x 12
Thickness	Sides	7/16	7/16	7/16	7/16	7/16	7/16	7/16	7/16	3/16
	Ends	6/16	6/16	6/16	6/16	6/16	6/16	6/16	6/16	6/16
SHIFTING BEAMS OR WEB PLATES	Number	5 plates 1.6 x 1.8 1/2	6 plates 1.6 x 1.8 1/2	5 plates 1.6 x 1.8 1/2	5 plates 1.6 x 1.8 1/2	5 plates 1.6 x 1.8 1/2	4 plates 1.6 x 1.8 1/2	4 plates 1.6 x 1.8 1/2	4 plates 1.6 x 1.8 1/2	1 plate
	Section and Scantlings	2 angles 4 x 3 top 2 built angles 4 x 3 bottom	2 angles 4 x 3 top 2 built angles 4 x 3 bottom	2 angles 4 x 3 top 2 built angles 4 x 3 bottom	2 angles 4 x 3 top 2 built angles 4 x 3 bottom	2 angles 4 x 3 top 2 built angles 4 x 3 bottom	2 angles 4 x 3 top 2 built angles 4 x 3 bottom	2 angles 4 x 3 top 2 built angles 4 x 3 bottom	2 angles 4 x 3 top 2 built angles 4 x 3 bottom	15 x 3/16
	Material	steel	steel							
* FORE AND AFTERS	Number									
	Section and Scantlings	nil	nil							
	Material									
HATCHES Thickness	2 3/4		2 3/4		2 3/4		2 3/4		2 3/4	
Remarks										4 3/4

* The depth of Fore and Afters should be stated from the underside of the hatches in all cases.
 (If the sill of the lowest side scuttle will be less than 6 inches above the Indian Summer Load Line if assigned under the tables, state vertical distance from top of deck at side amidships to lower edge of lowest side scuttle.)

The following information is to be given in all Cases of vessels dealt with under Paras. 11, 12 (under 15 feet Moulded depth) and under Shelter Deck Rules.

What is the thickness of the Bridge Sheerstrake? *12/16* Strake between Main and Bridge Sheerstrakes? *joining 11/16*
 Delete the words { The Crew ~~are not~~, berthed in the bridge house.
 that do not apply { The arrangements to enable them to get backwards and forwards from their quarters ~~are~~, ~~are not~~ satisfactory. *on upper deck main*
 Length of Bulwarks in well *Fore well open with iron stanchion + guard rods for 18.0 long. After well open for 29.0.*
 Area of Freeing Ports required by Para. 11 (e) each side of vessel = Sq. ft.
 Ft. Tenths. Ft. Tenths. No. } Freeing Ports (each side of vessel) = Sq. ft.
 (70'-0" x 11'-0") x }
 Total deficiency or excess = Sq. ft.

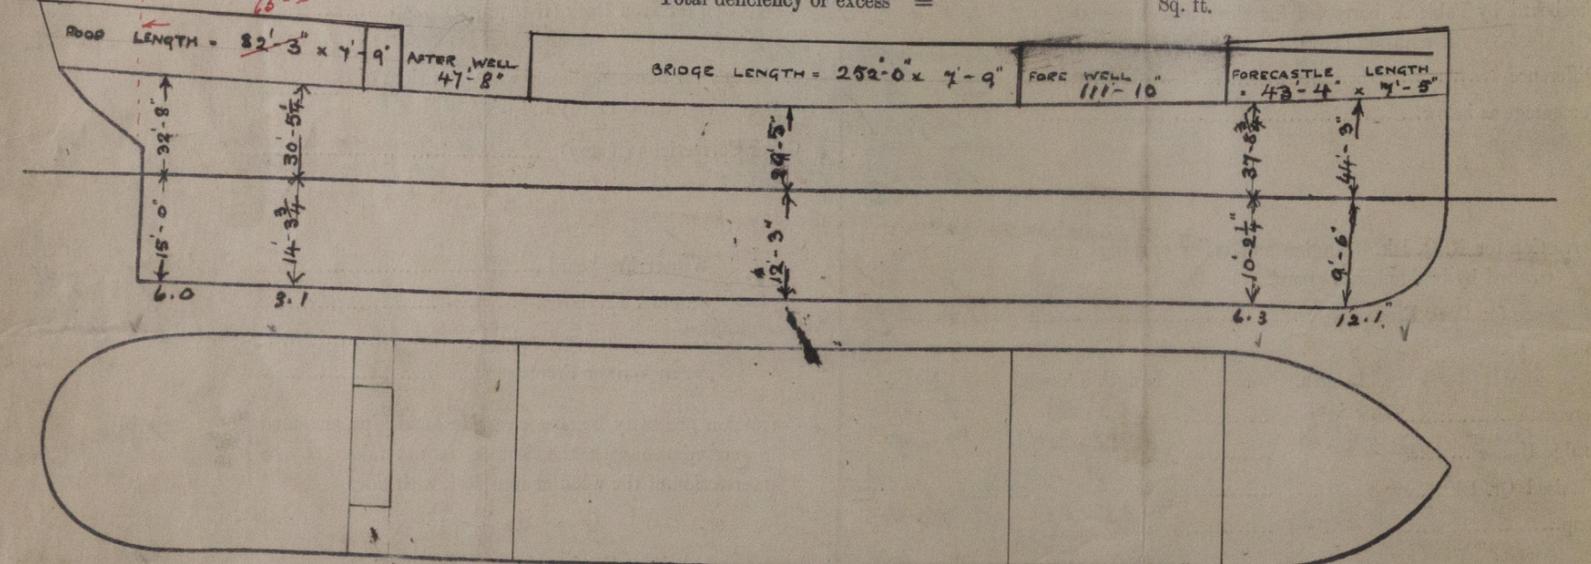

Show hereon line of Floors or Tank Top with position of any Breaks in same; also height of Peak Tank tops, &c., &c.

State any special features in the construction of the Vessel *This vessel is a well built steamer, and hope the survey for classing as far as can be carried out here is near completion, and to be shifted to some other Port for dry docking, will be glad to receive the Freeboard*
 Owners *Federal Steam Nav Comp Ltd*

Address *Ten Church Avenue London E.C. 3*
 Received by me *See F. E. Report*

