


G.S. 233

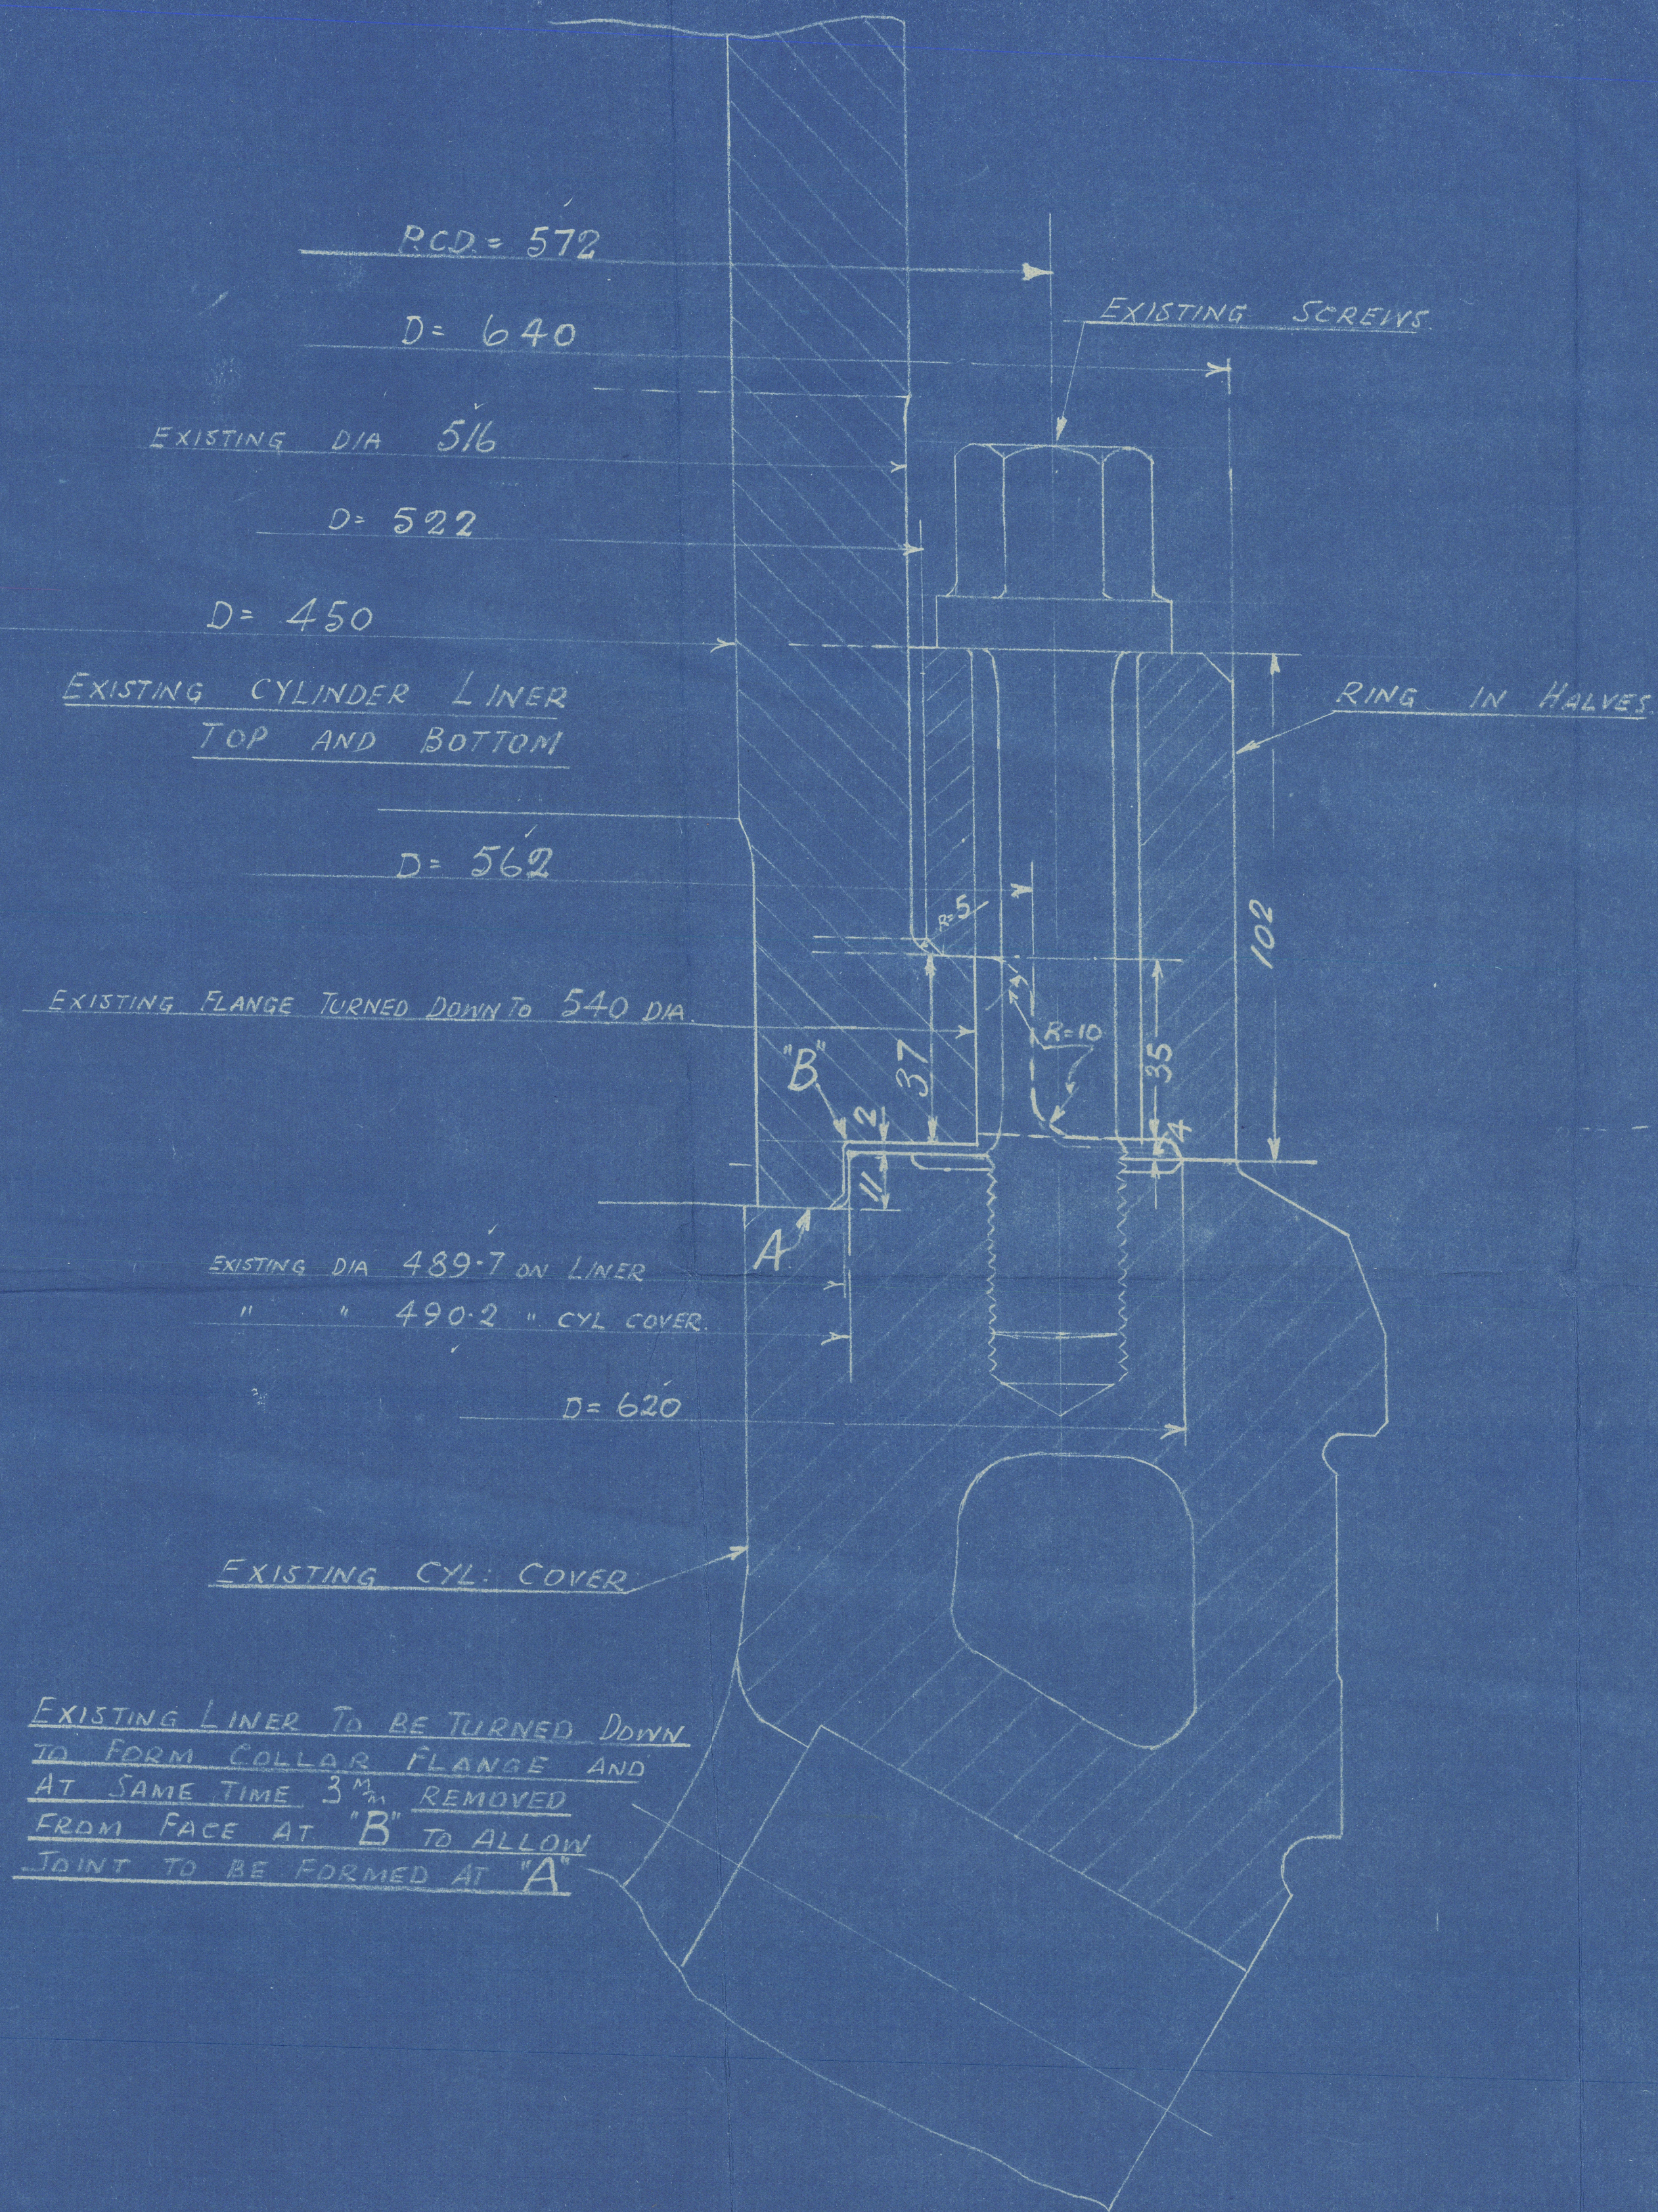

MODIFICATION TO MAIN CYLINDER LINER & COVER

To be tried out on two cylinders

SCALE 1:1



© 2020

4 Copies handed to Mr. Blundell 23/12/47  
1 Copy to Mr. Shroder for Mr. Blundell 24/12/47

W383-0037

G.S. 233




DUNVEGAN CASTLE.

MODIFICATION TO MAIN LINERS & COVERS.

RETAIN

RETAIN

W383 - 0037

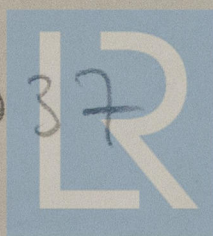

© 2020

Lloyd's Register  
Foundation