




4.11.14
13.11.14
25.1.15
30.1.15
11.1.16

 

PROFILE

LENGTH B.P. 430'-0" BEAM MOULDED 61'-0" DEPTH MOULDED 30'-4 1/2"

SCALE 1/8" = 1 FOOT.

This plan has been compared with the original.

W.H. 11/14
C.F.

STRINGER ANGLE 3 1/2 x 3 x 36
STRINGER PLATE 40 x 36
DECK PLATING 30.

W.T. Flat

Sketch of painting arrangement to be submitted

Sketch of painting arrangement to be submitted

T.S.S. 555

RIVETS THROUGH SHELL TO FRAMES IN AFTER PEAK 5 1/2" DIAM APART.
FRAMES - FLOORS 5"

WATERTIGHT CENTRE DIVISION

BOTTOM FORWARD STRENGTHENED AS PER RULE & to Surveyors Satisfaction RIVETS THROUGH SHELL IN PEAKS TO FRAMES 5 1/2" DIAM APART

C.F.
27.10.14

T.S.S. 555

Irvine: S.B. & D.D. Co. L²

T.S.S. N° 555.


PROFILE

430' x 61' x 30-34 U. DK. ^{38-3 1/2 Thr. Sh.}

NOVBR 1914.

T.S.S. "DUQUESA"

Report N° 15499.

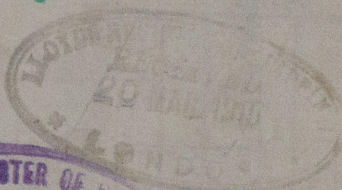


© 2020

W383

- 0135

Lloyd's Register
Foundation

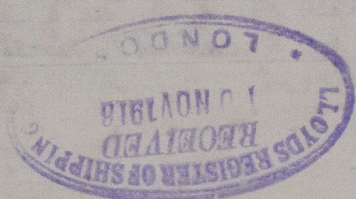

© 2020

Lloyd's Register
Foundation