

26 JUL 1910

LLOYDS NUMBERS

EQUIPMENT.

1 RODGERS ANCHOR 8 CWT STOCKLESS

1 11 7 1/4 11

1 " " 3/4 E. STOCK

120 FT HMS 1/8" CHAIN CABLE

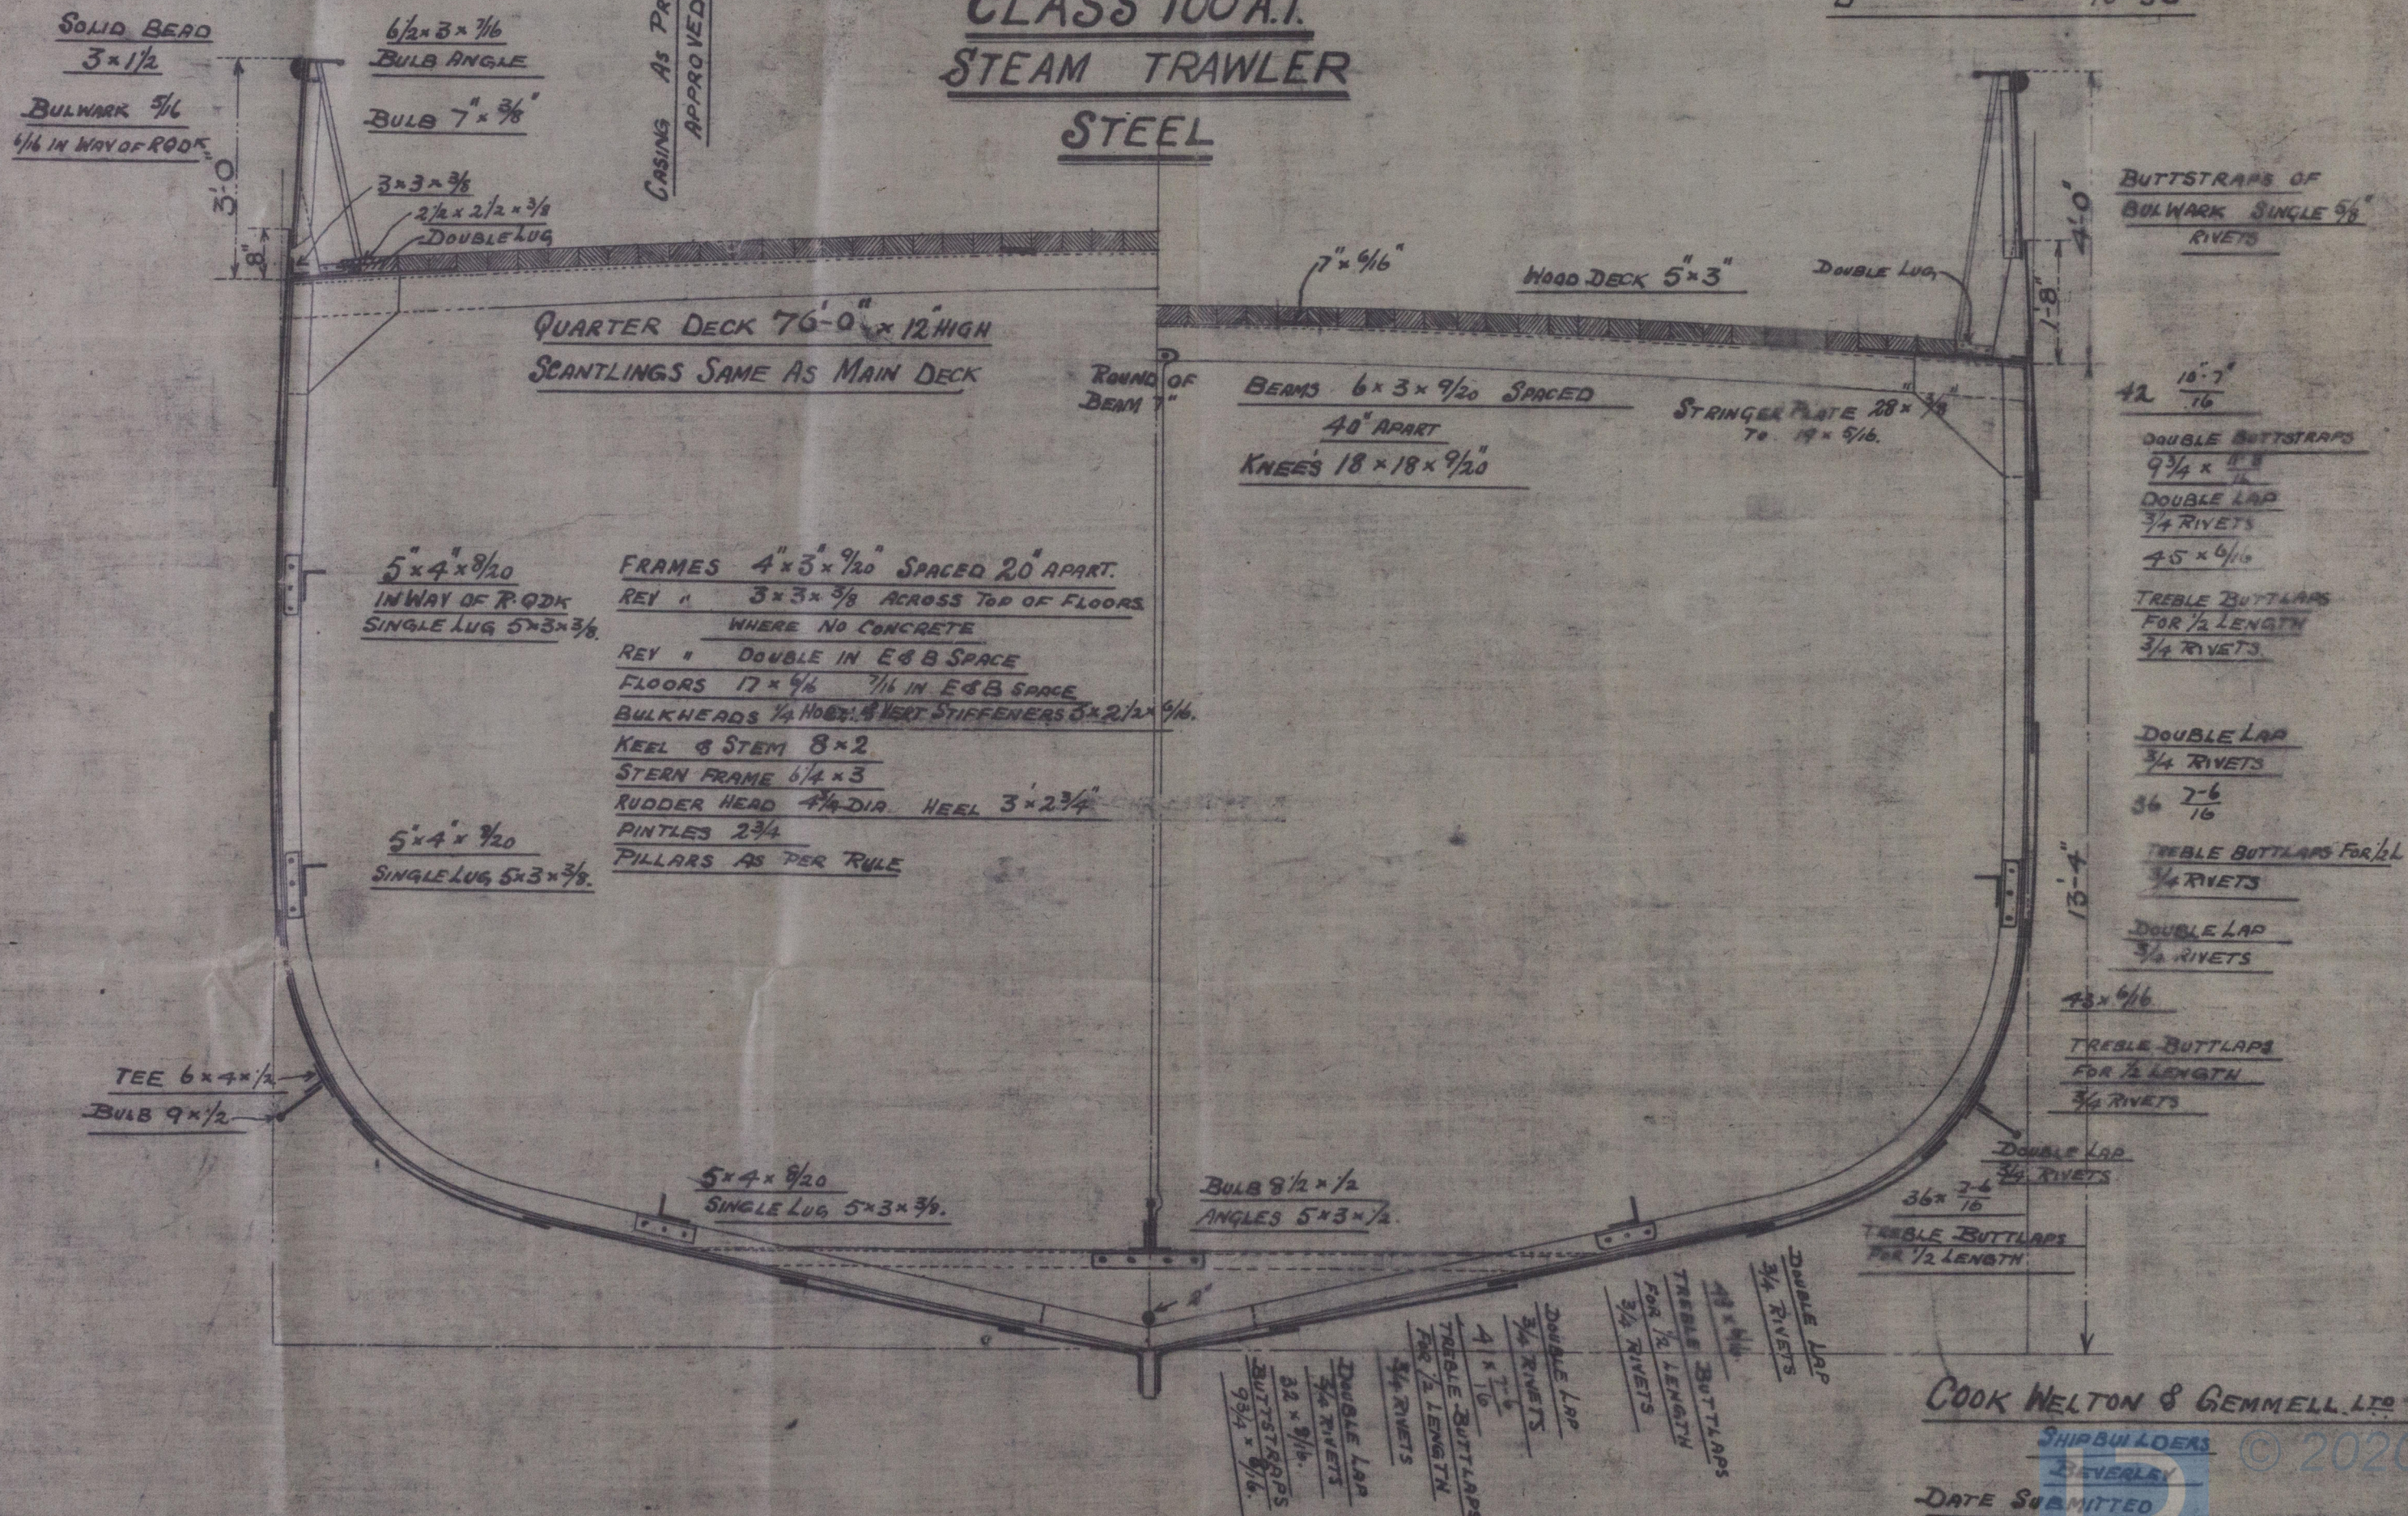
60 " 6" HAWSER

60 " 5 WARP

SCALE $\frac{1}{2}$ = ONE FOOT

DIMENSIONS 140'-0" BP x 24'-0" MOULDED x 13'-4" HLD.

CLASS 100 A.I.
STEAM TRAWLER
STEEL

$$\begin{array}{rcl} L & = & 140.0 \\ B+D & = & 37.33 \\ a & = & 11.91 \\ L \times (B+D) & = & 5226.20 \\ \frac{L}{D} & = & 10.50 \end{array}$$


COOK WELTON & GEMMELL LTD

SHIPBUILDER

BEVERLY

DATE SUBMITTED
APPROVED

Lloyd's Register
Foundation

W383-0228

N^o 212

MIDSHIP SECTION

COOK WELTON & GEMMELL

n/n "Dervish"

s/c ^{esc} Norman

Hull Rpt No. 23713

RETAIN

RETAIN R

W383-0228

RETAIN



© 2020

Lloyd's Register
Foundation