

HEATING SURFACE.	SQ FEET.
154 TUBES $2\frac{3}{4}$ DIA ²	= 748
FURNACES.	= 134
COMB ^N CHBRS.	= 129
TOTAL PERLBR.	1011
" 280ILRS=	2022
SIZE OF SAFETY VALVE $2\frac{1}{2}$ " DIA. (DOUBLE.	
OIL BURNING ONLY.	
ASSISTED DRAUGHT	

	DIA OF RIVET	DIA RIV HOLE	PITCH	PLATE %	RIVETS	WP OF SHELL BY RULE
LONG TH SEAM	$\frac{3}{4}$	$\frac{13}{16}$	6	86.46	88.6	154 LBS PER SQ. IN.
CIRCUM TH "	$\frac{13}{16}$	$\frac{7}{8}$	2.91	69.8	45.2	

D_{RC}. N^o. 3392.

A.T.G.
30-5-24.
~~NDA~~

Kincaid N. 8104

~~Ausc Boilers 18/180~~

r/n "Eli Knudsen"




ex


M. N. "O.A. KNUDSEN".

Greenock. Report No. 18471.

RETAIN

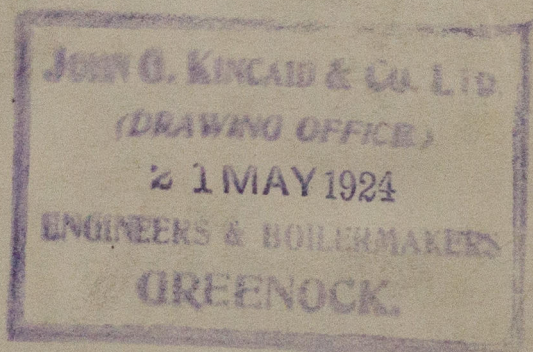

"Eli Knudsen"

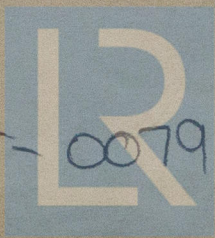

W385-0079

© 2019

Lloyd's Register
Foundation