

T.S.M.V. No 10.


PROFILE

7 Sect. 2 par. 1
DIMENSIONS:- 468'-6" . 62'-0" . 34'-9" TO UPPER DECK.
TO CLASS 100 A.I. FOR CARRYING PETROLEUM IN BULK.
SCALE:- 1" = 1 FOOT.


NOTE:- ALL WASHPLATES AND M.L. BULKHEADS TO BE LIGHTENED AS MUCH AS POSSIBLE BY SPACING BETWEEN STIFFENERS.

Note: C.L. Bhd. to be slight excepting in way of Pump Room & afterdams.

APPROVED
LLOYD'S REGISTER OF SHIPPING
J. Hunt & Co. Ltd.
DATE 25.6.24

 

Lloyd's Register of Shipping
16-6-24
W385-0085

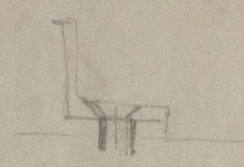

3/2/20



© 2019

Lloyd's Register
Foundation

Blythwood No 10

Profile 2

WS 480

n/n "Eli Knudsen"
ex


G A Knudsen

GLASGOW REPORT No. 45152

RETAIN

RETAIN

W385-0085

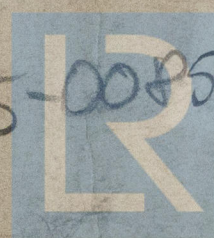

© 2019

Lloyd's Register
Foundation