

Rpt. 8.

For the information of Surveyors and the Committee only.

BELONGS TO GRONINGEN Rpt No. 86<sup>9</sup>  
VESSEL'S NAME "EMINENT"

Received at

DEC -4 1939

Office

## Lloyd's Register of Shipping.

(Report on Vessel No. 309 86<sup>9</sup> Port of Groningen)

No. F 93

## SHIP FORGINGS OR CASTINGS.

I have to report that the undermentioned ~~Iron or Steel Forgings or Castings~~, manufactured by N.V. Pekelder Machinefabriek of Oude Pekela for the Vessel No. 309, being built by Messrs. Bodewes Scheepswerven of Martenshoek have been inspected by me as set forth below and found to be, so far as can be seen, free from defects

Mark on Forgings or Castings.

Lloyd's

Groningen 13-7-1939


No. 123

L.W. 12-7-39

J. H. Wehrmeyer

	STERN FRAME.	RUDDER FRAME.	STEM.
Material* ...	Siemens Martin Steel		
How made ...	forged		
If annealed ...	yes		
Dimensions ...	as per plan		
Progress on Inspection ...	forged & machined		
Date when Inspected	12-7-'39		
CASTINGS.			
ests on Standard Test Pieces.			
Tensile Test—			
Tons per square inch	31.2 T.		
Extension per cent. ...	36%		
Cold Bending Test—			
Angle before fracture	180 degrees good		
Drop Test—			
Height from ground ..	✓		
Hammering Test—			
If made according to Rules and found satisfactory ...	✓		

SKETCHES OF FRAMES SHOWING POSITION AND DESCRIPTION OF WELDS OF FORGINGS.

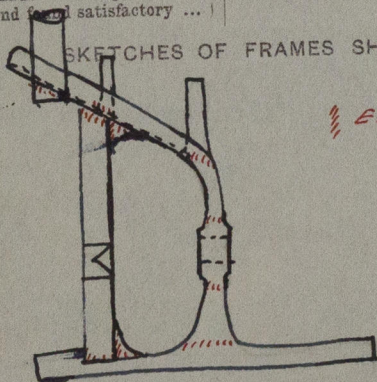


EL. WELDING.

Fee (if any chargeable) £ : :

To be paid at

\* If of Iron, state whether scrap or puddled Iron. If of Steel, state whether made on the Open Hearth process.

3m, 11.37. T.

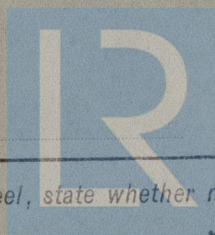

© 2019

Lloyd's Register

Foundation

W387-0039