


Letter Plan

RETAIN

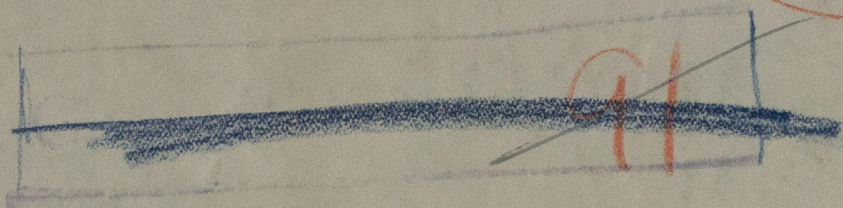

BODEWES' SCHEEPSWERVEN.

War wreck

N° 309

Guineet

MIDSHIP SECTION.

PROFILED DECKS.

SHELL EXPANSION.

BULKHEADS.

DOUBLE BOTTOM

RETAIN

Office


W378-0072



© 2019

Lloyd's Register  
Foundation



 

Handwritten note: *Handwritten note: 1/2" thick 8" x 14" x 65" x 8" at 1/2" intervals*




**BODEWES SCHEEPSWERVEN MARTENSHOEK (Holland)**

**BOUW: 309**

**CONSTRUCTIEPLAN: SCHAAAL 1150-1125 ADVISO 11-4-139**

PARTICULARS				EQUIPMENT			
LENGTH O.A.	22.20	17' 5 1/2"		LETTER IN TUGBOAT BOAT	10.00	10.00	
" L.W.L.	47.85	187'		2 BOWERS STOCK (EACH)	10.00	10.00	
" 90% L.W.L.	45.94	180' 8 1/2"		1 STERN " "	8.15	8.15	
" L.W.L. TO 2nd	46.70	183' 8 1/2"		1 STERN INCL. STOCK	4.15	4.15	
BELOW MAIN DECK	8.46	47' 8 1/2"		STERN CHAIN CABLE 1 1/2" 168 FATH	50%	50%	
DEPTH "	3.20	11' 6"		MIN. WEIGHT	50%	50%	
HEIGHT OF DECK	1.80	6' 8"		STERN WIRE (6X12) 2 1/2"	60 FATH	60 FATH	
" " "	1.15	4' 8"		TOWLING (6X12) 2 1/2"	70 FATH	70 FATH	
" " "	1.20	6' 2"		HAWSEY (6X12) 2"	20 FATH	20 FATH	

No 263