


LONDON

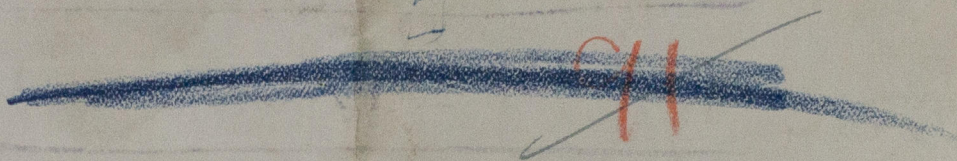

4

BODEWES'

SCHEEPSWERVEN.

Nº 309,

Grimment

MIDSHIP SECTION

PROFILED DECKS

SHELL EXPANSION

BULKHEADS

DOUBLE BOTTOM

APR 17-1-37

See latest
plan



W387-0073



© 2019

Lloyd's Register
Foundation

18 JAN 1939

Reduction of heavy loads 2 10 kg ft.
Suggested loads be increased to 15 kg ft.
to compensate for variation of free passages of loads from side to side.

