

# WRECK SECTION


## Lloyd's Register of Shipping.

Ship's Name *"Empire Adventure" ex "Andrea"*

Official No. *15765*

Memorandum of alterations reported since ship was surveyed for assignment of Load Lines in

Detail of Heeling Ports

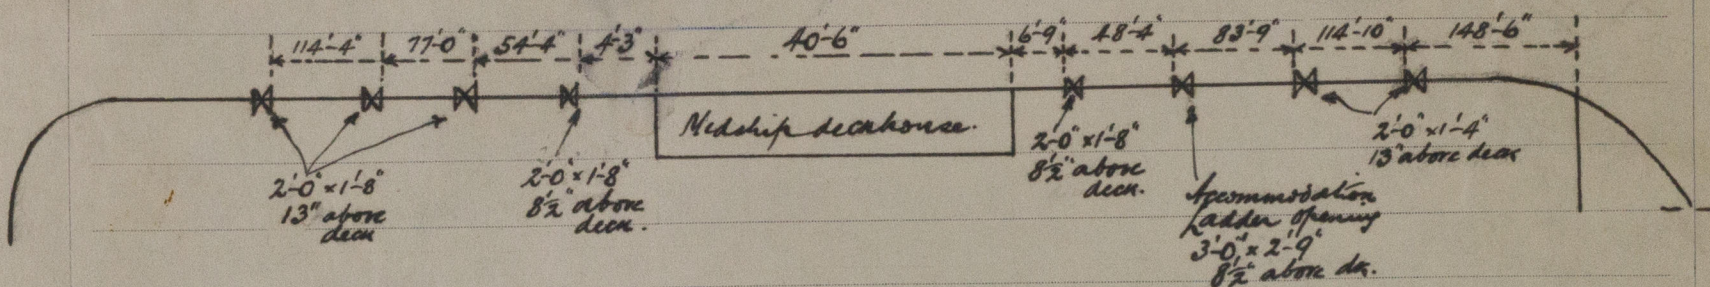

Heeling ports fitted with hinge steel shutters.

*H.R. Gibbs.*

*3.8.40.*

RETAIN