

Northumbria Shipbuilding Co.

S.S. No 156

Profile & deck plans

of vessel as built

Eastney

NEWCASTLE-ON-TYNE

14153

now named

"Empire Adventure"

RETAIN

RETAIN

W387-01972019



Lloyd's Register  
Foundation




# S.S. 256.

## PROFILE AND DECK PLANS.

SCALE  $\frac{1}{8}$ " = 1 FOOT

LENGTH BP. 375'-0". BREADTH MLD. 51'-0". DEPTH MLD. 26'-1 1/2"


DETAIL OF STIFFENERS ON  
C.L. BULKHEAD AT HATCH ENDS.

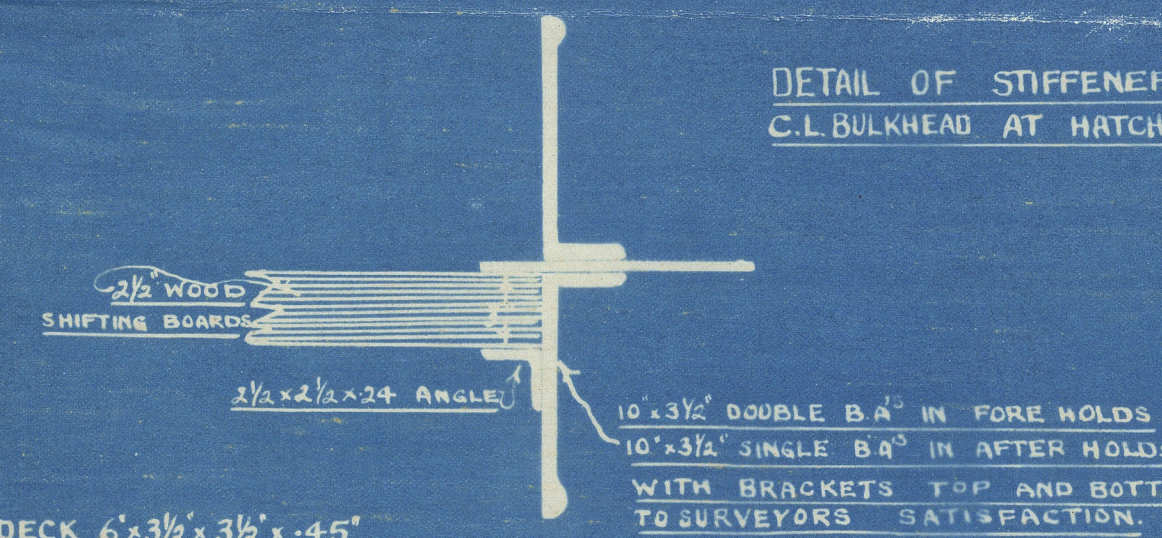

CHANNEL RUNNER UNDER SHELTER DECK 6'-3 1/2" x 3 1/2" x .45"

CHANNEL RUNNER UNDER SHELTER DECK 6'-3 1/2" x 3 1/2" x .45"

FORECASTLE DECK

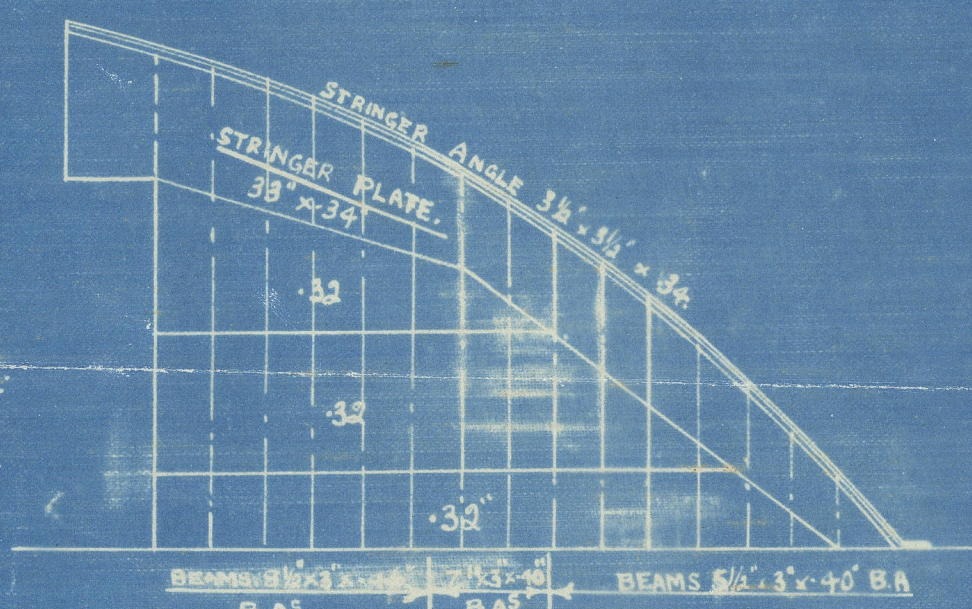

STRENGTHENING UNDER WINDLASS  
TO SURVEYORS SATISFACTION

WINDLASS

FORECASTLE DECK

1 ROW 2 1/2" ON

1 ROW 2 1/2" ON

E & B SPACE (SECT. 22, PAR 12)

BA FRAMES INCREASED .04 IN LIEU OF  
WEB FRAMES IN E & B SPACE.

THURST RECESS

FRAMES CHANGE

SHELTER DECK

BULB ANGLE FRAMES AT HATCH ENDS (INCLUDING  
CROSS BUNKER) CARRIED UP TO SHELTER DECK.

FRAMES CUT AND BRACKETED  
KNEES 27' x 36' 7-8 RIVETS

FRAMES CUT AND BRACKETED  
KNEES 27' x 36' 7-8 RIVETS

NOTE: THIS DECK NOT REQUIRED BY RULES

24/21  
570

122















