


Messrs Richardson Buckle & Co
No 651.

Mid: See:

as built ✓

Empire Conveyor
Sp. Farnworth^{ed}

Mdb report No. 9461.

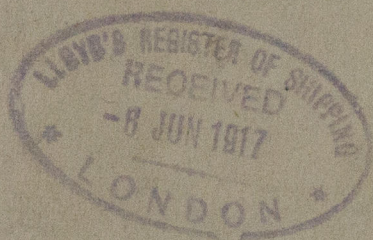

Gloria

RETAIN

W387-0262 © 2019



Lloyd's Register
Foundation

A circular purple ink stamp from Lloyd's Register of Shipping, Middlesbrough. The text "LLOYD'S REGISTER OF SHIPPING" is around the top inner edge, and "MIDDLESBROUGH" is in the center. The date "5.6.17" is handwritten in the center. There is a signature "R. J. B." written over the date.

Nº 6 51

Lloyd's Register
Foundation