

Messrs Richardson Buck

No 651

Modification form of
connection of frame to
tank side brackets



Empire & Co. of
S/S. Farnworth.

Mat. report No. 9461



£. 10

RETAIN

W387- 0264



© 2019

Lloyd's Register
Foundation


 13.5.16
 CONDO

SECTION THREE
 A.A.



SKETCH OF MIDSHIP
 CORNER FLOOR.

SCALE. $\frac{1}{2}$ " = 1 FOOT.

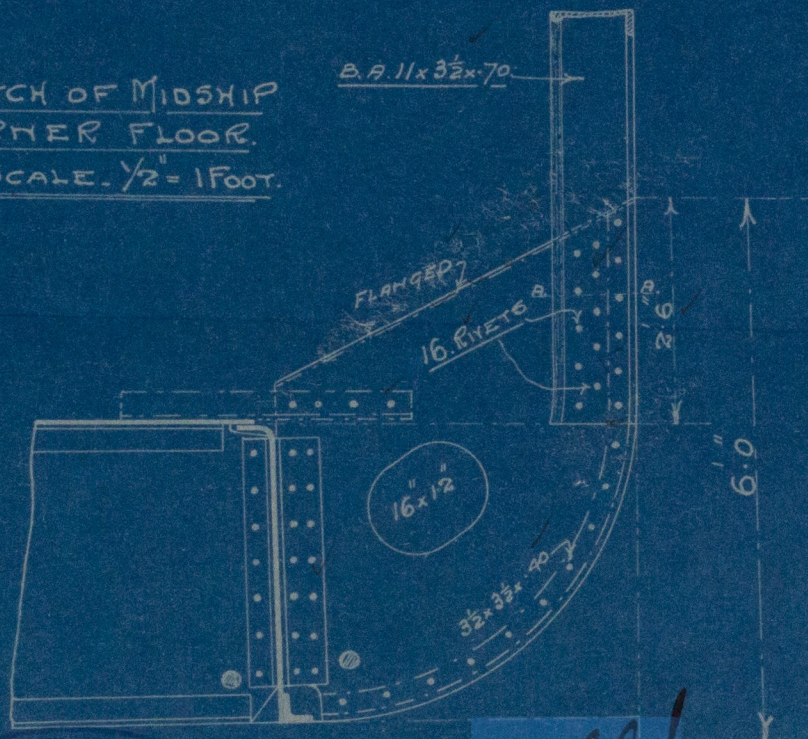

Handwritten signature
 2.5.16

MAY 1/1916
 SHIPBUILDERS
 STOCK

TRACING NO 4834

Handwritten signature
 3.5.16

No 651.

W 387 - 0264