


CARGO STEAMER B.N° 375

SCALE 1:200

PRINCIPAL DIMENSIONS

LENGTH BETW. P.P. 375'-0"
BREADTH 52'-0"
DEPTH TO UPPERDECK 33'-0"
" " 2ND DECK 25'-0"

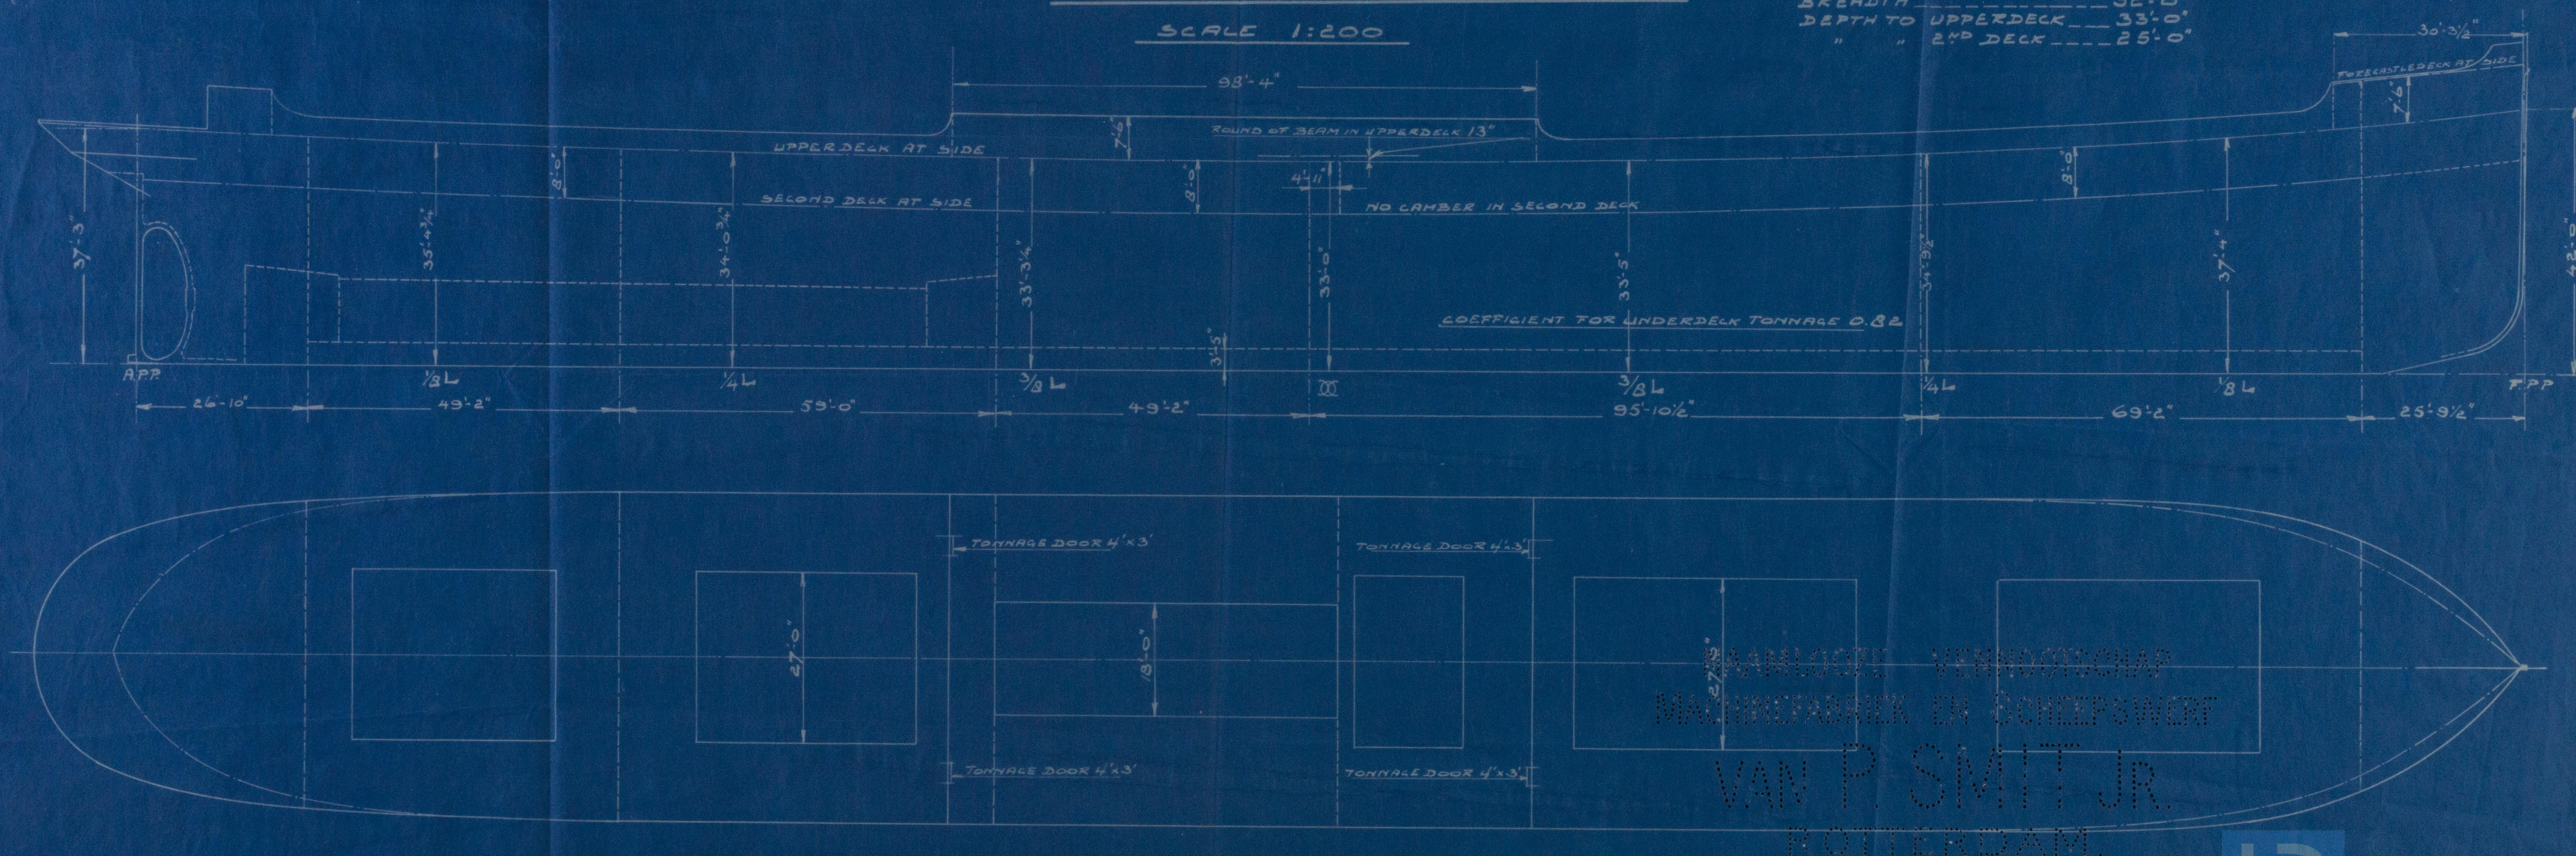

MAAMLOOZE VENNOOTSCHAP
MACHINEFABRIEK EN SCHEEPSWERT
VAN P. SMIT JR.
ROTTERDAM.



TEEK. 93 VAK 435.

W 387-0368

375

P. Smit. Jr.
Amended design received
with Rotterdam letter 8.1.25.
(Freeboard Computation 10/1/25).

RETAIN

W387-0368



© 2019

Lloyd's Register
Foundation